

[illegible]

KINECT @ GRESHAM

1010 NW 12TH ST
GRESHAM, OR 97030

DRAWN BY
MH

CHECKED BY
EP


DRAWING SET DATE
APRIL 10, 2026

BID ADDENDUM #4

SOUTHEAST CORNER OF SECTION 4,
TOWNSHIP 1 SOUTH, RANGE 3

STRUCTURAL LOADING PLANS

\$0.20

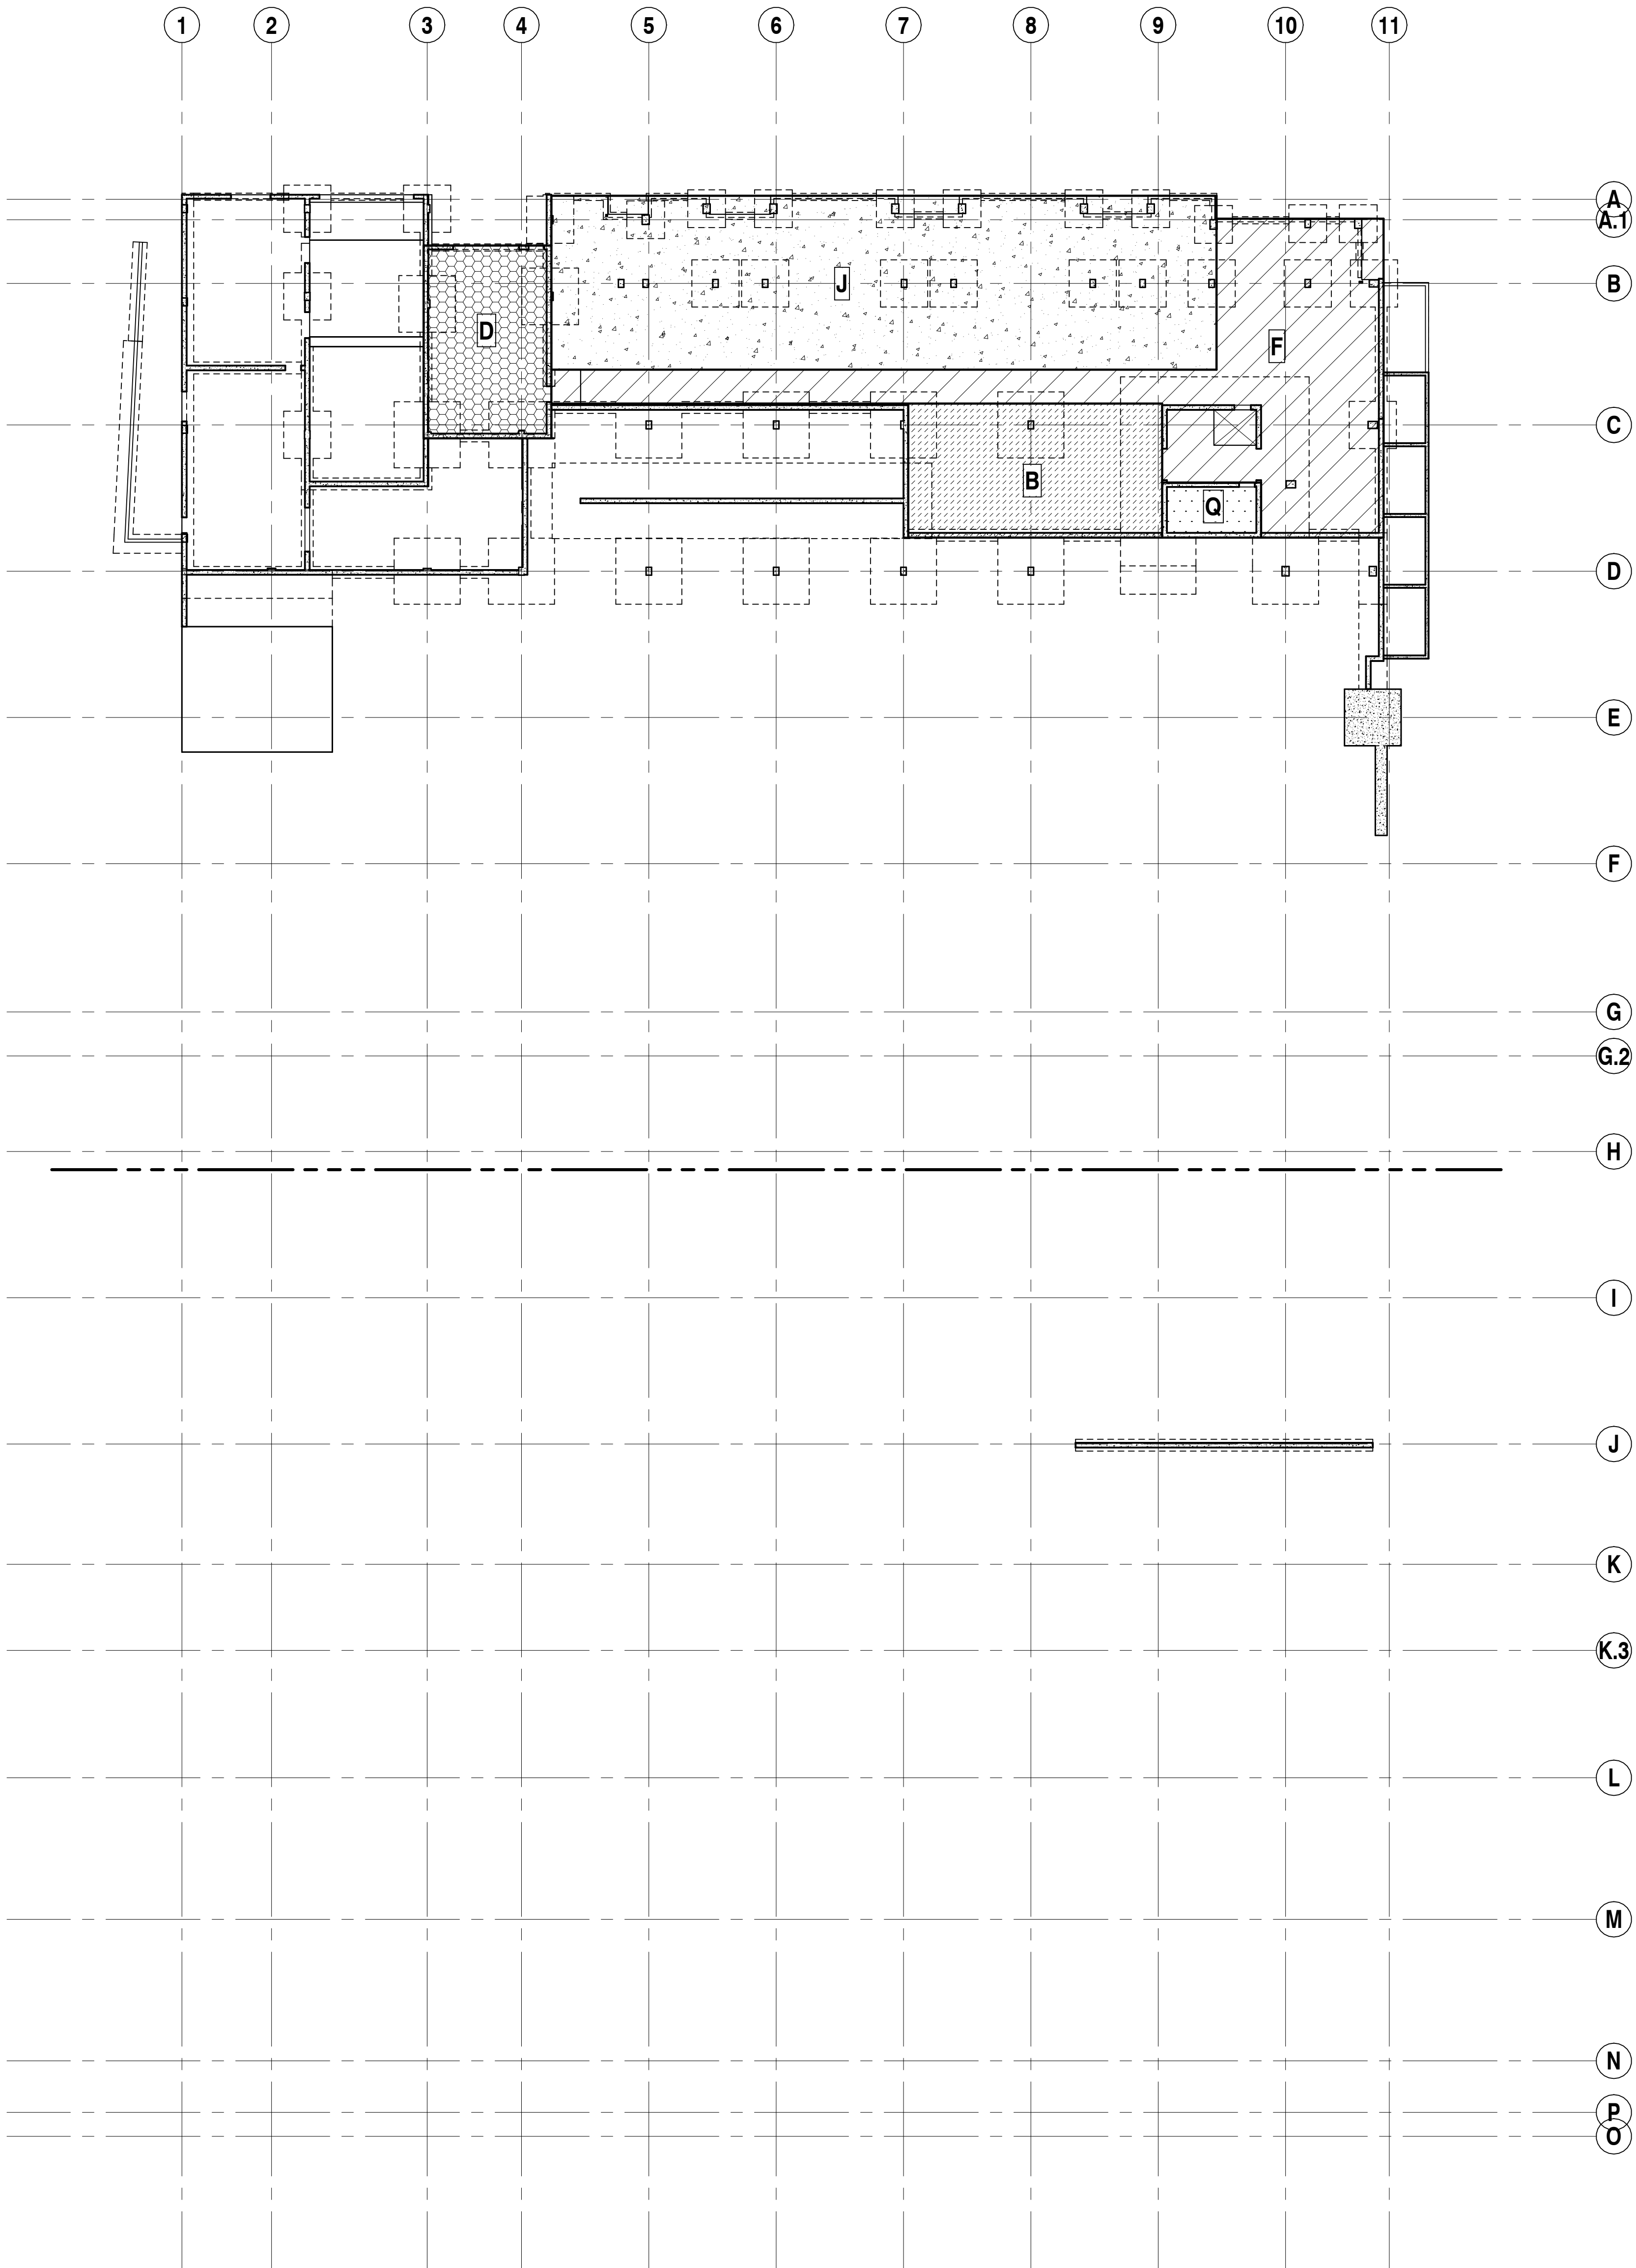


LOAD MAP LEGEND			
DESIGN LOAD LEGEND			
MARK / PATTERN	AREA	ADDED DEAD LOAD	LIVE LOAD
A 	PARKING	5 PSF	40 PSF
B 	MECHANICAL	40 PSF	40 PSF
C 	STORAGE	10 PSF	125 PSF
D 	TRASH ROOM	10 PSF	100 PSF
E 	GENERATOR/ TRANSFORMER	150 PSF	20 PSF
F 	RETAIL/ FITNESS/LOBBY	15 PSF	100 PSF
G 	LEVEL 3 AND 4 LANDSCAPE	150 PSF	100 PSF
H 	DETENTION VAULT	250 PSF	40 PSF
J 	RESIDENTIAL	CONC = 10 PSF WOOD = 23 PSF	40 PSF
K 	TERRACE	30 PSF	40 PSF
L 	ROOF	17 PSF	25 PSF
M 	ROOF MECHANICAL	35 PSF	25 PSF
Q 	STAIRS/ CORRIDOR	15 PSF (STAIRS)	100 PSF

LEVEL 1A LOADING PLAN

SCALE: 1" = 20'-0"




ALL RIGHTS RESERVED. REPRODUCTION OR TRANSLATION OF ANY PART OF THIS WORK WITHOUT WRITTEN PERMISSION OF AMERICAN CAPITAL GROUP IS UNLAWFUL AND SUBJECT TO CRIMINAL PROSECUTION.

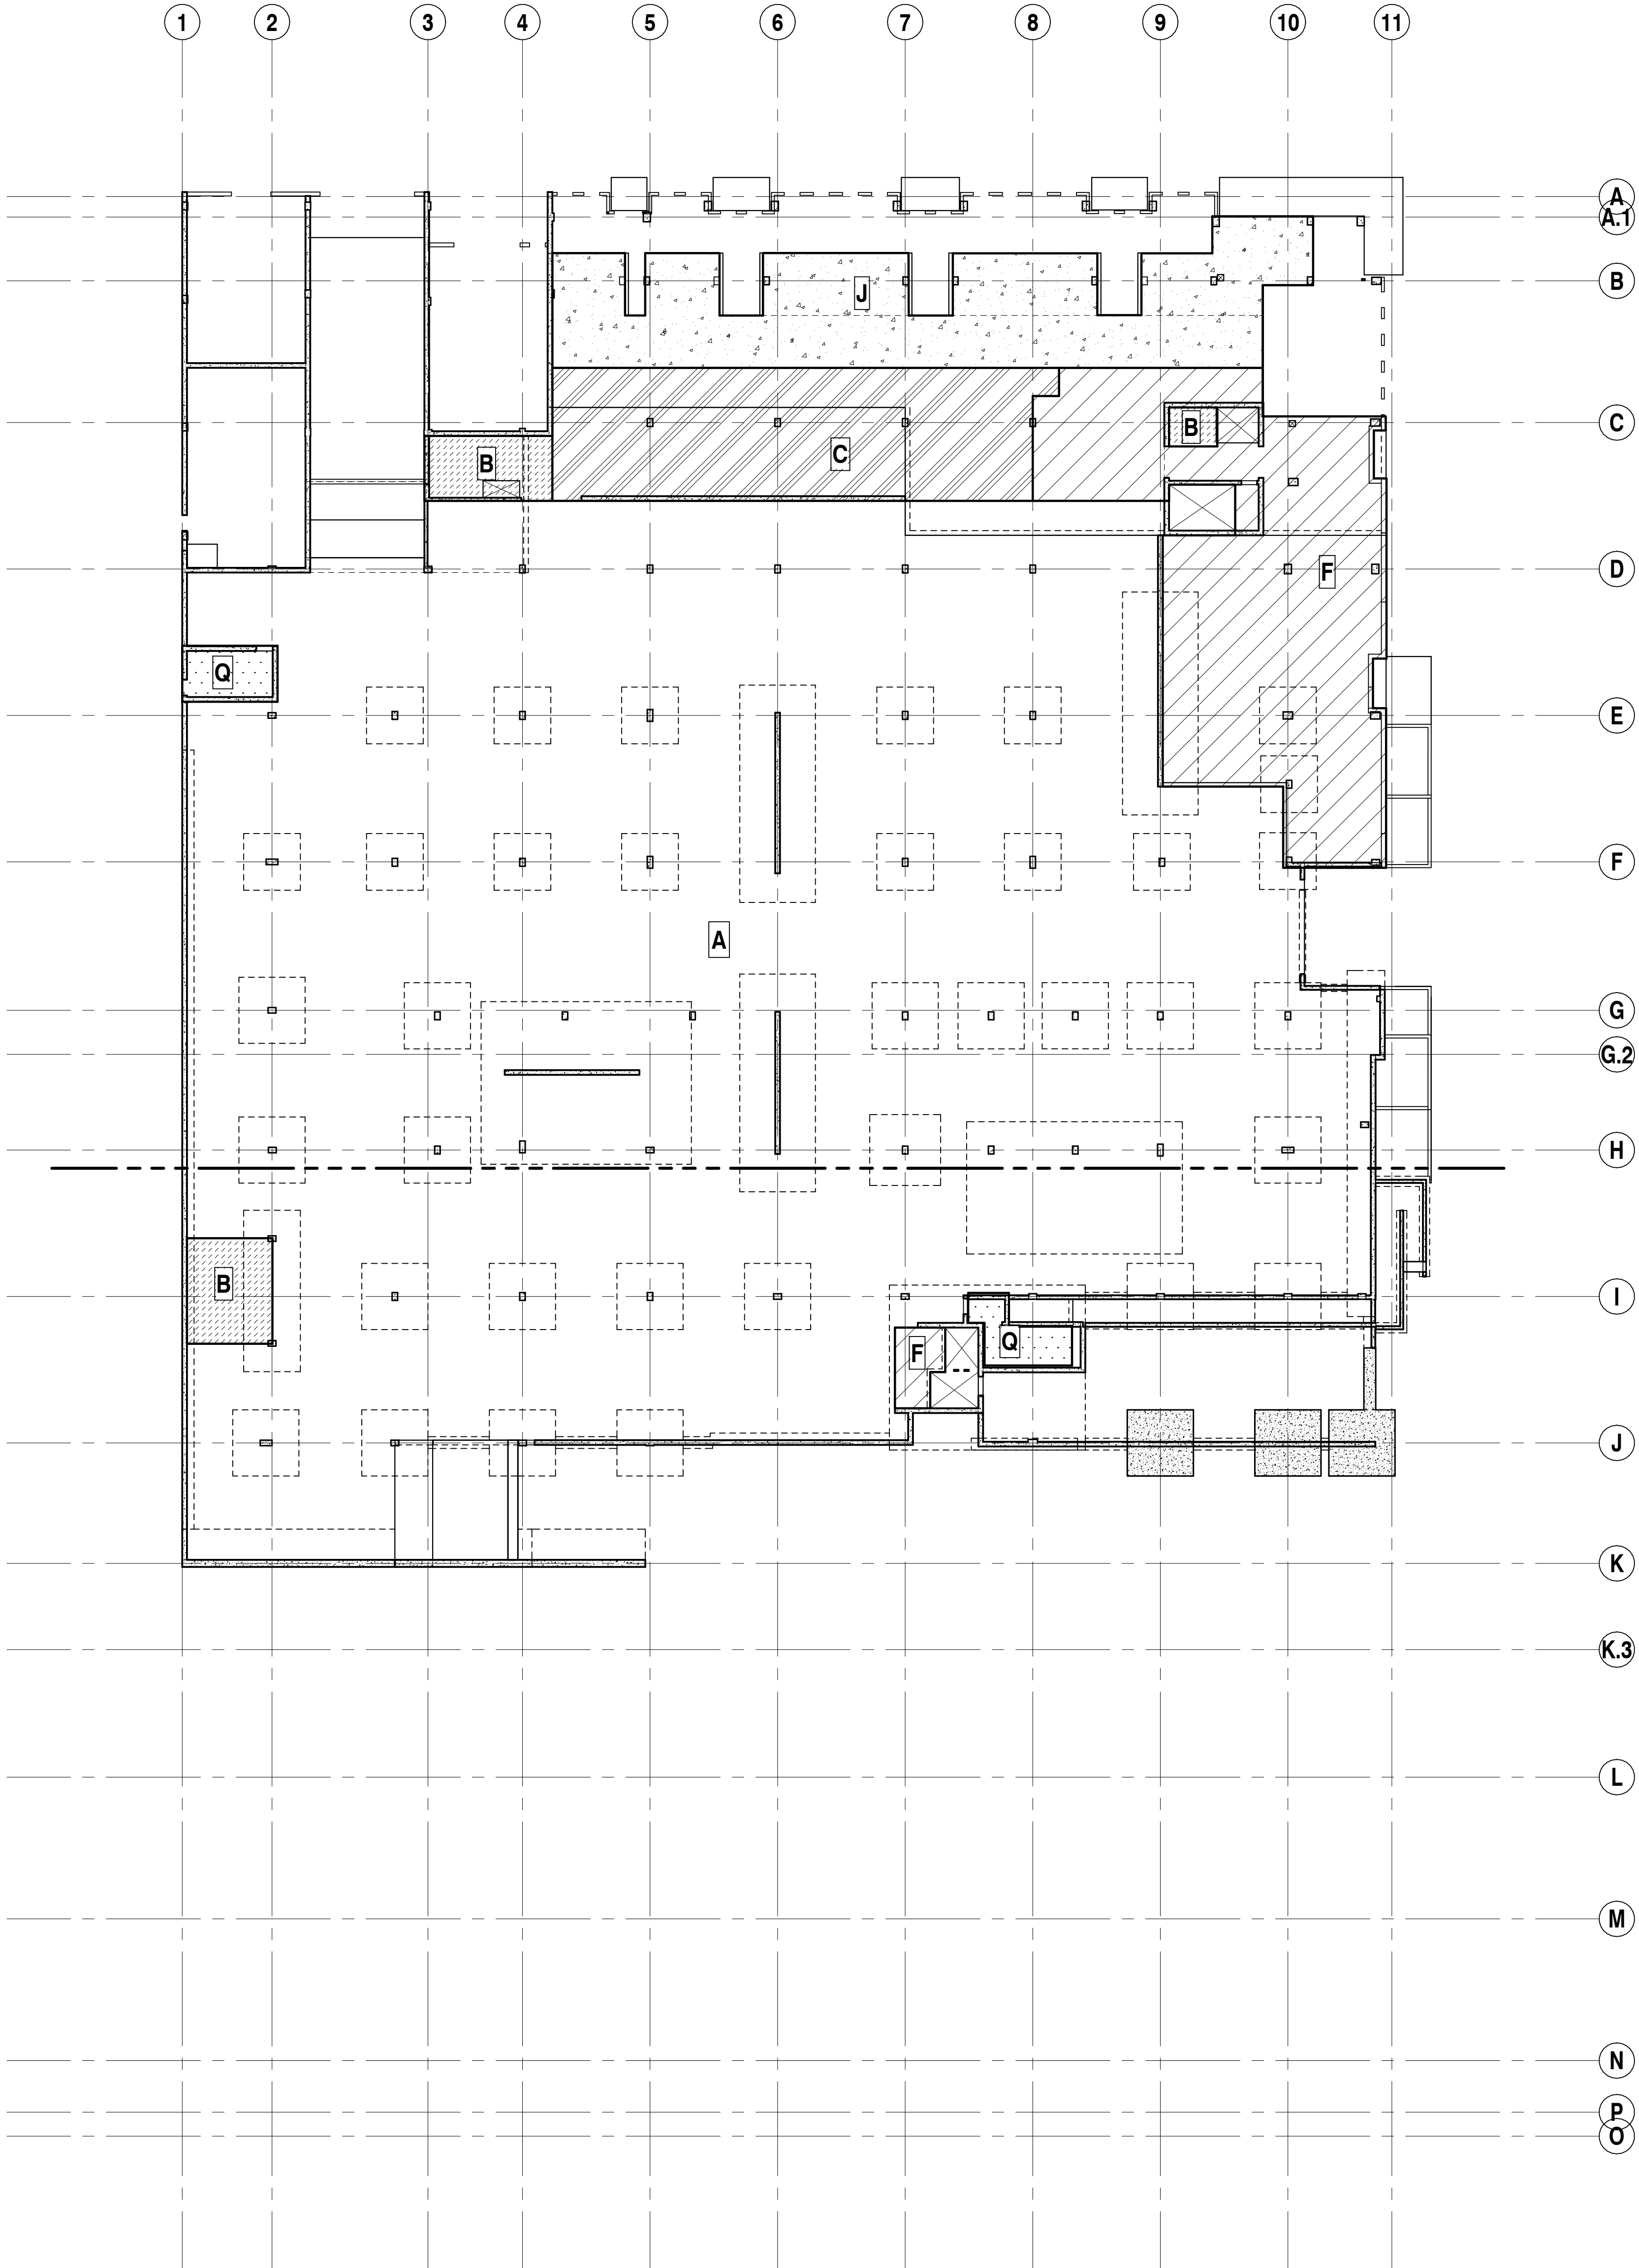

01601 LOAD MAP LEGEND			
DESIGN LOAD LEGEND			
MARK / PATTERN	AREA	ADDED DEAD LOAD	LIVE LOAD
A	PARKING	5 PSF	40 PSF
B	MECHANICAL	40 PSF	40 PSF
C	STORAGE	10 PSF	125 PSF
D	TRASH ROOM	10 PSF	100 PSF
E	GENERATOR/ TRANSFORMER	150 PSF	20 PSF
F	RETAIL/ FITNESS/LOBBY	15 PSF	100 PSF
G	LEVEL 3 AND 4 LANDSCAPE	150 PSF	100 PSF
H	DETENTION VAULT	250 PSF	40 PSF
J	RESIDENTIAL	CONC = 10 PSF WOOD = 23 PSF	40 PSF
K	TERRACE	30 PSF	40 PSF
L	ROOF	17 PSF	25 PSF
M	ROOF MECHANICAL	35 PSF	25 PSF
Q	STAIRS/ CORRIDOR	15 PSF (STAIRS)	100 PSF

LEVEL 1B LOADING PLAN

SCALE: 1" = 20'-0"

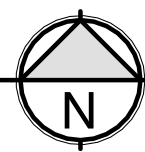

SUBMITTAL - REVISIONS		
NO.	DATE	DESCRIPTION
A1	1/16/2024	ADDENDUM #1
B1	5/26/2024	COMMENTS
A2	5/26/2024	ADDENDUM #2
A4	5/26/2024	PERMIT RE-SUBMITTAL #3

[illegible]

KINECT @ GRESHAM

1010 NW 12TH ST
GRESHAM, OR 97030

DRAWN BY
 MH

CHECKED BY
 EP


DRAWING SET DATE
APRIL 10, 2026

BID ADDENDUM #4

SOUTHEAST CORNER OF SECTION 4,
TOWNSHIP 1 SOUTH, RANGE 3

STRUCTURAL LOADING PLANS

S0.22

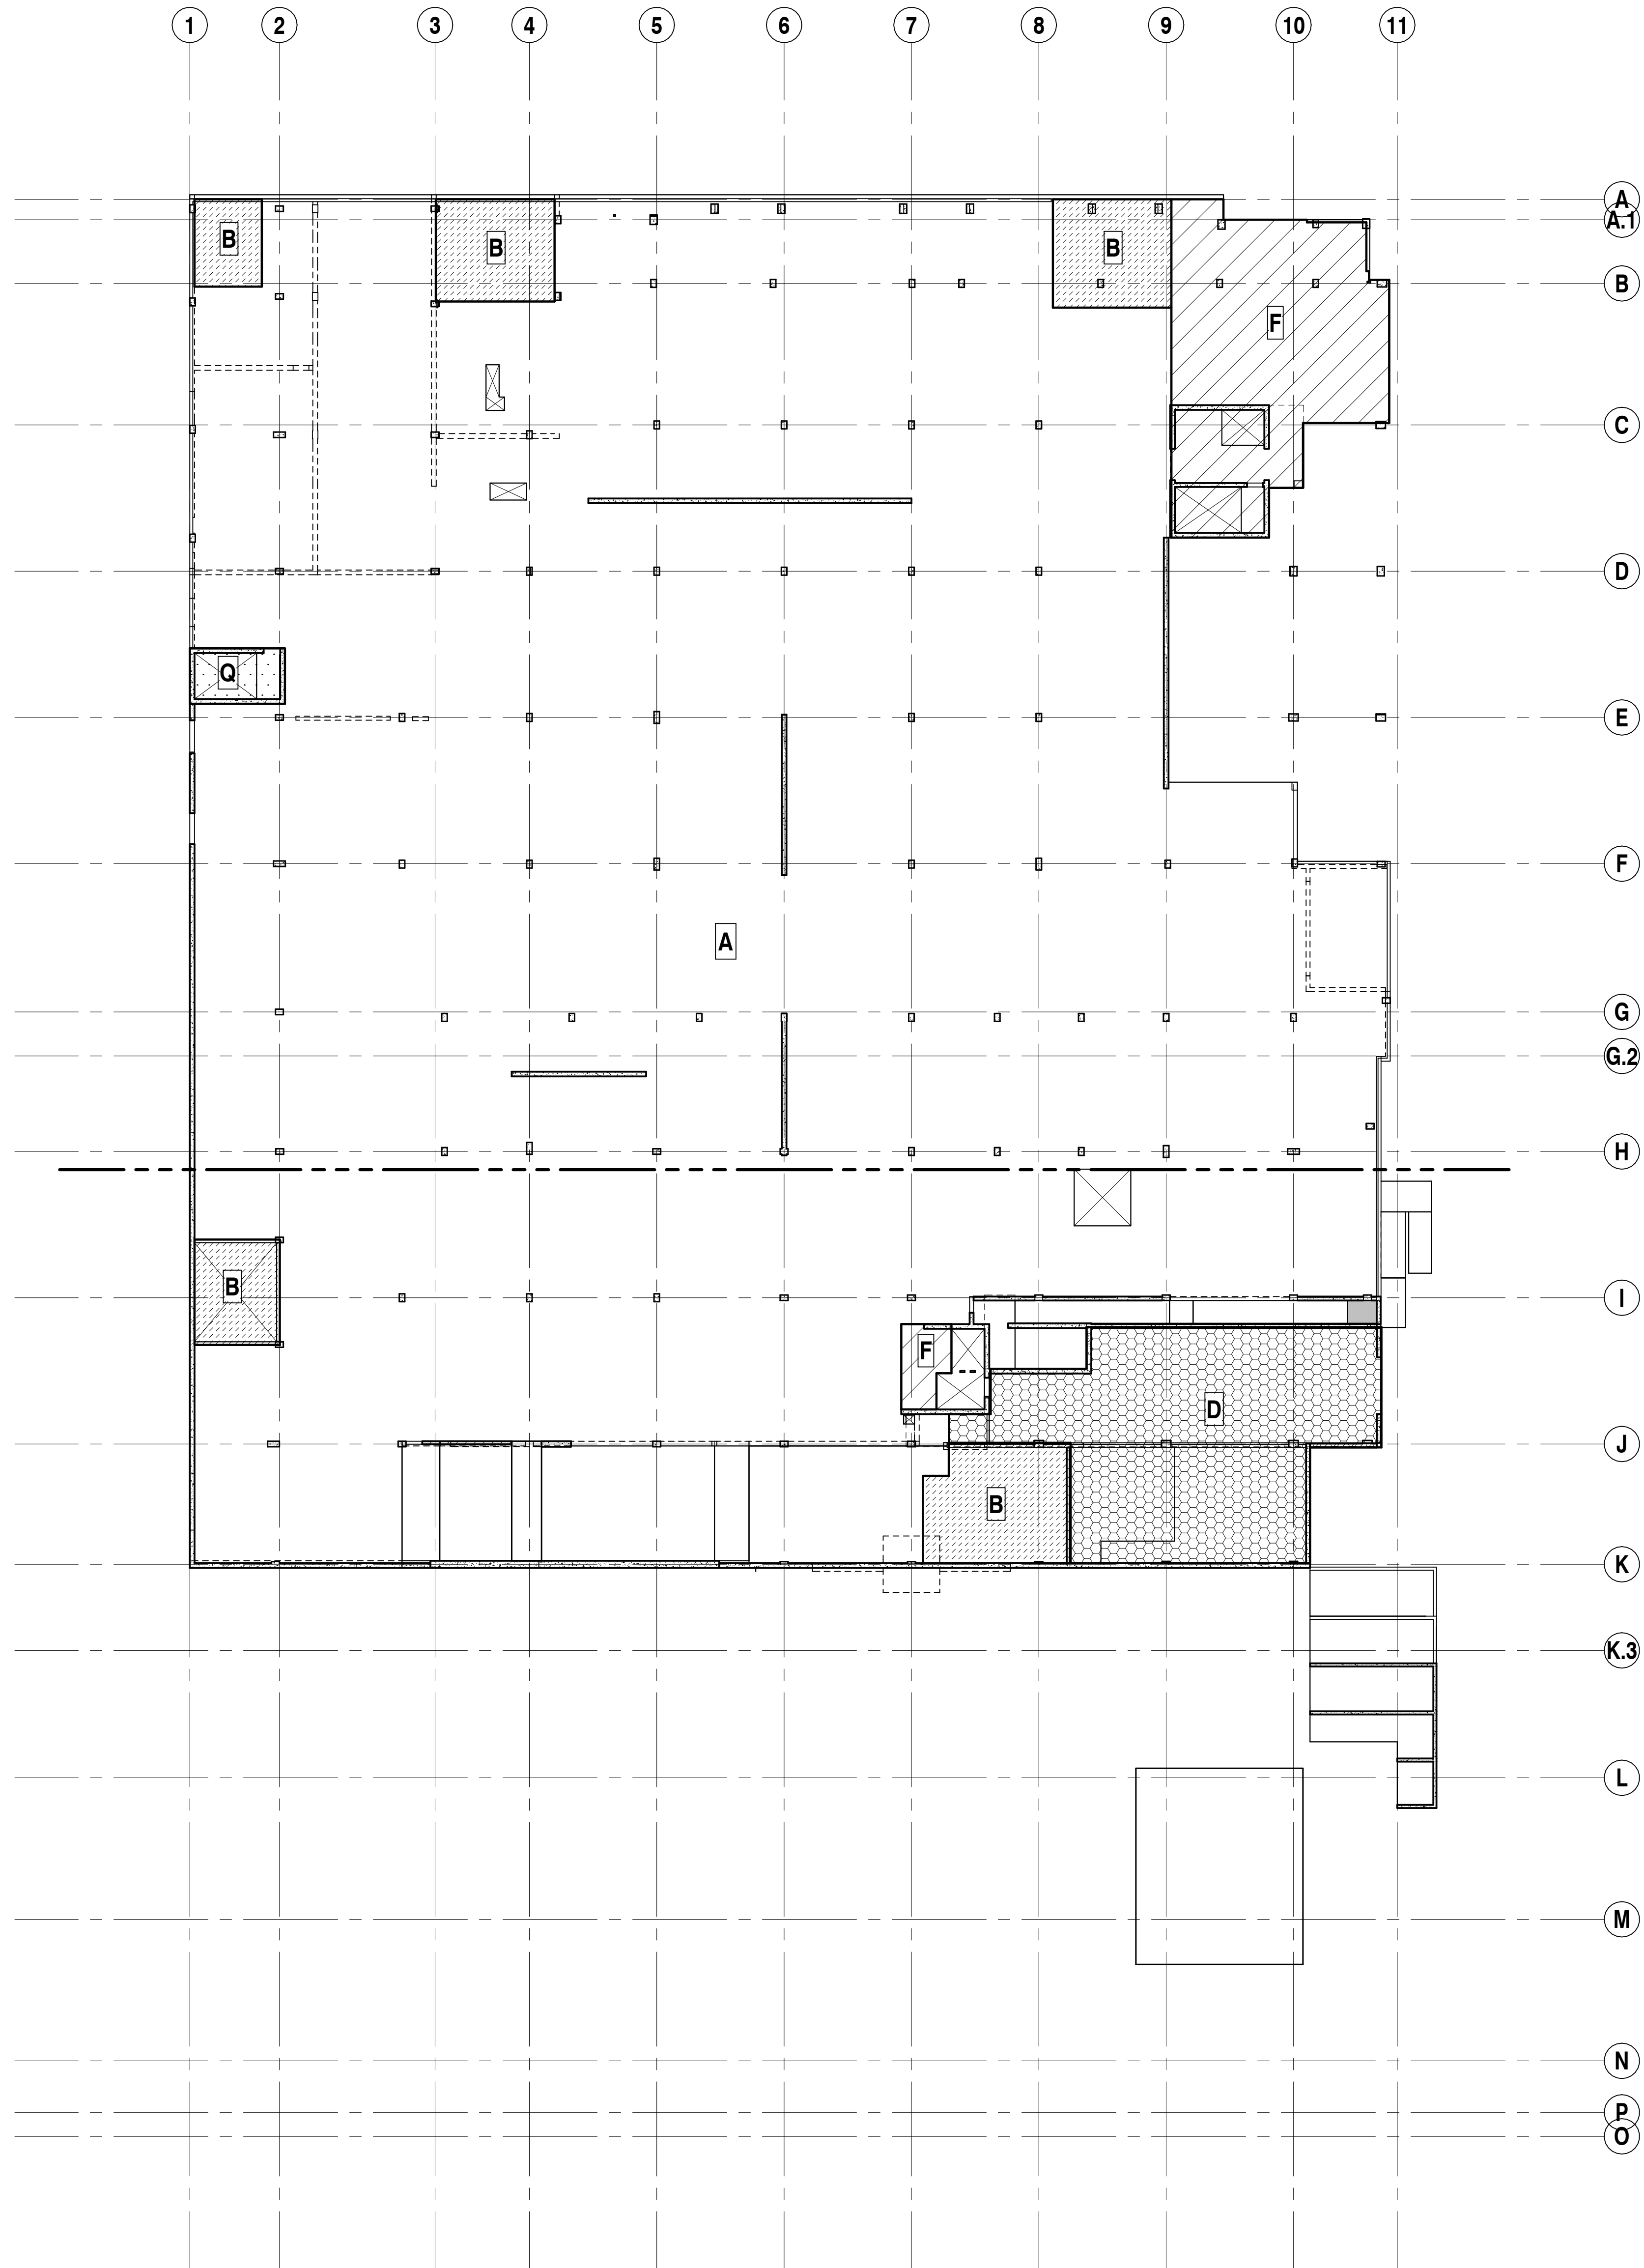


LOAD MAP LEGEND			
DESIGN LOAD LEGEND			
MARK / PATTERN	AREA	ADDED DEAD LOAD	LIVE LOAD
A 	PARKING	5 PSF	40 PSF
B 	MECHANICAL	40 PSF	40 PSF
C 	STORAGE	10 PSF	125 PSF
D 	TRASH ROOM	10 PSF	100 PSF
E 	GENERATOR/ TRANSFORMER	150 PSF	20 PSF
F 	RETAIL/ FITNESS/LOBBY	15 PSF	100 PSF
G 	LEVEL 3 AND 4 LANDSCAPE	150 PSF	100 PSF
H 	DETENTION VAULT	250 PSF	40 PSF
J 	RESIDENTIAL	CONC = 10 PSF WOOD = 23 PSF	40 PSF
K 	TERRACE	30 PSF	40 PSF
L 	ROOF	17 PSF	25 PSF
M 	ROOF MECHANICAL	35 PSF	25 PSF
Q 	STAIRS/ CORRIDOR	15 PSF (STAIRS)	100 PSF

LEVEL 2 LOADING PLAN

SCALE: 1" = 20'-0"




ALL RIGHTS RESERVED. REPRODUCTION OR TRANSLATION OF ANY PART OF THIS WORK WITHOUT WRITTEN PERMISSION OF AMERICAN CAPITAL GROUP IS UNLAWFUL AND SUBJECT TO CRIMINAL PROSECUTION.

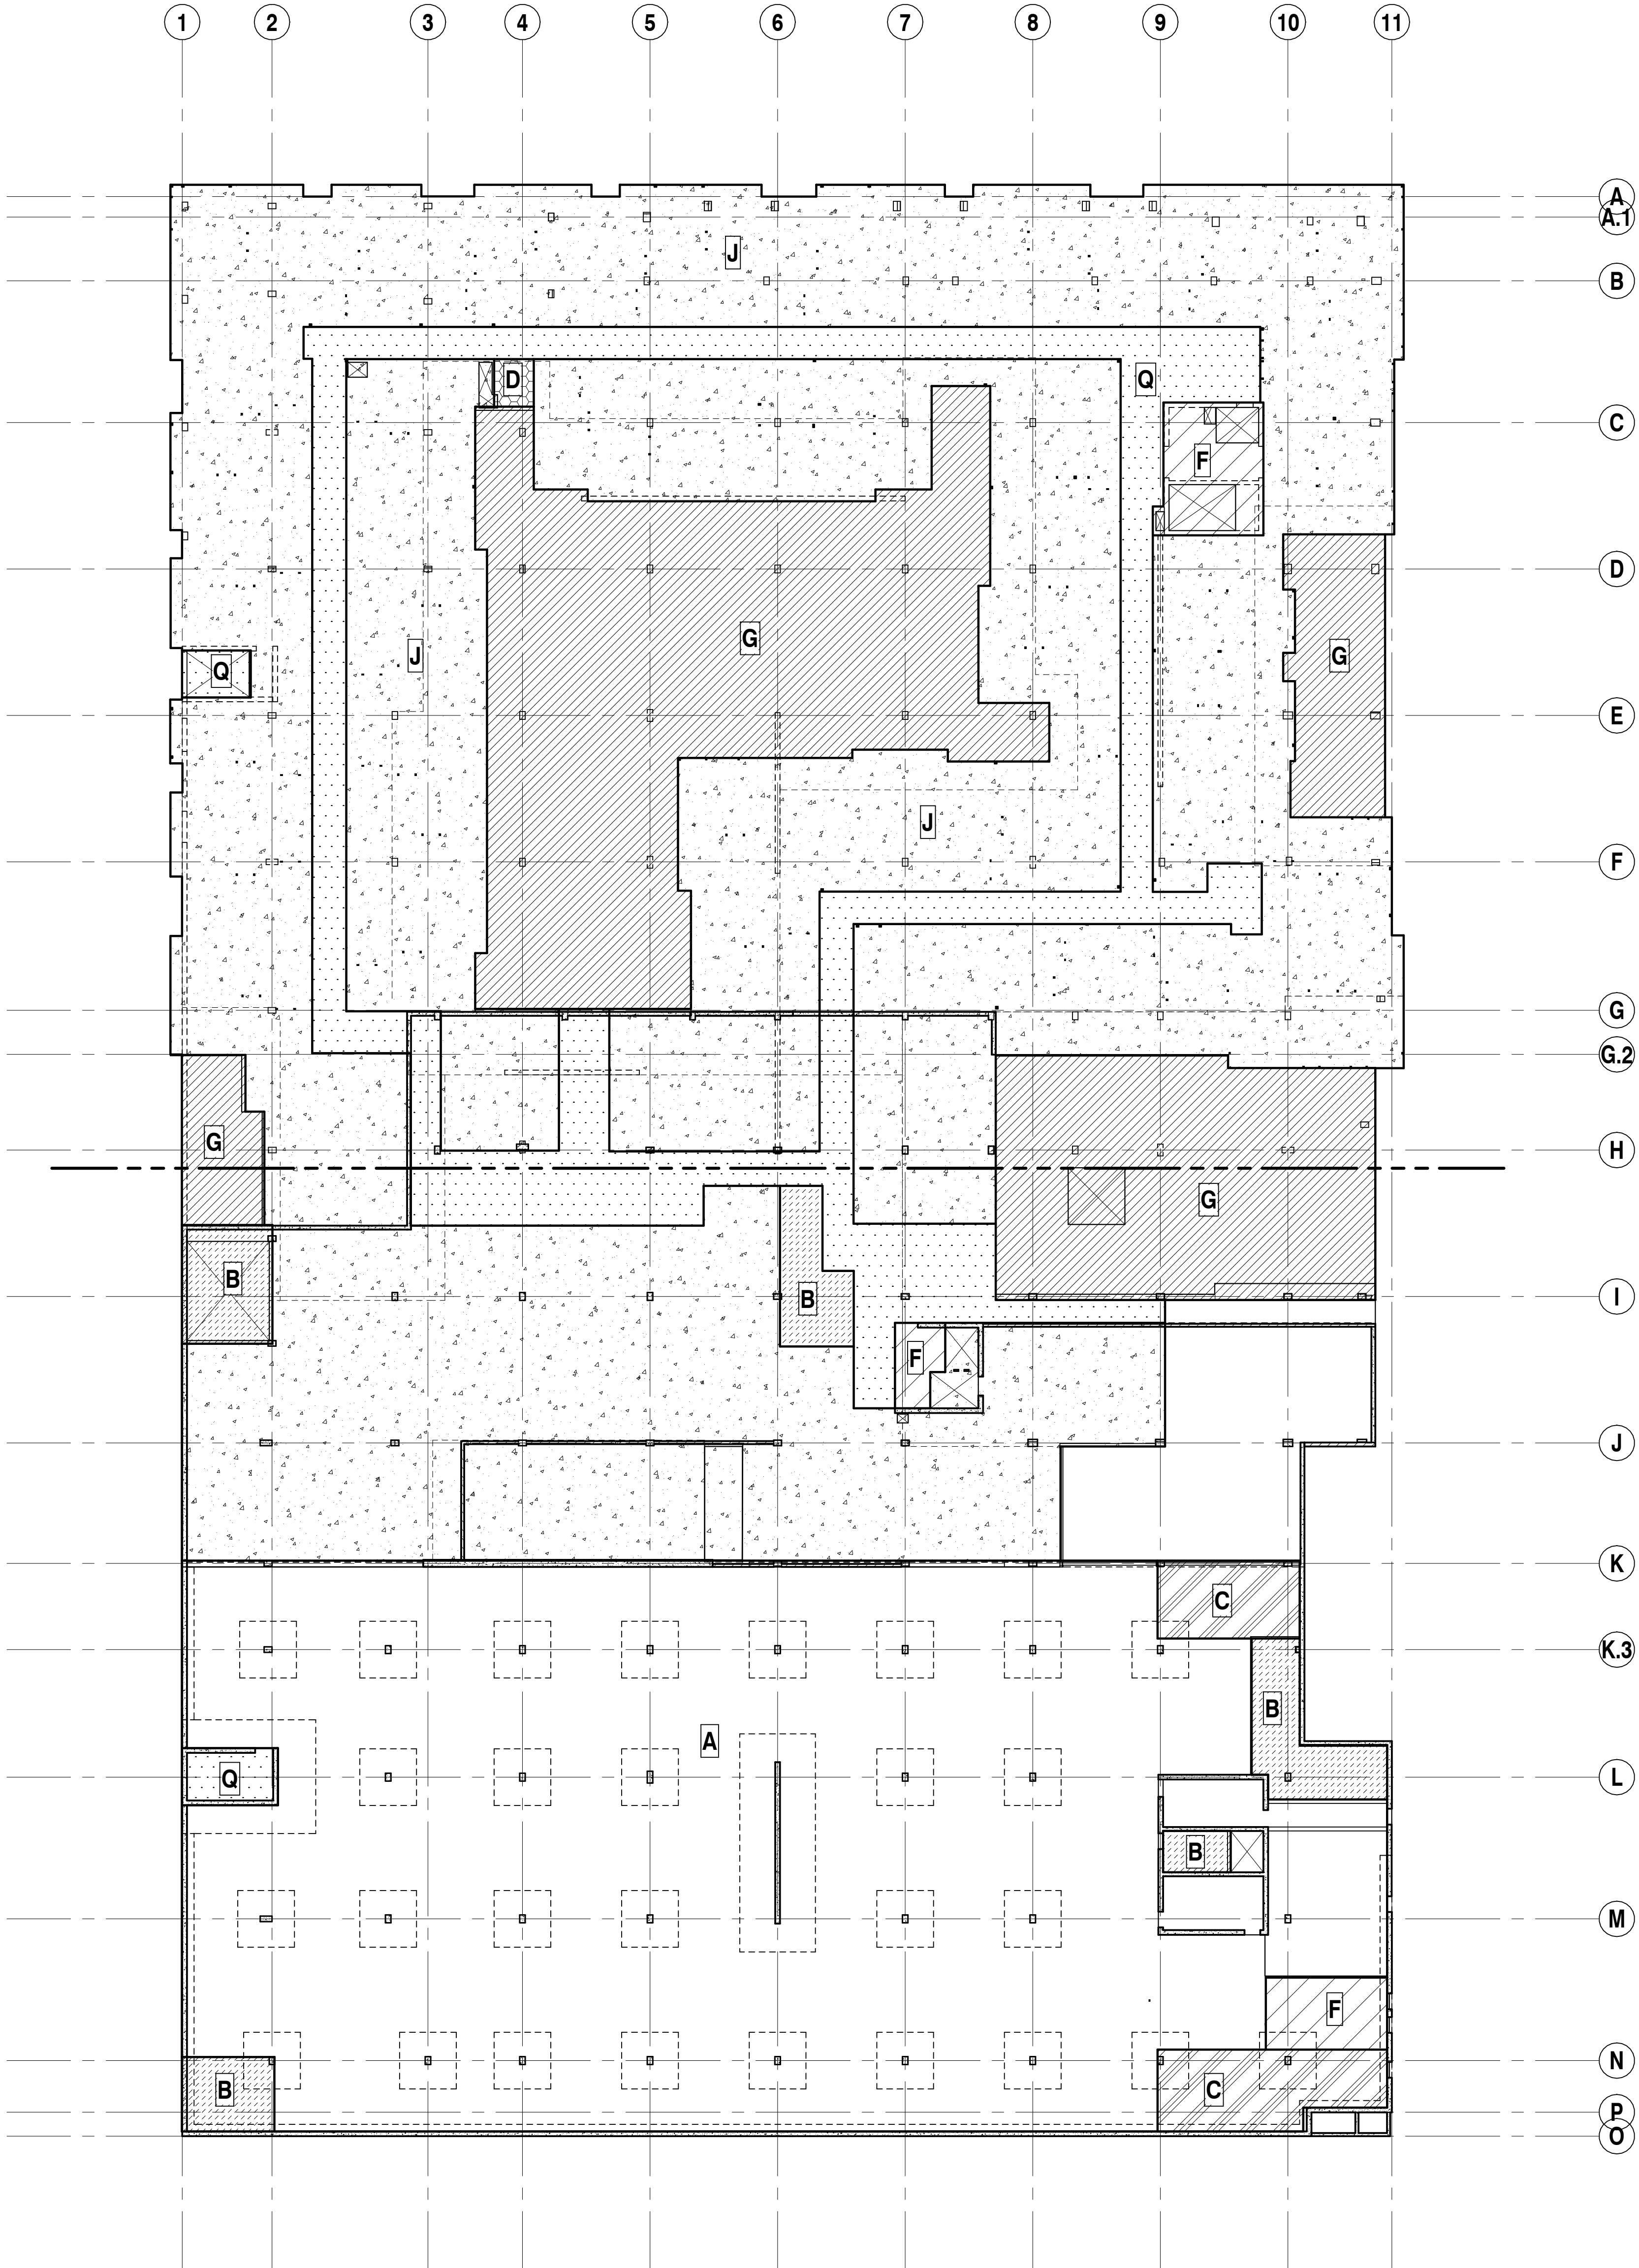

01601 LOAD MAP LEGEND			
DESIGN LOAD LEGEND			
MARK / PATTERN	AREA	ADDED DEAD LOAD	LIVE LOAD
A	PARKING	5 PSF	40 PSF
B	MECHANICAL	40 PSF	40 PSF
C	STORAGE	10 PSF	125 PSF
D	TRASH ROOM	10 PSF	100 PSF
E	GENERATOR/ TRANSFORMER	150 PSF	20 PSF
F	RETAIL/ FITNESS/LOBBY	15 PSF	100 PSF
G	LEVEL 3 AND 4 LANDSCAPE	150 PSF	100 PSF
H	DETENTION VAULT	250 PSF	40 PSF
J	RESIDENTIAL	CONC = 10 PSF WOOD = 23 PSF	40 PSF
K	TERRACE	30 PSF	40 PSF
L	ROOF	17 PSF	25 PSF
M	ROOF MECHANICAL	35 PSF	25 PSF
Q	STAIRS/ CORRIDOR	15 PSF (STAIRS)	100 PSF

LEVEL 3 LOADING PLAN

SCALE: 1" = 20'-0"

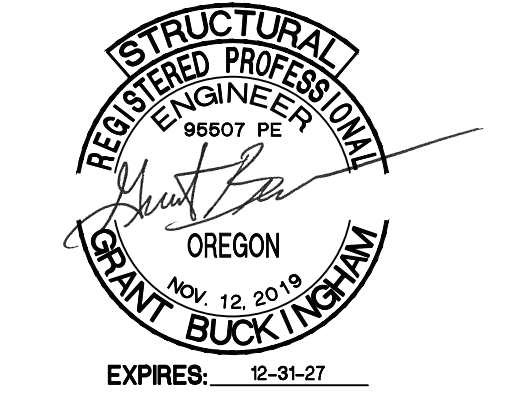

SUBMITTAL - REVISIONS		
NO.	DATE	DESCRIPTION
A1	1/10/2025	REVISION #1
B1	5/26/2025	REVISION #2
A2	6/2/2025	REVISION #3
A3	6/2/2025	REVISION #4
A4	6/2/2025	REVISION #5
A304	6/2/2025	REVISION #305
A305	6/2/2025	REVISION #

[illegible]

KINECT@GRESHAM

1010 NW 12TH ST
GRESHAM, OR 97030

DRAWN BY
 MH

CHECKED BY
 EP

AWING SET DATE
APRIL 10, 2026

BID ADDENDUM #4

TY OF GRESHAM PROJECT # 077531

SOUTHEAST CORNER OF SECTION 4,
TOWNSHIP 1 SOUTH, RANGE 3


FOR PERMIT
The Contractor shall not use these drawings for construction until Contractor has received jurisdiction and O.C.I. Engineers' approval.

TITLE

STRUCTURAL LOADING PLANS

S0.24

FOR PERMIT
The Contractor shall not use these drawings
without the approval of the DCI Engineers.

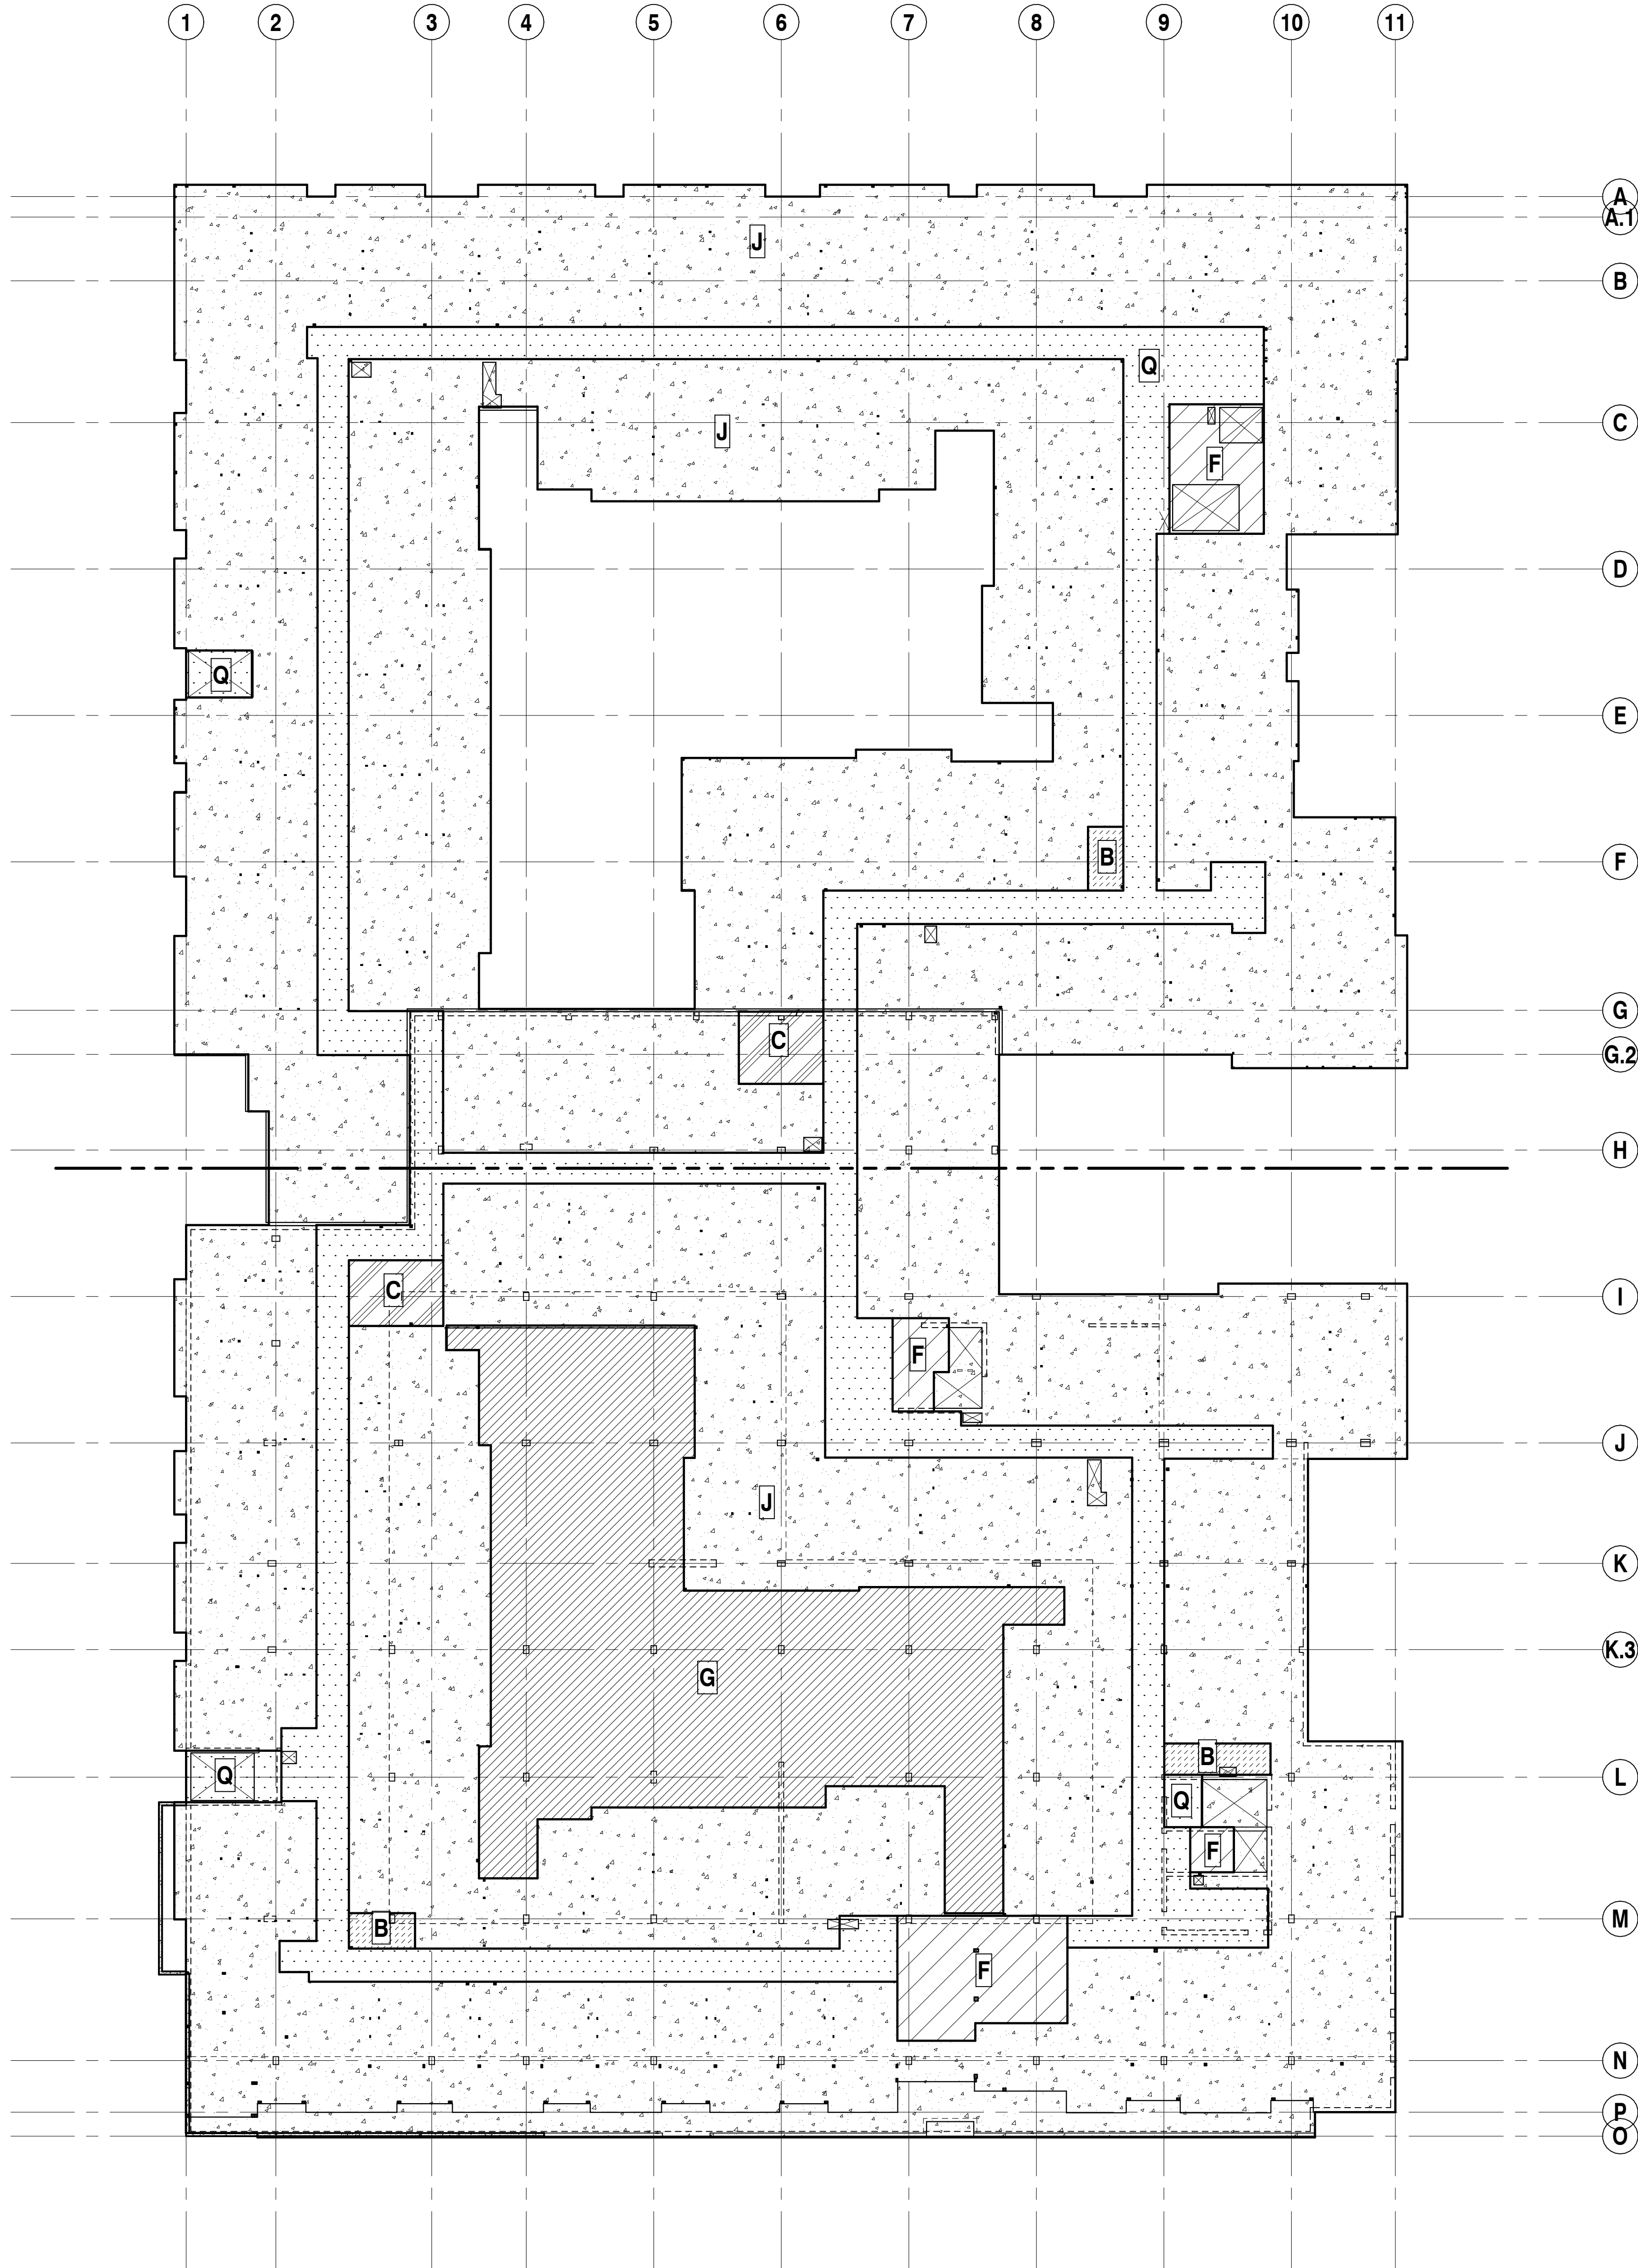





LOAD MAP LEGEND			
DESIGN LOAD LEGEND			
MARK / PATTERN	AREA	ADDED DEAD LOAD	LIVE LOAD
A 	PARKING	5 PSF	40 PSF
B 	MECHANICAL	40 PSF	40 PSF
C 	STORAGE	10 PSF	125 PSF
D 	TRASH ROOM	10 PSF	100 PSF
E 	GENERATOR/ TRANSFORMER	150 PSF	20 PSF
F 	RETAIL/ FITNESS/LOBBY	15 PSF	100 PSF
G 	LEVEL 3 AND 4 LANDSCAPE	150 PSF	100 PSF
H 	DETENTION VAULT	250 PSF	40 PSF
J 	RESIDENTIAL	CONC = 10 PSF WOOD = 23 PSF	40 PSF
K 	TERRACE	30 PSF	40 PSF
L 	ROOF	17 PSF	25 PSF
M 	ROOF MECHANICAL	35 PSF	25 PSF
Q 	STAIRS/ CORRIDOR	15 PSF (STAIRS)	100 PSF

LEVEL 4 LOADING PLAN


SCALE: 1" = 20'-0"



THIS DRAWING IS FOR THE EXCLUSIVE USE OF MCCLONE CONSTRUCTION COMPANY. ON THE PROJECT ONLY. UTILIZATION OF THIS DRAWING BY OTHER PARTIES WITHOUT THE EXPRESSED WRITTEN CONSENT OF MCCLONE CONSTRUCTION COMPANY IS STRICTLY PROHIBITED.

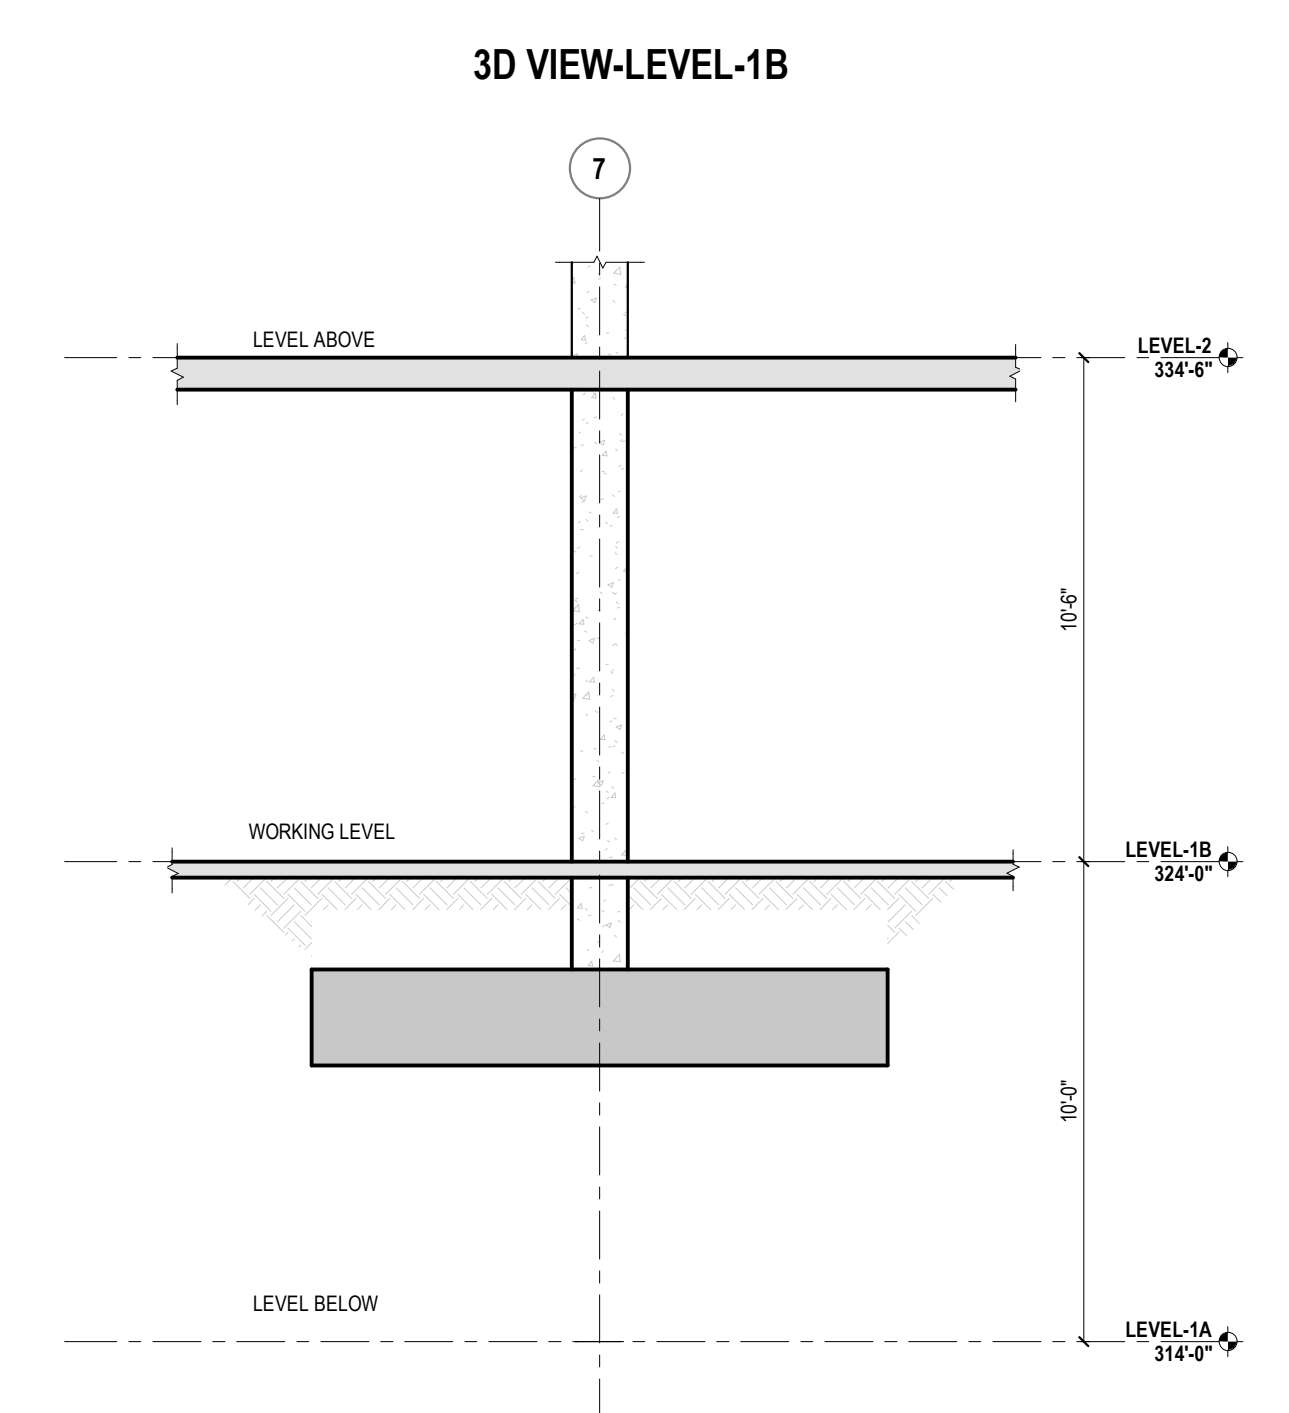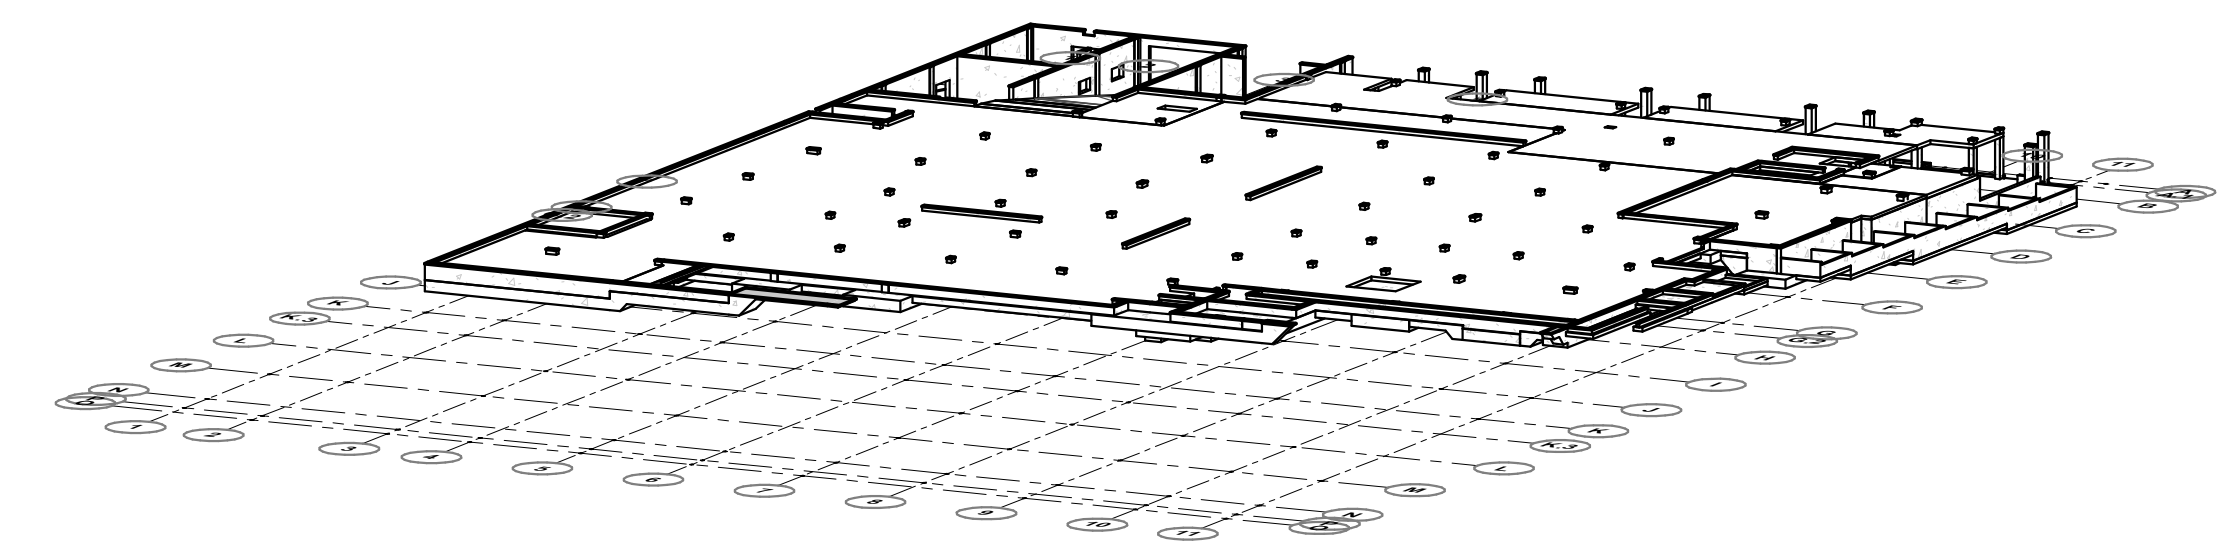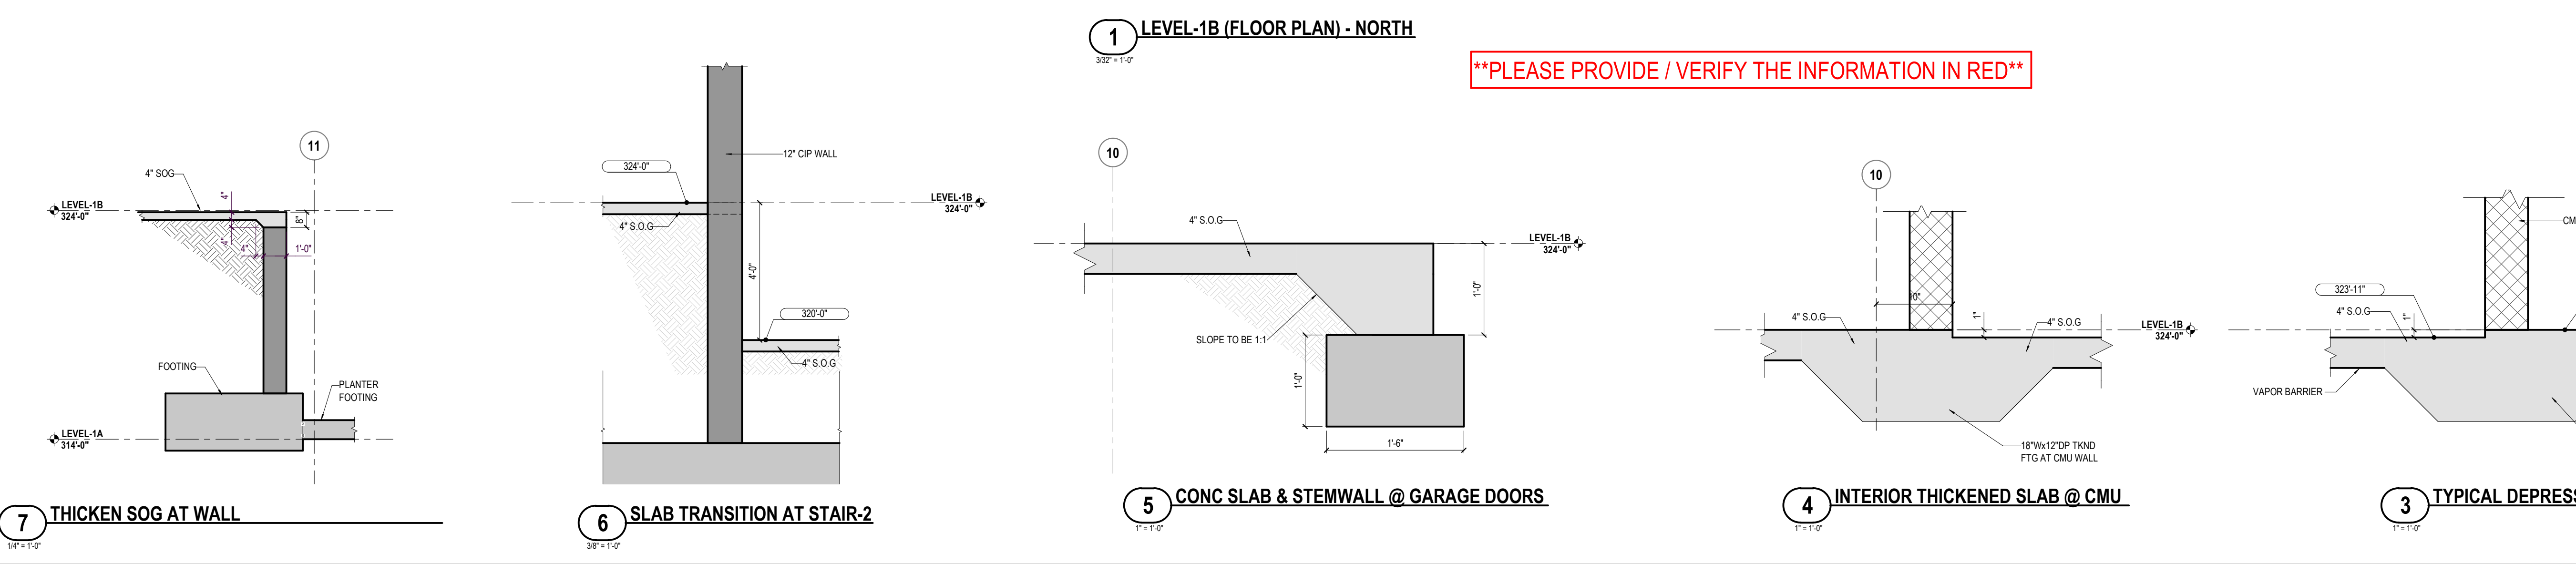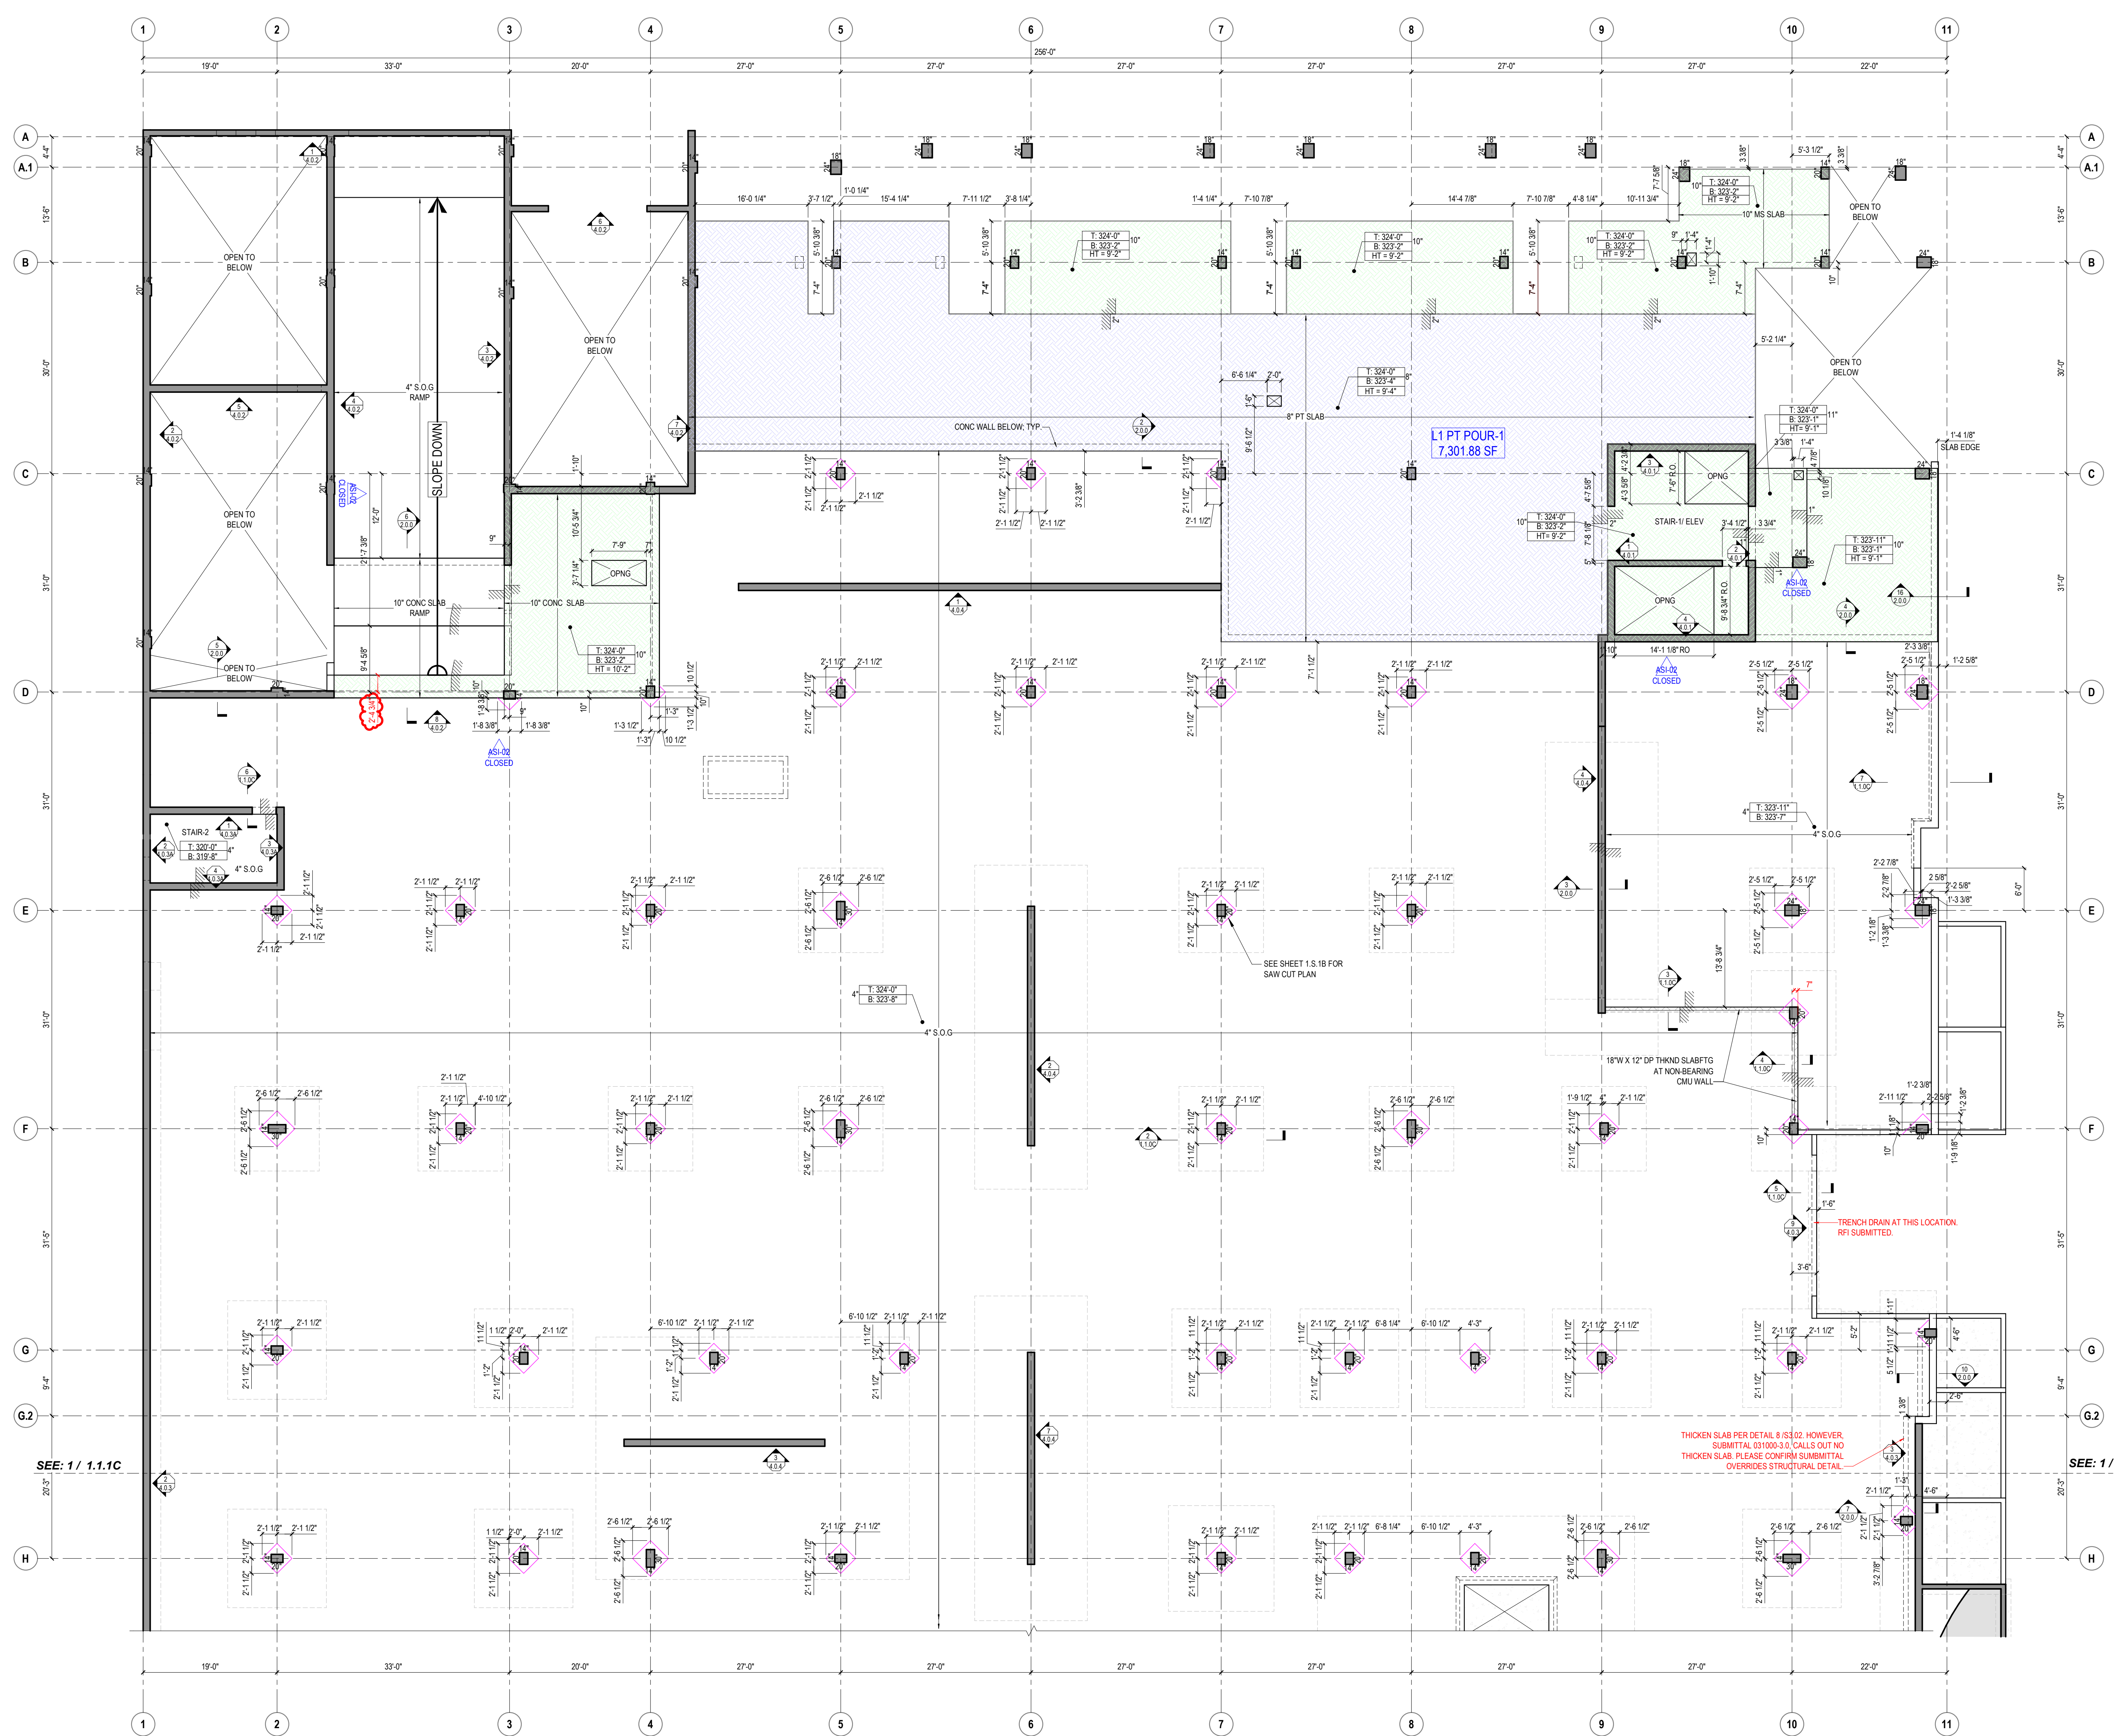

2 BUILDING SECTION LEVEL-1B

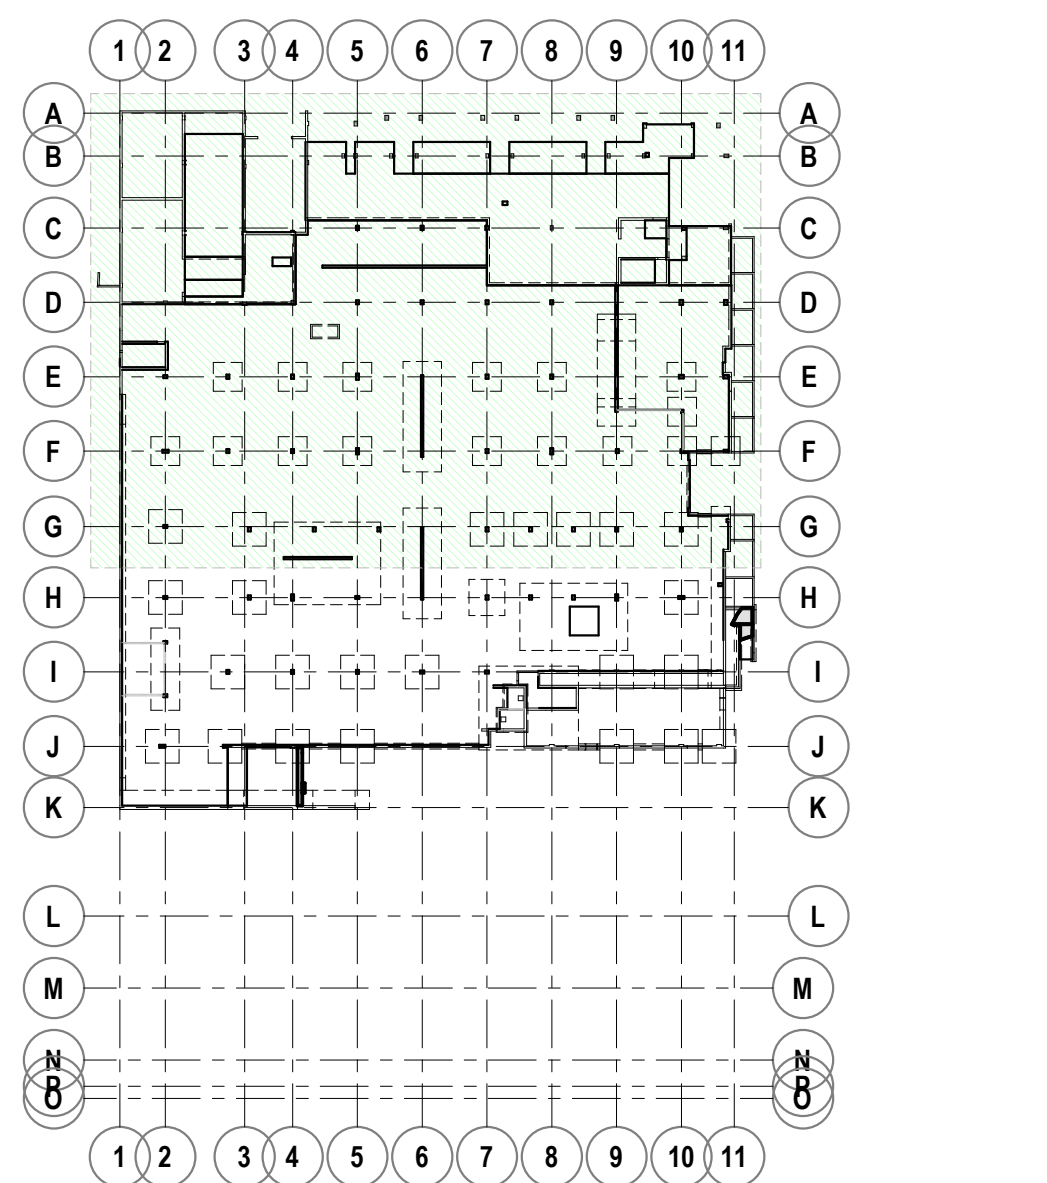

LEVEL-1B KEYPLAN NORTH


NOTES:

1. 3/4" CHAMFER ON ALL EXPOSED CONCRETE CORNERS TYP.
2. ALL COLUMNS ARE CENTERED ON GRID LINES UNO.
3. ALL BEAMS ARE CENTERED ON GRID LINES UNO.
4. SLAB ON GRADE THICKNESS IS 4" TYP. UNO.
5. LEVEL 1B ELEVATION = 324'-0"

LEGEND


SYMBOLS	SHADE DESIGNATIONS
FOOTING OR FOUNDATIONS	TOP OF CONCRETE ELEVATIONS
TOP OF CONCRETE ELEVATIONS	WALLS OR COLUMNS
1-BOX	CMU WALLS
BOTTOM OF CONCRETE ELEVATIONS	DELAY STRIP OR CLOSURE POUR
2-BOX (PLAN VIEWS)	GRADE OR SOIL
TOP & BOTTOM ELEVATIONS	
3-BOX (FLOOR PLANS)	
TOP & BOTTOM ELEVATIONS	
COLUMN ELEVATION ABOVE REF. LEVEL	
4-BOX (FLOOR PLANS)	
TOP & BOTTOM ELEVATIONS	
COLUMN ELEVATION ABOVE REF. LEVEL	
5-BOX (FLOOR PLANS)	
TOP & BOTTOM ELEVATIONS	
COLUMN ELEVATION ABOVE REF. LEVEL	
6-BOX (FLOOR PLANS)	
TOP & BOTTOM ELEVATIONS	
COLUMN ELEVATION ABOVE REF. LEVEL	
7-BOX (FLOOR PLANS)	
TOP & BOTTOM ELEVATIONS	
COLUMN ELEVATION ABOVE REF. LEVEL	
8-BOX (FLOOR PLANS)	
TOP & BOTTOM ELEVATIONS	
COLUMN ELEVATION ABOVE REF. LEVEL	
9-BOX (FLOOR PLANS)	
TOP & BOTTOM ELEVATIONS	
COLUMN ELEVATION ABOVE REF. LEVEL	
10-BOX (FLOOR PLANS)	
TOP & BOTTOM ELEVATIONS	
COLUMN ELEVATION ABOVE REF. LEVEL	
11-BOX (FLOOR PLANS)	
TOP & BOTTOM ELEVATIONS	
COLUMN ELEVATION ABOVE REF. LEVEL	

THIS DRAWING IS FOR THE EXCLUSIVE USE OF MCCLONE CONSTRUCTION COMPANY, ON THE PROJECT ONLY. UTILIZATION OF THIS DRAWING BY OTHER PARTIES WITHOUT THE EXPRESSED WRITTEN CONSENT OF MCCLONE CONSTRUCTION COMPANY IS STRICTLY PROHIBITED.

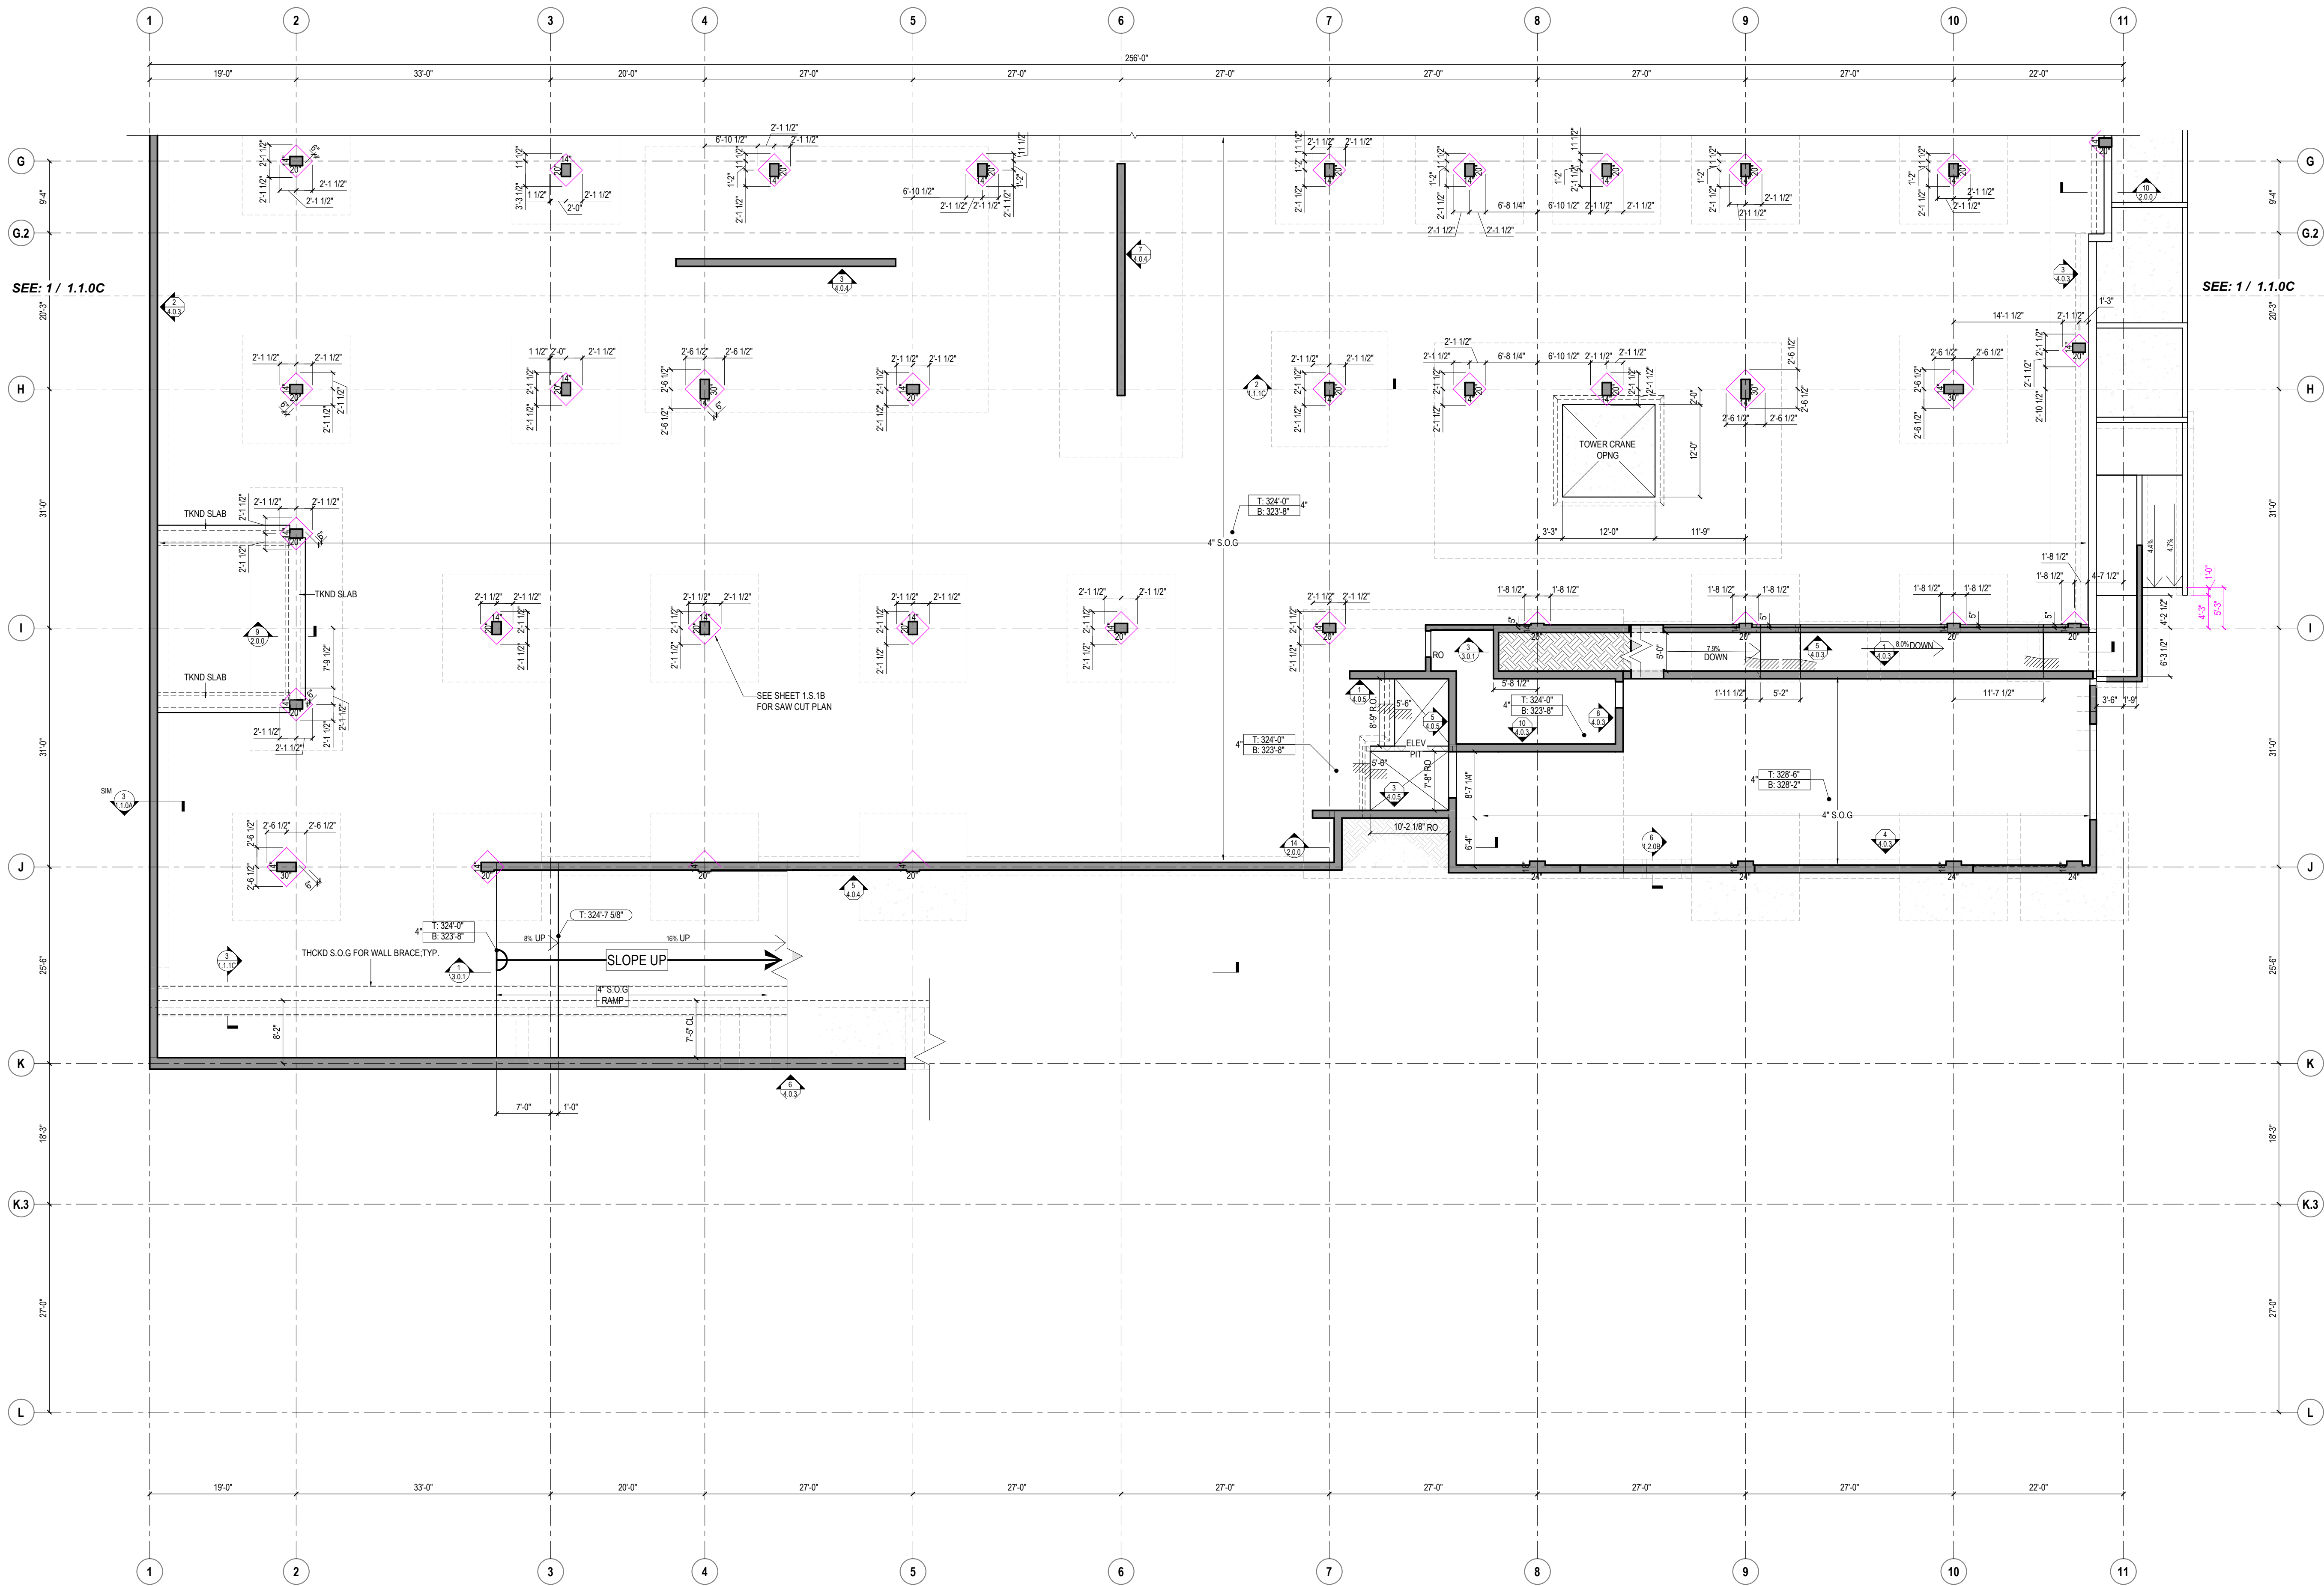


1 LEVEL-1B S.O.G FLOOR PLAN - SOUTH


PLEASE PROVIDE / VERIFY THE INFORMATION IN MAGENTA

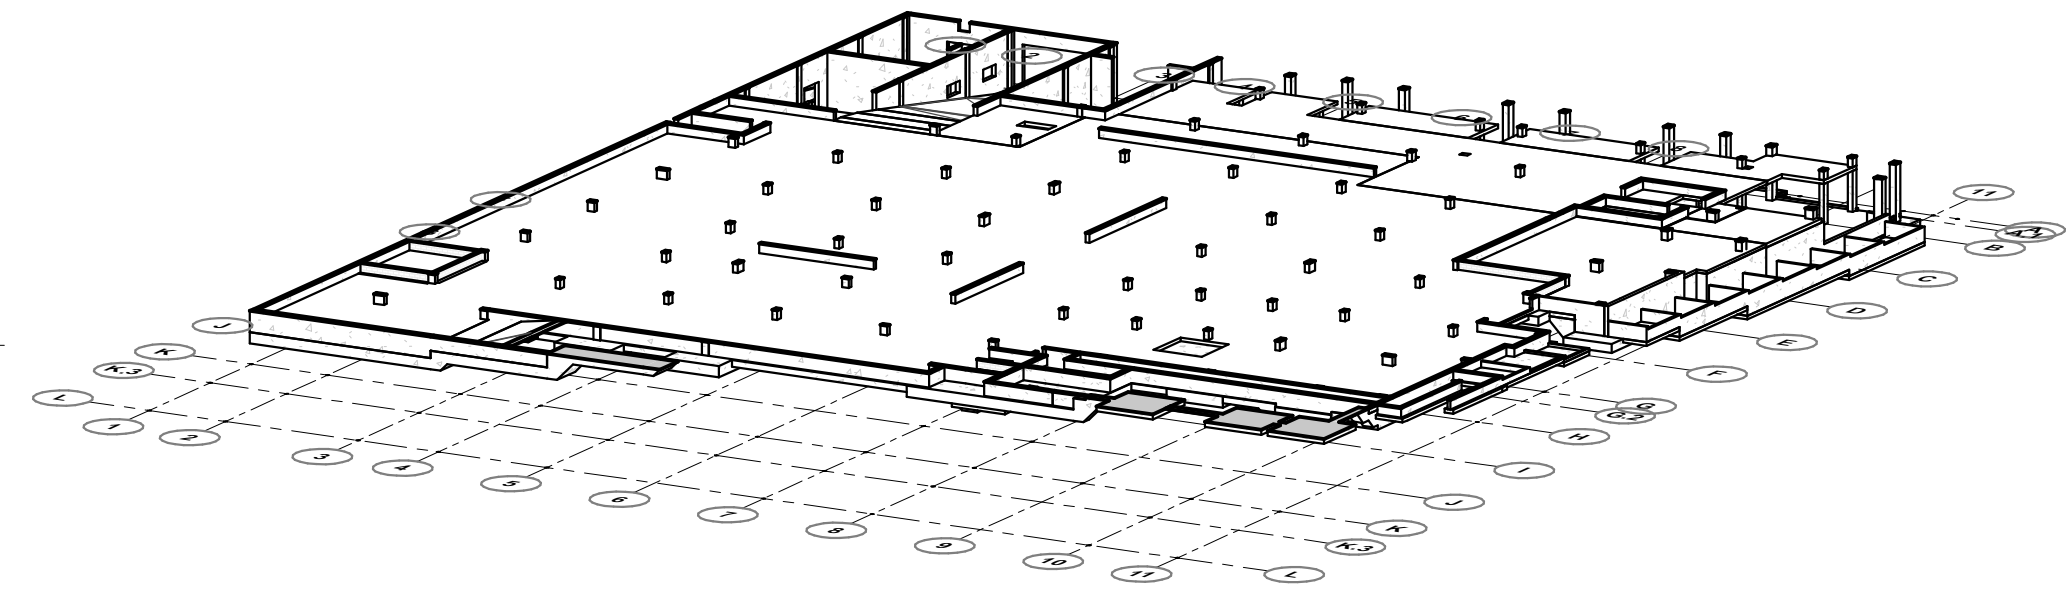


3D VIEW - LEVEL 1B SOUTH

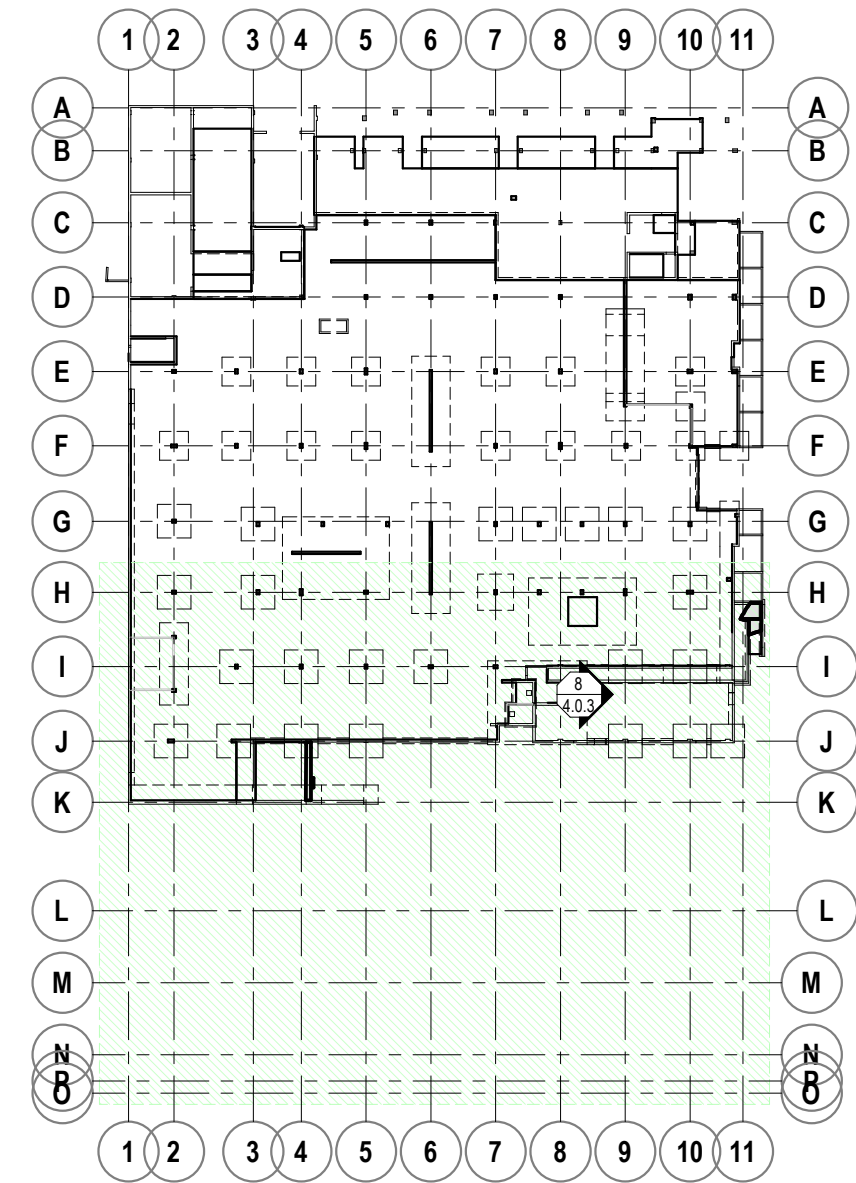

LEVEL-1B KEY PLAN SOUTH

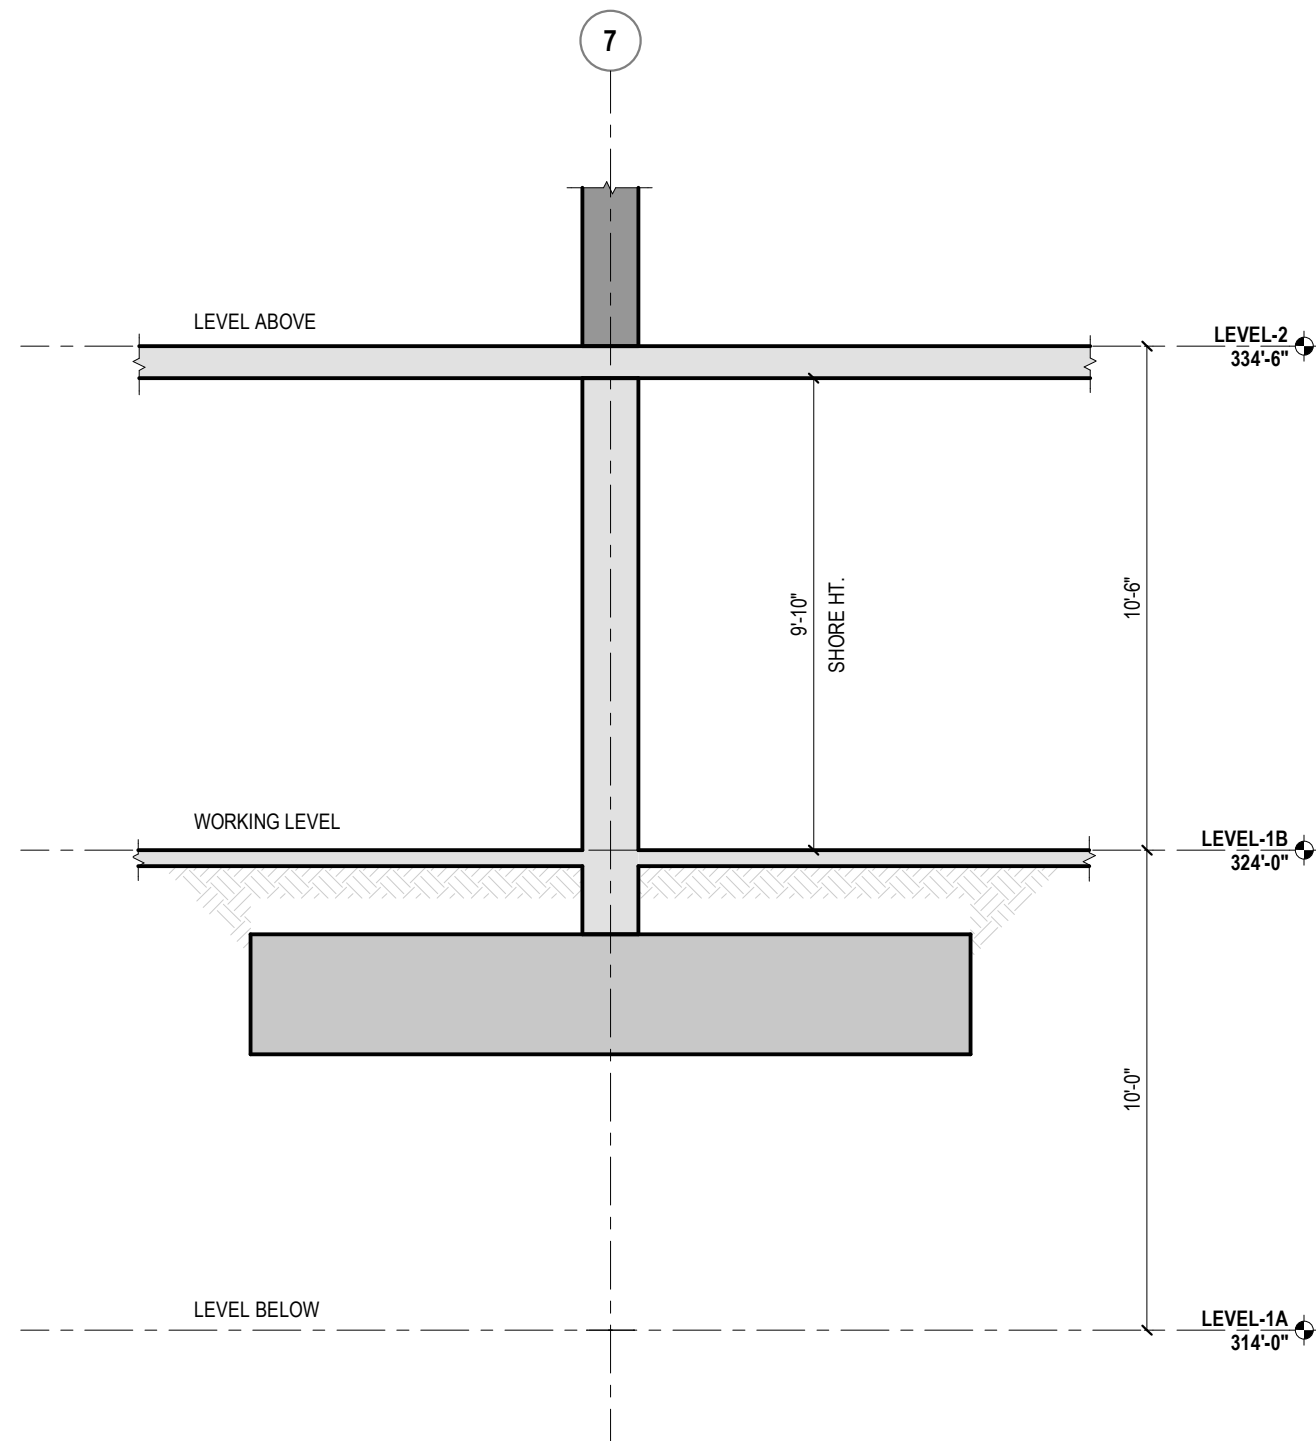

2 BUILDING SECTION LEVEL-1B

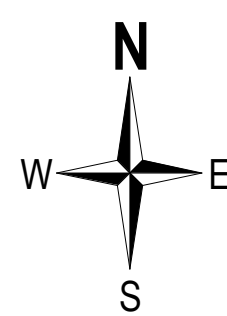


NOTES:


- 3/4" CHAMFER ON ALL EXPOSED CONCRETE CORNERS TYP.
- ALL COLUMNS ARE CENTERED ON GRID LINES U.N.O.
- ALL BEAMS ARE CENTERED ON GRID LINES U.N.O.
- SLAB ON GRADE THICKNESS IS 4" TYP. U.N.O.
- LEVEL 1B ELEVATION = 324'-0"

LEGEND

SYMBOLS		SHADE DESIGNATIONS	
1-BOX (ROUND-ENDS)	TOP OF CONCRETE ELEVATIONS	BEAM OR DROP CAP	
1-BOX	BOTTOM OF CONCRETE ELEVATIONS	WALLS OR COLUMNS	
2-BOX (PLAN VIEWS)	TOP & BOTTOM ELEVATIONS	CMU WALLS	
3-BOX (FLOOR PLANS)	TOP & BOTTOM ELEVATIONS	DELAY STRIP OR CLOSURE POUR	
4-BOX (FLOOR PLANS)	TOP & BOTTOM ELEVATIONS	GRADE OR SOIL	
5-BOX (FLOOR PLANS)	TOP & BOTTOM ELEVATIONS	Y' PYLON/SIP SLAB	
6-BOX (FLOOR PLANS)	TOP & BOTTOM ELEVATIONS	Z' PYLON/SIP SLAB	
7-BOX (FLOOR PLANS)	TOP & BOTTOM ELEVATIONS		
8-BOX (FLOOR PLANS)	TOP & BOTTOM ELEVATIONS		
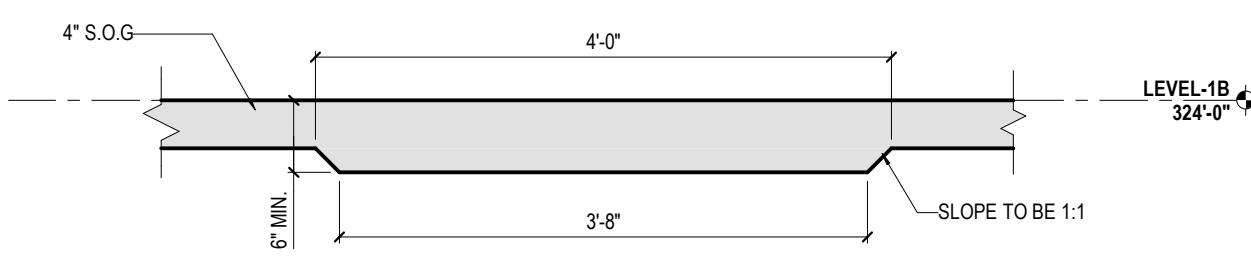


3 THICKENED S.O.G FOR WALL BRACE

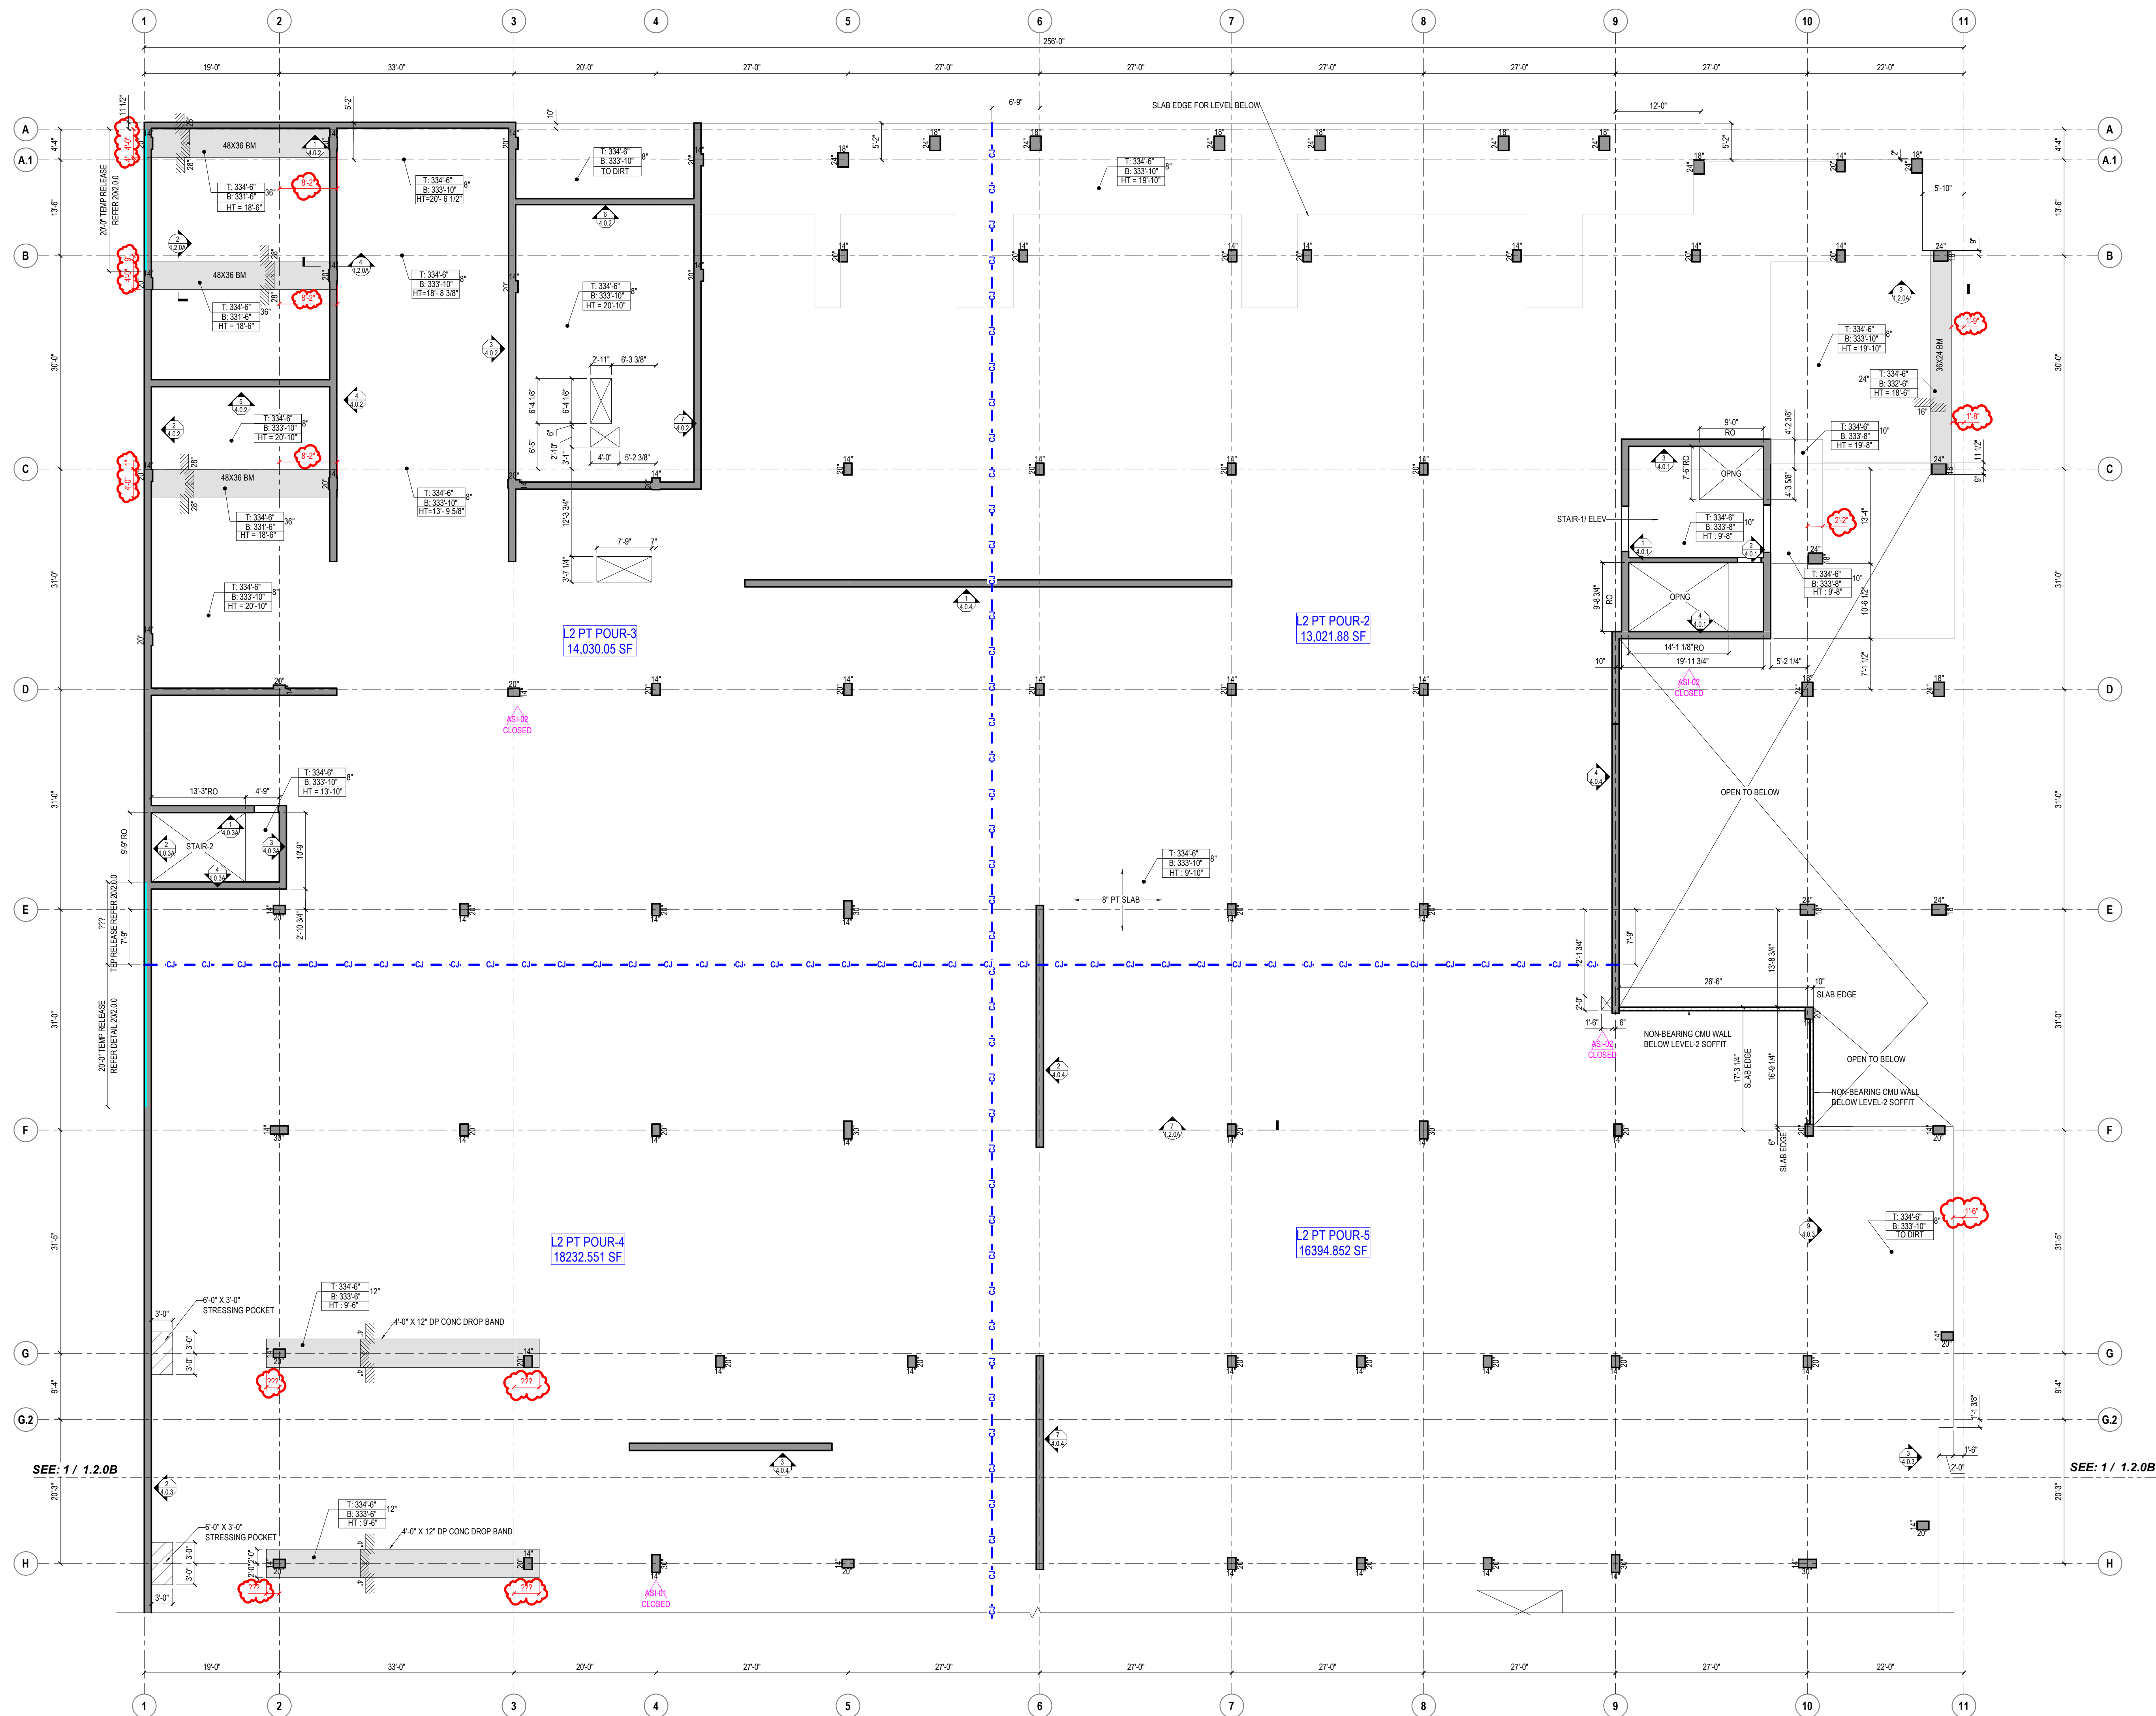


1 LEVEL-2 (SOFFIT PLAN) - NORTH


****PLEASE PROVIDE / VERIFY THE INFORMATION IN RED****

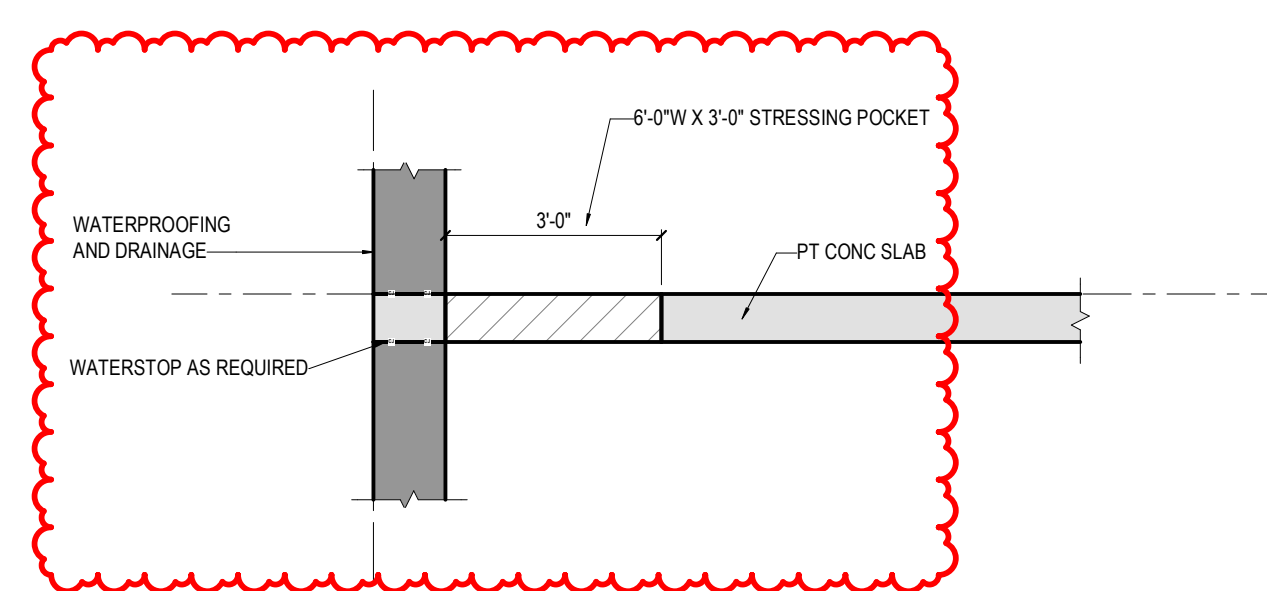


5 TYPICAL STRSSING POCKET

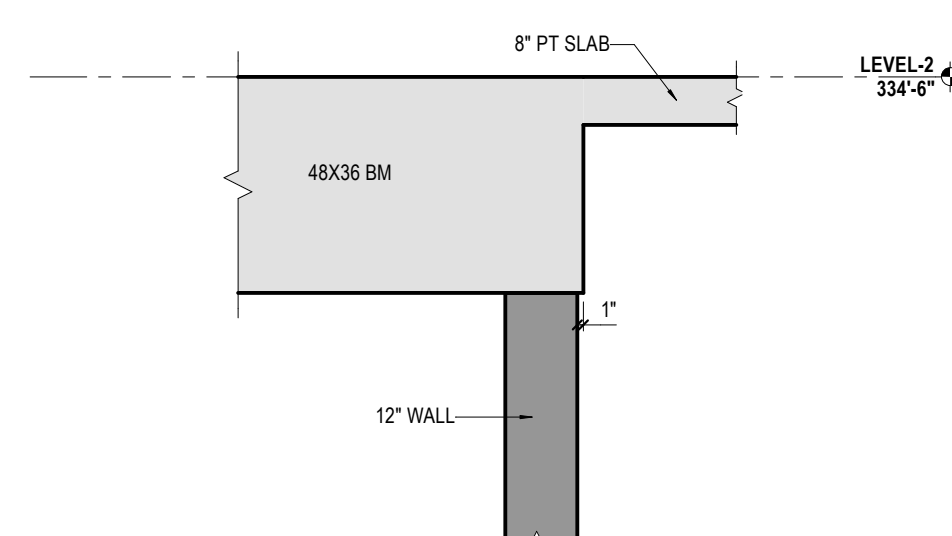


4 BEAM AT THE WALL LOCATION

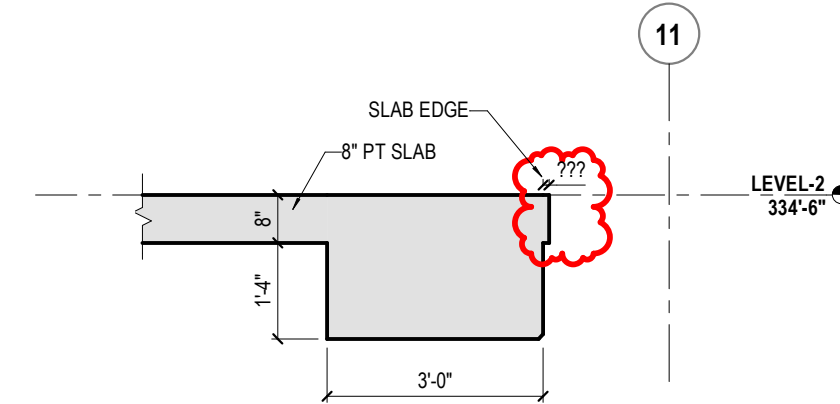


3 TYP EXTERIOR BEAM

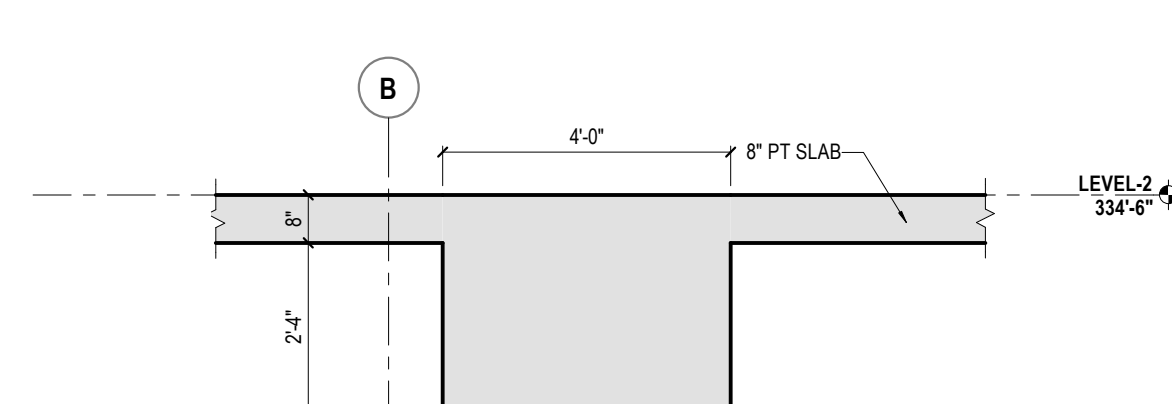


2 TYP INTERIOR BEAM

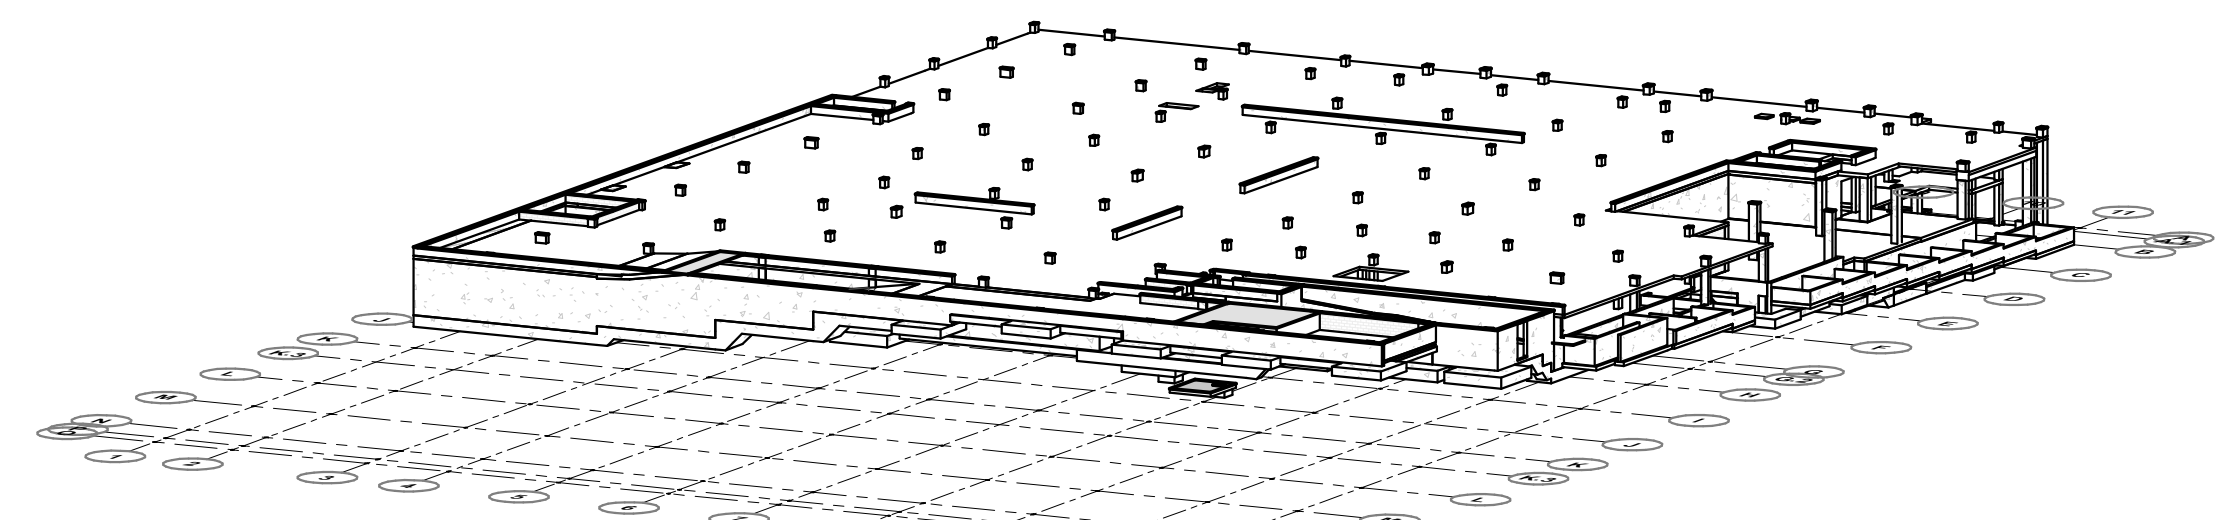


3D VIEW LEVEL-2

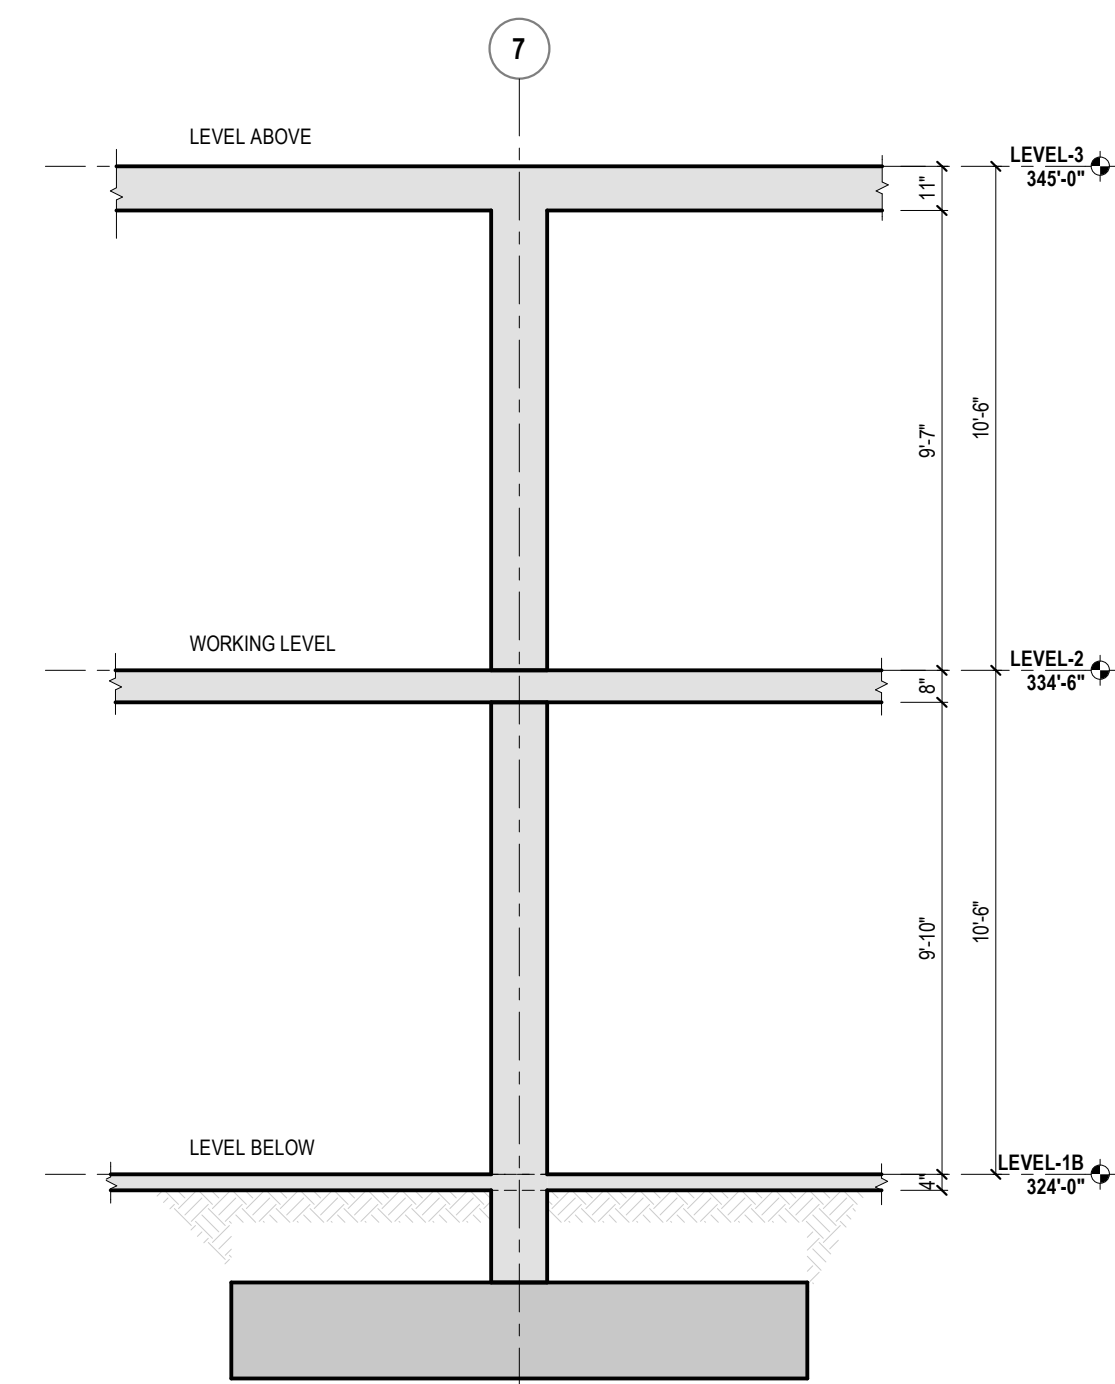

7 BUILDING SECTION LEVEL-2 NORTH

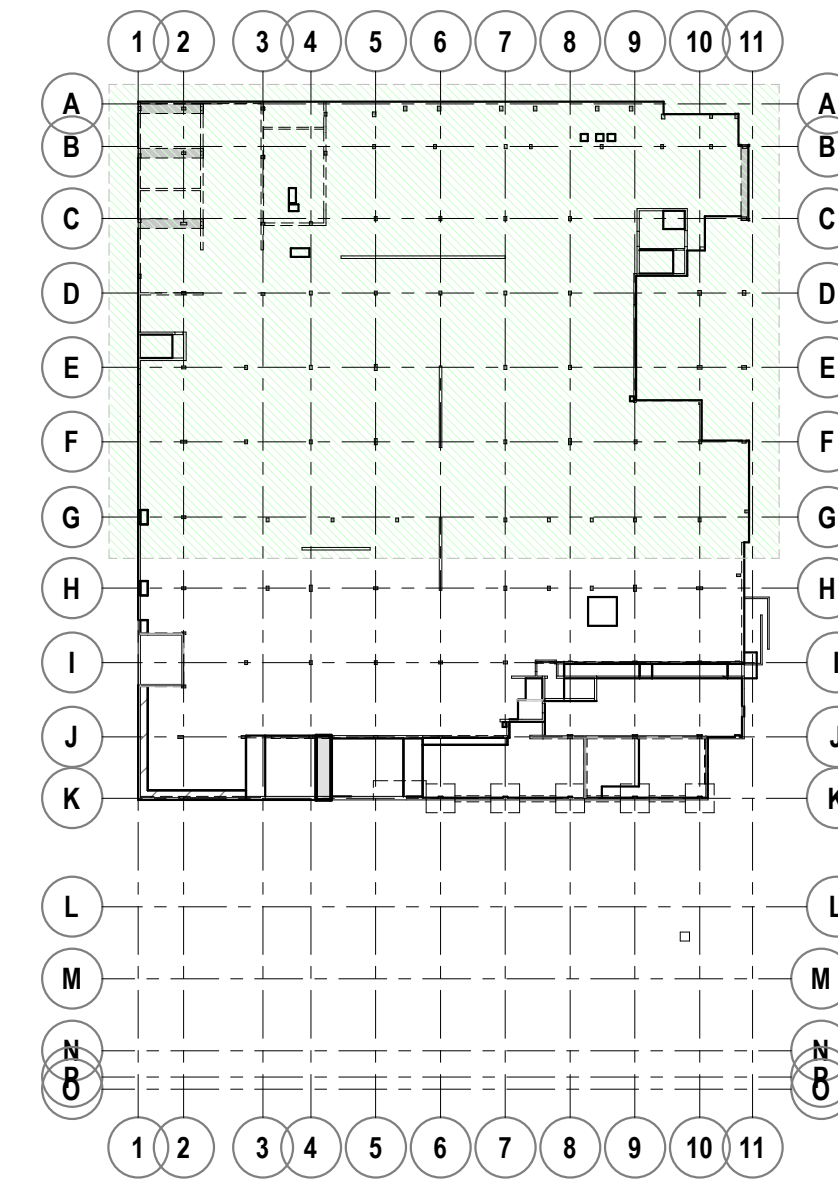

LEVEL-2 KEY PLAN NORTH

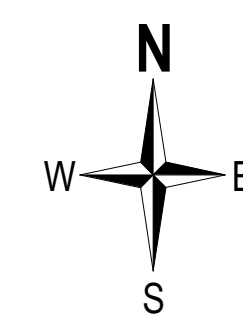

NOTES:

1. 3/4" CHAMFER ON ALL EXPOSED CONCRETE CORNERS TYP.
2. ALL COLUMNS ARE CENTERED ON GRID LINES U.N.O.
3. ALL BEAMS ARE CENTERED ON GRID LINES U.N.O.
4. SLAB THICKNESS IS 8" TYP. U.N.O.
5. LEVEL 2 ELEVATION = 334'-6"

LEGEND

SYMBOLS		SHADE DESIGNATIONS	
1-BOX (ROUND-ENDS) TOP OF CONCRETE ELEVATIONS		BEAM OR DROP CAP WALLS OR COLUMNS	
1-BOX BOTTOM OF CONCRETE ELEVATIONS		C/WALLS	
2-BOX (PLAN VIEWS) TOP & BOTTOM ELEVATIONS		DELAY START OR CLOSURE POND	
2-DEPTH OF CONCRETE MEMBER		GRADE OR SOIL	
2-BOX (SPOTT PLAN) TOP & BOTTOM ELEVATIONS		Y" PT/MS CLIP	
2-BOX (SPOTT PLAN) HORIZONTAL REFERENCE LEVEL		Z" PT/MS CLIP	
2-DEPTH OF CONCRETE MEMBER		LINE DESIGNATIONS	

LINE DESIGNATIONS



----- INDICATES TOP OF SLAB CHANGE OR EDGE OF SLAB

----- INDICATES SOFFIT CHANGE


---CJ---CJ--- INDICATES CONSTRUCTION JOINT

--- --- INDICATES GRID LINE

THIS DRAWING IS FOR THE EXCLUSIVE USE OF MCCLONE CONSTRUCTION COMPANY. ON THE PROJECT ONLY. UTILIZATION OF THIS DRAWING BY OTHER PARTIES WITHOUT THE WRITTEN CONSENT OF MCCLONE CONSTRUCTION COMPANY IS STRICTLY PROHIBITED.

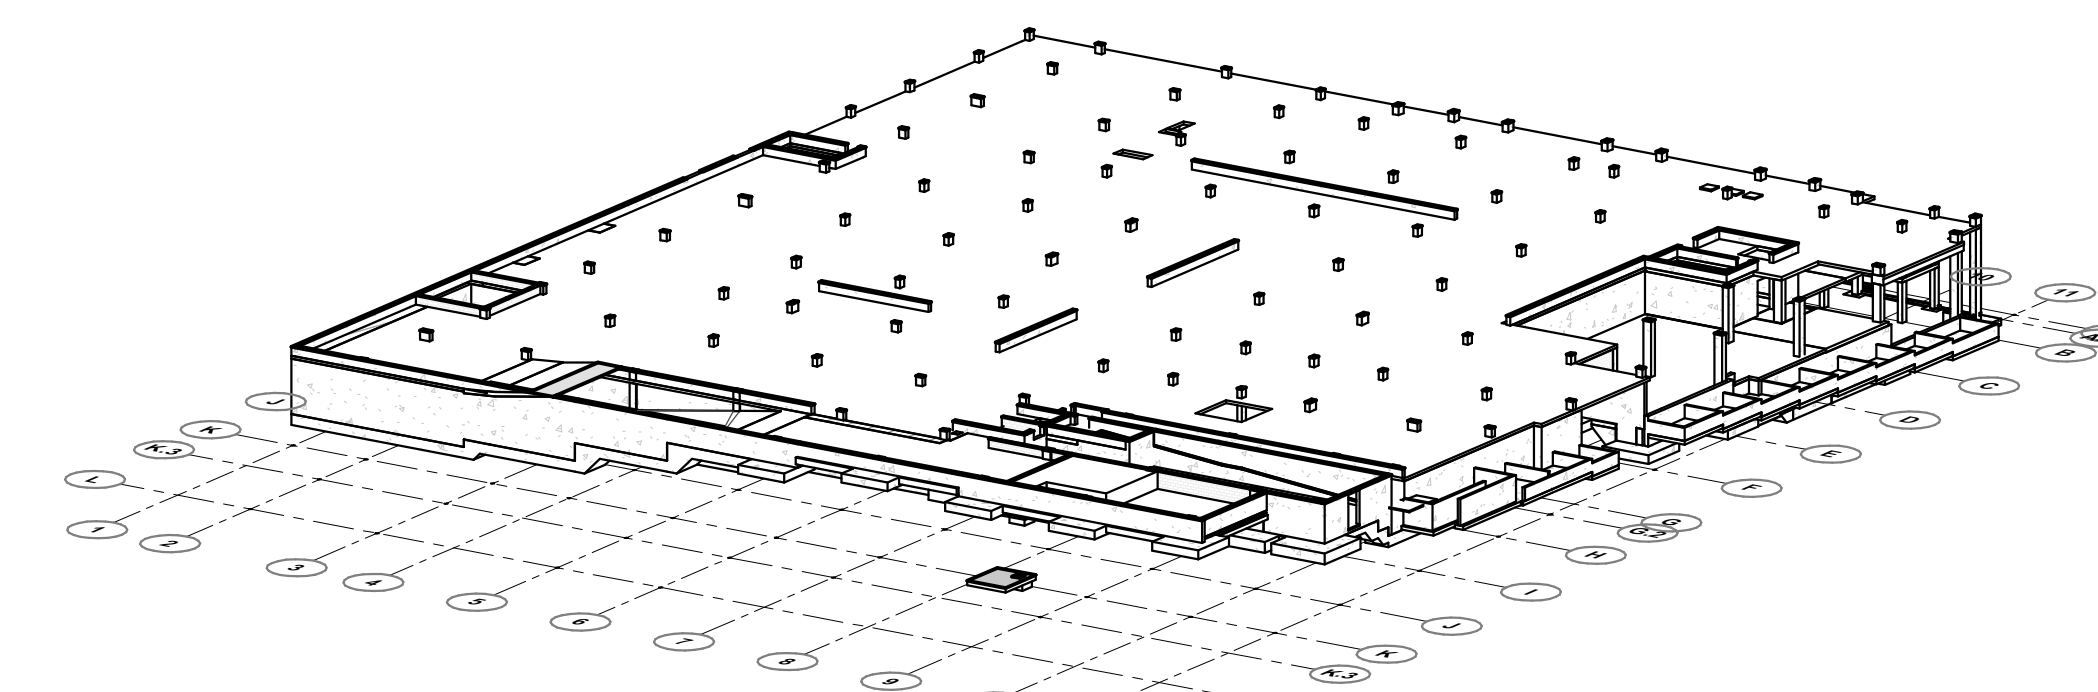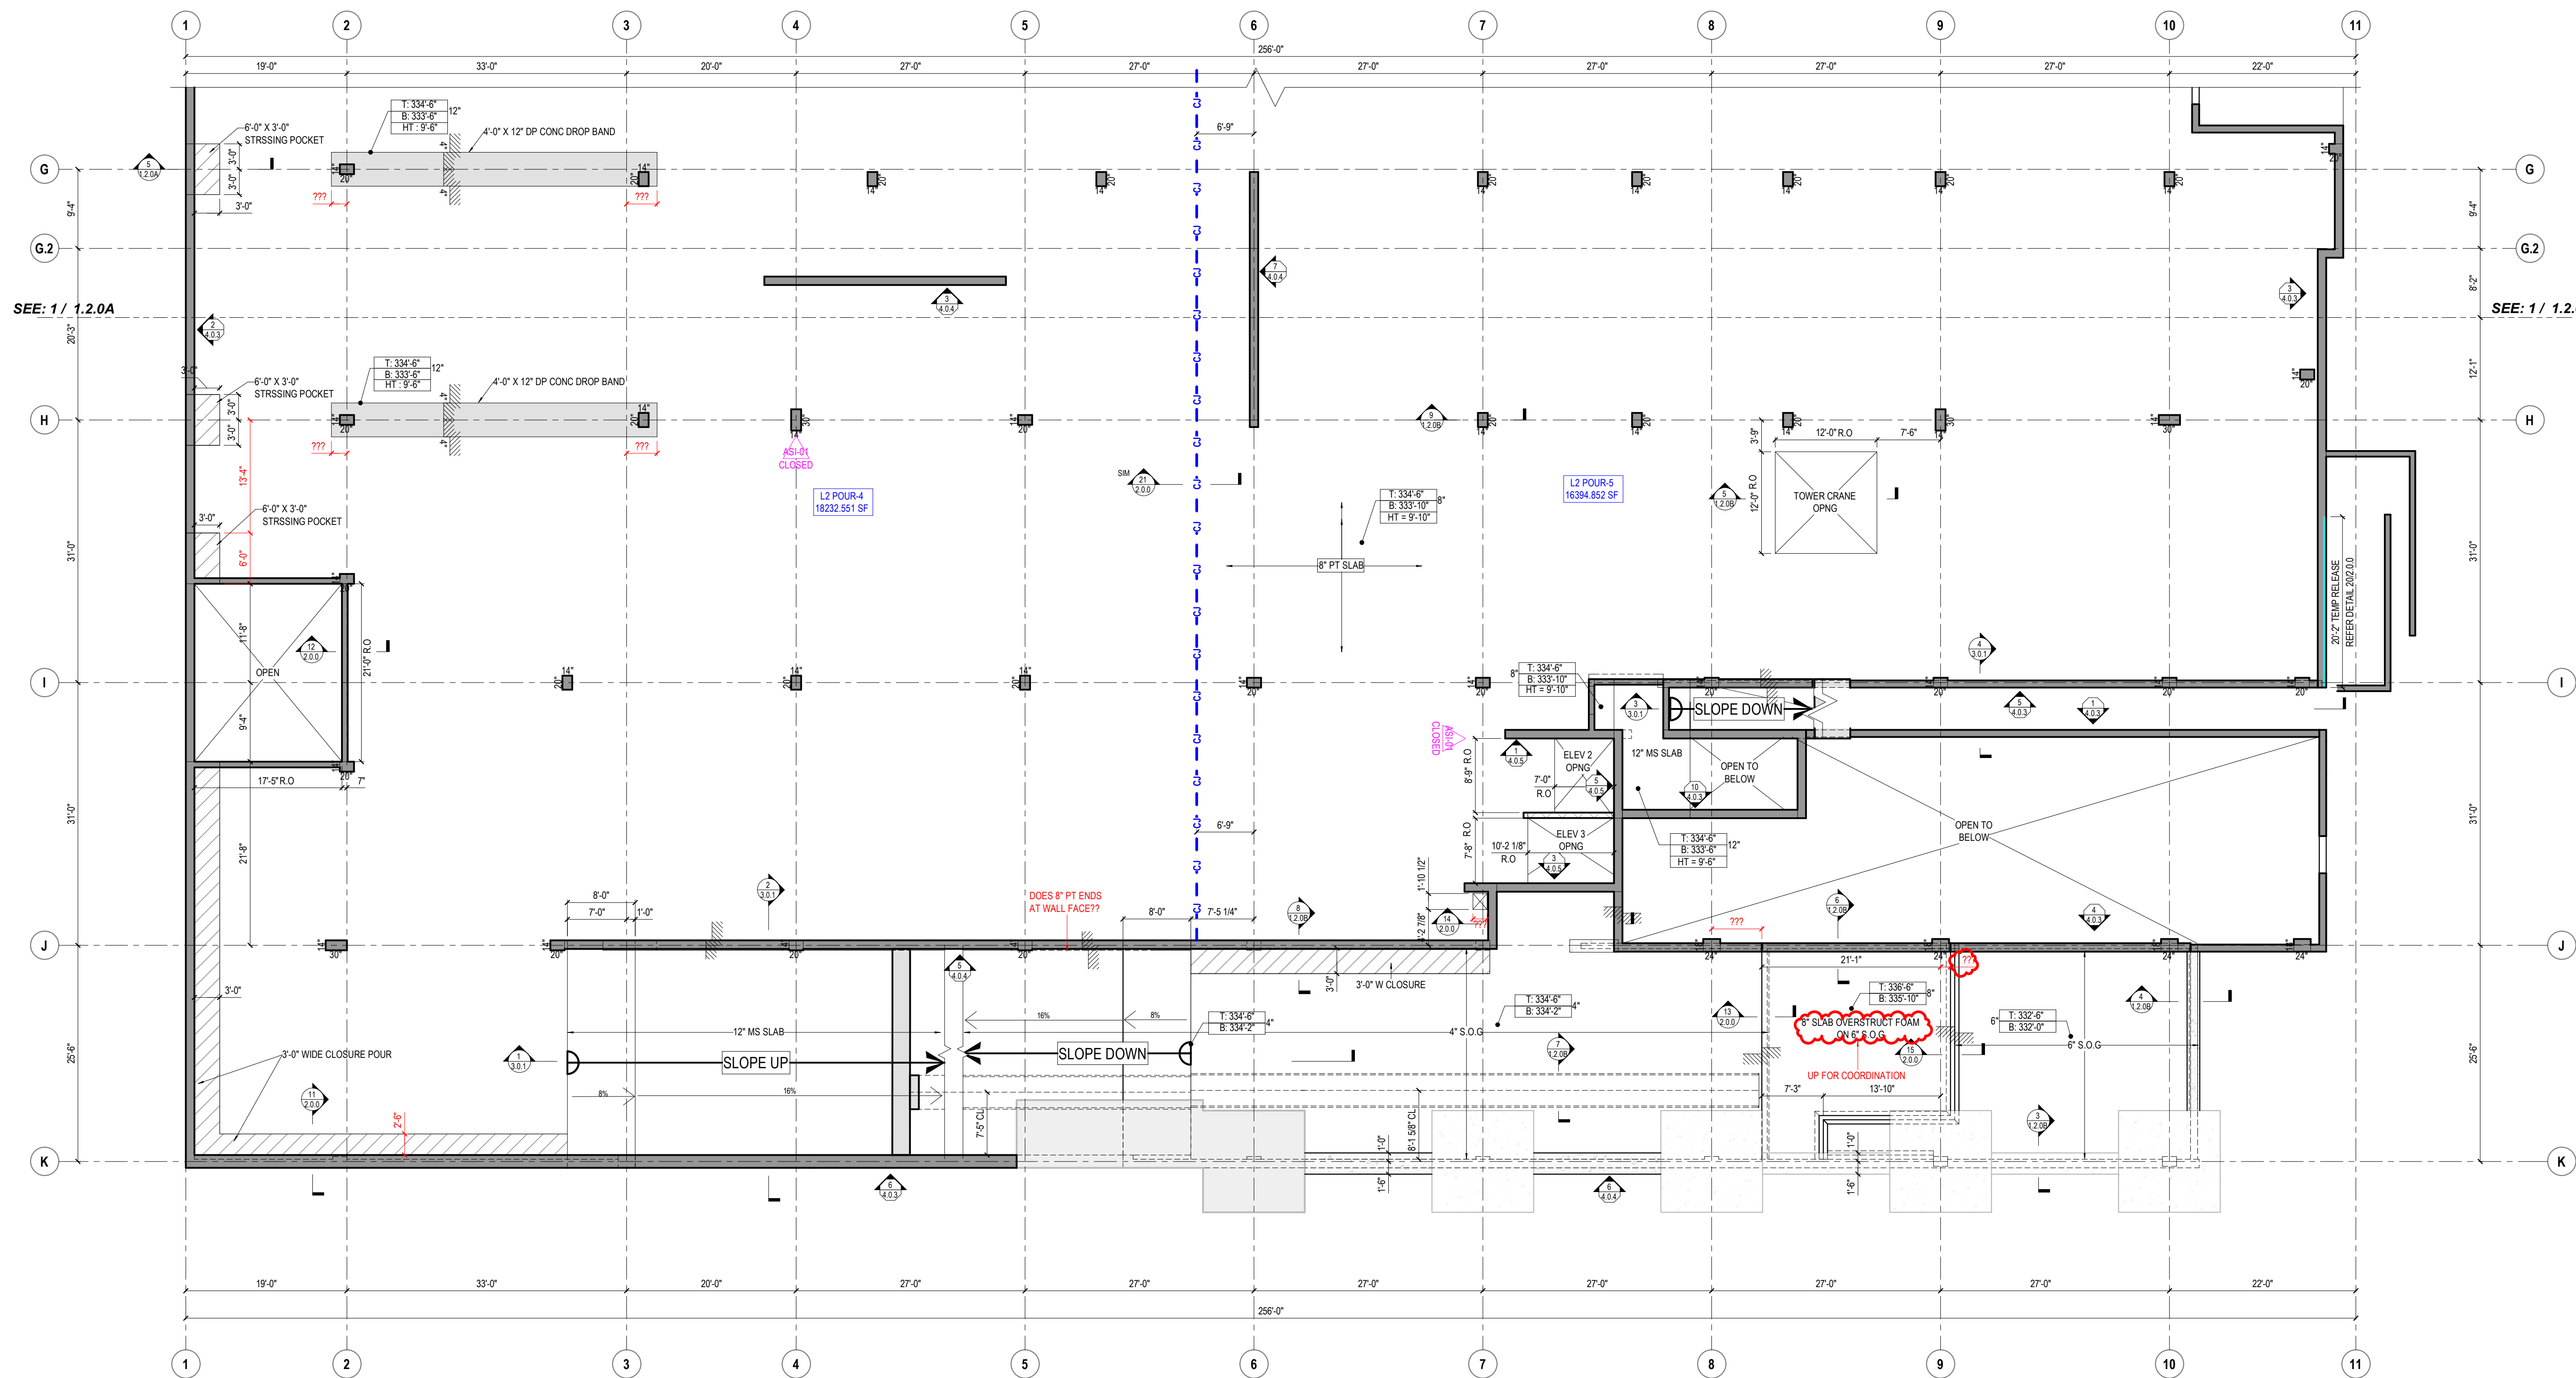


3D VIEW LEVEL-2

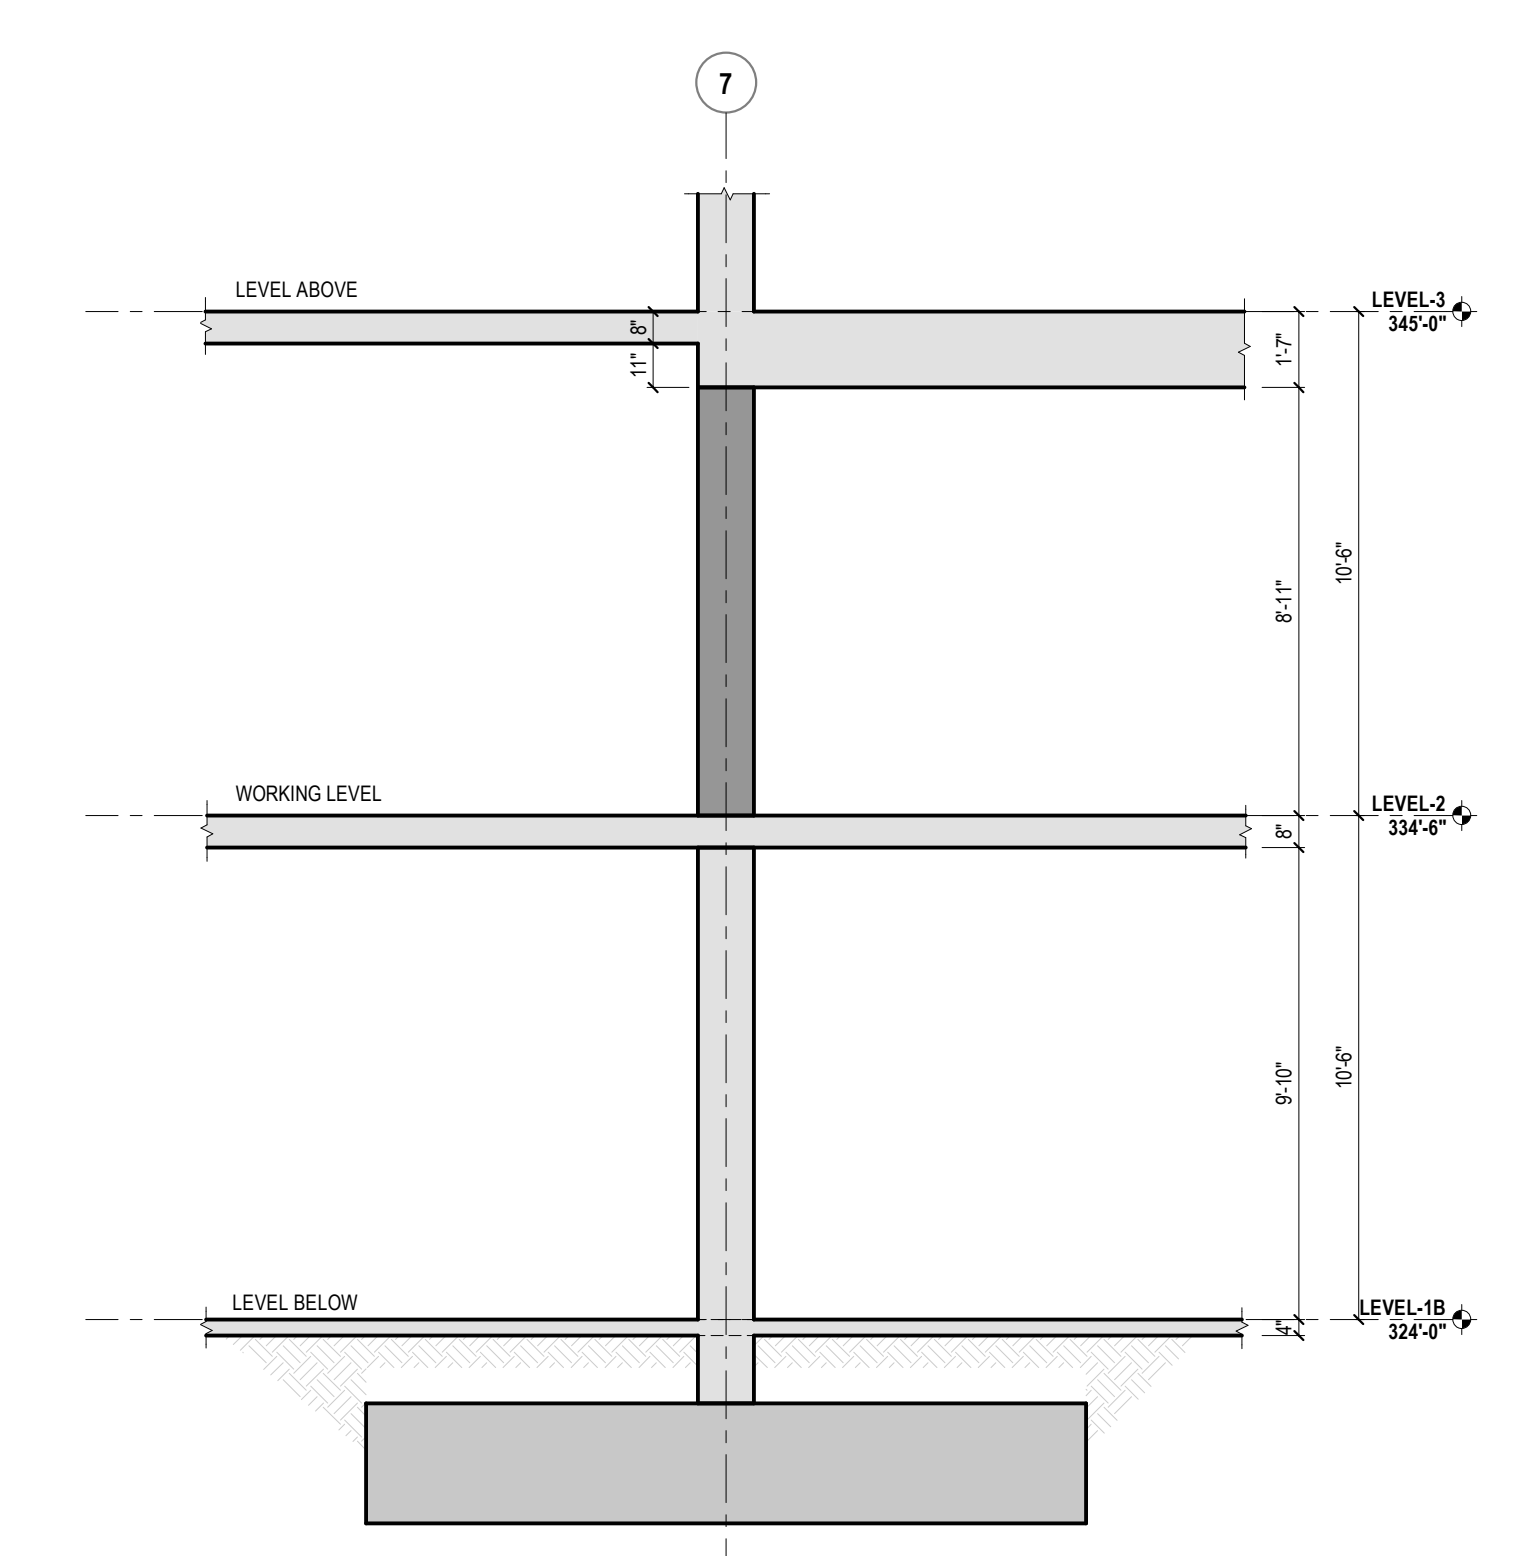


9 BUILDING SECTION LEVEL-2 SOUTH

1 LEVEL-2 (SOFFIT PLAN) - SOUTH

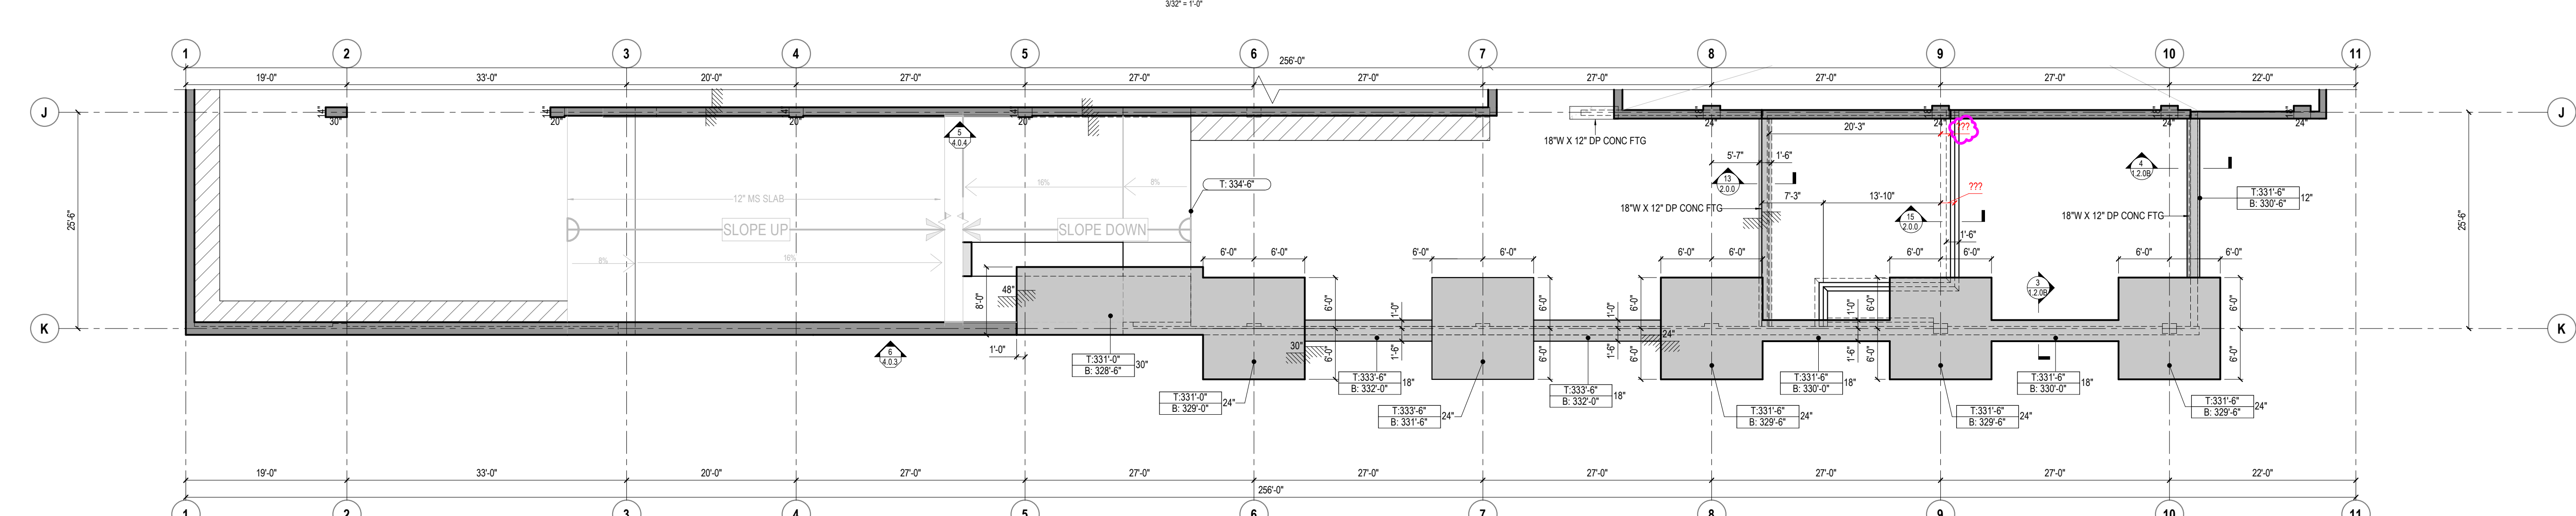

2 LEVEL-2 (SOFFIT PLAN) - SOUTH FOUNDATION

PLEASE PROVIDE / VERIFY THE INFORMATION IN RED

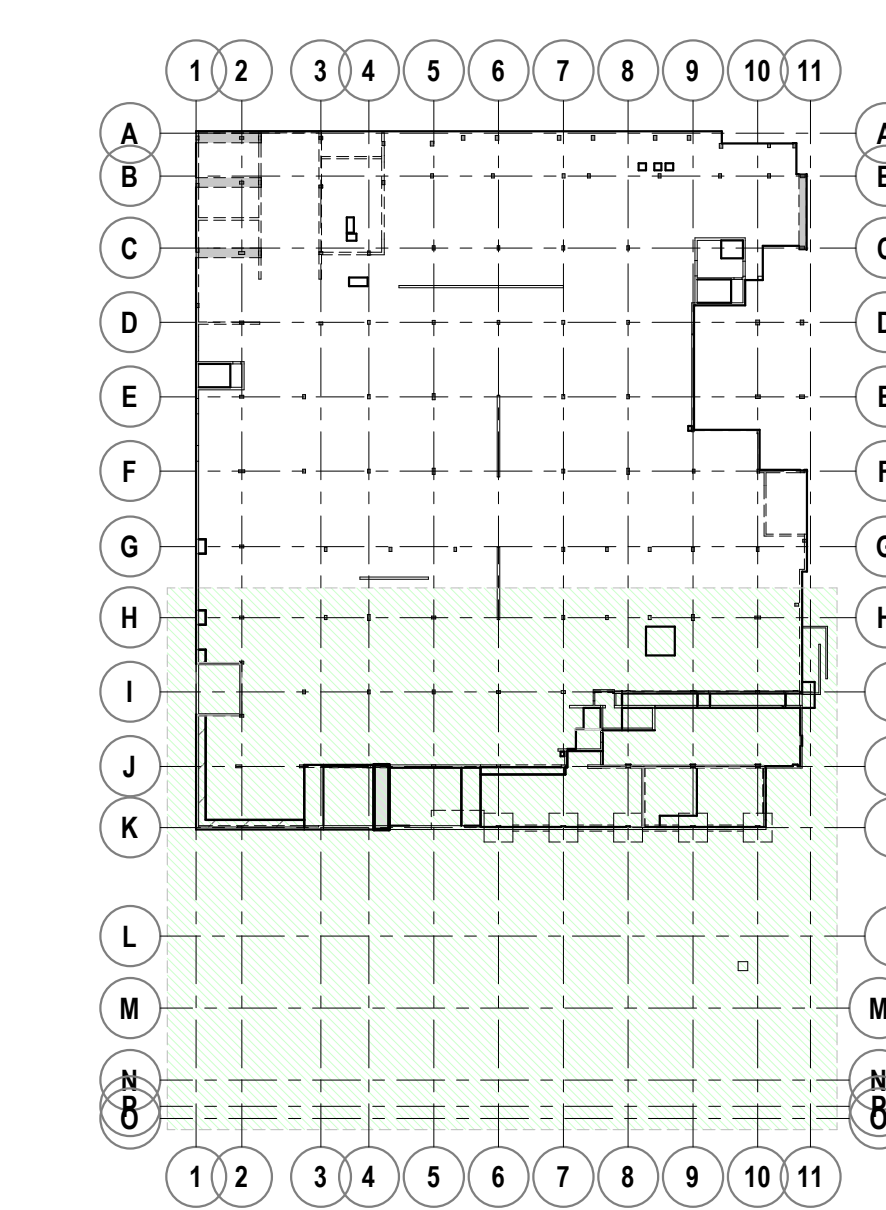

LEVEL-2 KEY PLAN SOUTH




- NOTES:**
- 3/4" CHAMFER ON ALL EXPOSED CONCRETE CORNERS TYP.
 - ALL COLUMNS ARE CENTERED ON GRID LINES U.N.O.
 - ALL BEAMS ARE CENTERED ON GRID LINES U.N.O.
 - SLAB THICKNESS IS 8" TYP. U.N.O.
 - LEVEL 2 ELEVATION = 334'-6"

LEGEND


SYMBOLS	SHADE DESIGNATIONS
1-BOX (ROUND ENDS) TOP OF CONCRETE ELEVATIONS	BEAM OR DROP CAP
1-BOX BOTTOM OF CONCRETE ELEVATIONS	WALLS OR COLUMNS
2-BOX (PLAN VIEWS) TOP & BOTTOM ELEVATIONS	CMU WALLS
3-BOX (SOFFIT PLANS) TOP & BOTTOM ELEVATIONS	DELAY STRIP OR CLOSURE POUR
4-BOX (SOFFIT PLANS) TOP & BOTTOM ELEVATIONS	GRADE OR SOIL
5-BOX (SOFFIT PLANS) TOP & BOTTOM ELEVATIONS	Y' PT/MS/CP SLAB
6-BOX (SOFFIT PLANS) TOP & BOTTOM ELEVATIONS	Z' PT/MS/CP SLAB

LINE DESIGNATIONS


- INDICATES TOP OF SLAB CHANGE OR EDGE OF SLAB
- INDICATES SOFFIT CHANGE
- INDICATES CONSTRUCTION JOINT
- INDICATES GRID LINE

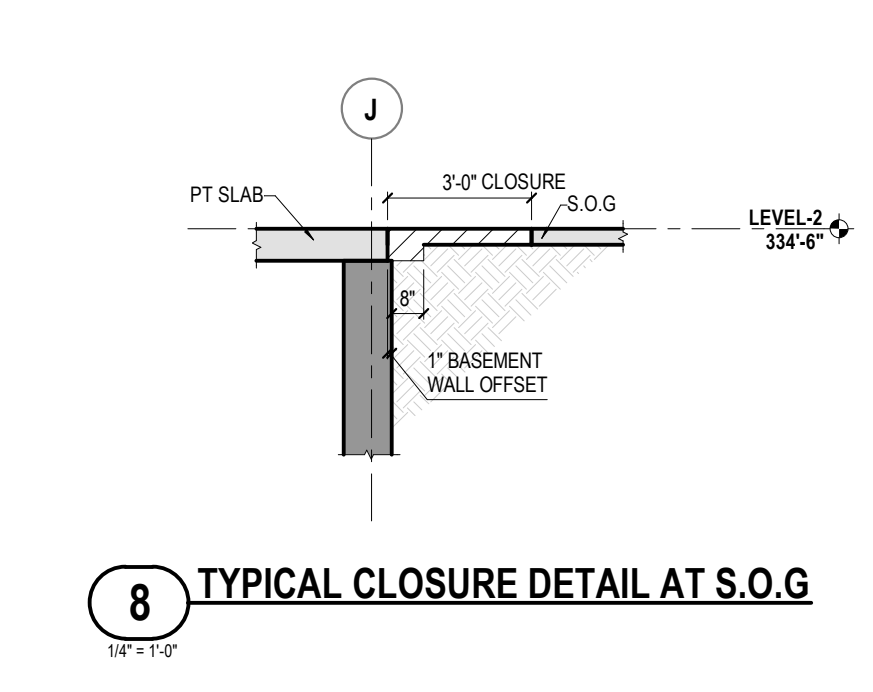


8 TYPICAL CLOSURE DETAIL AT S.O.G.

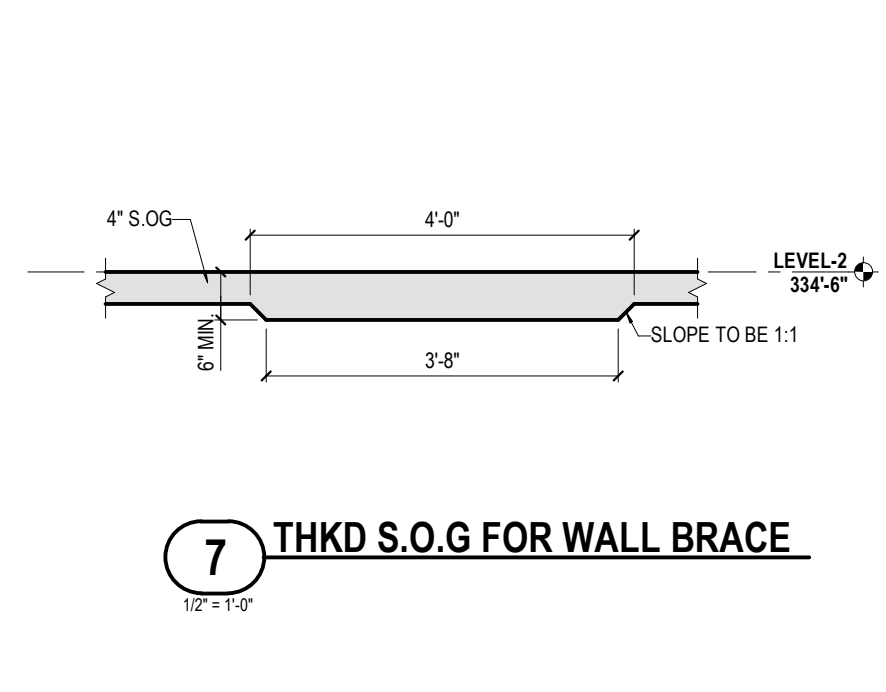


7 THKD S.O.G. FOR WALL BRACE

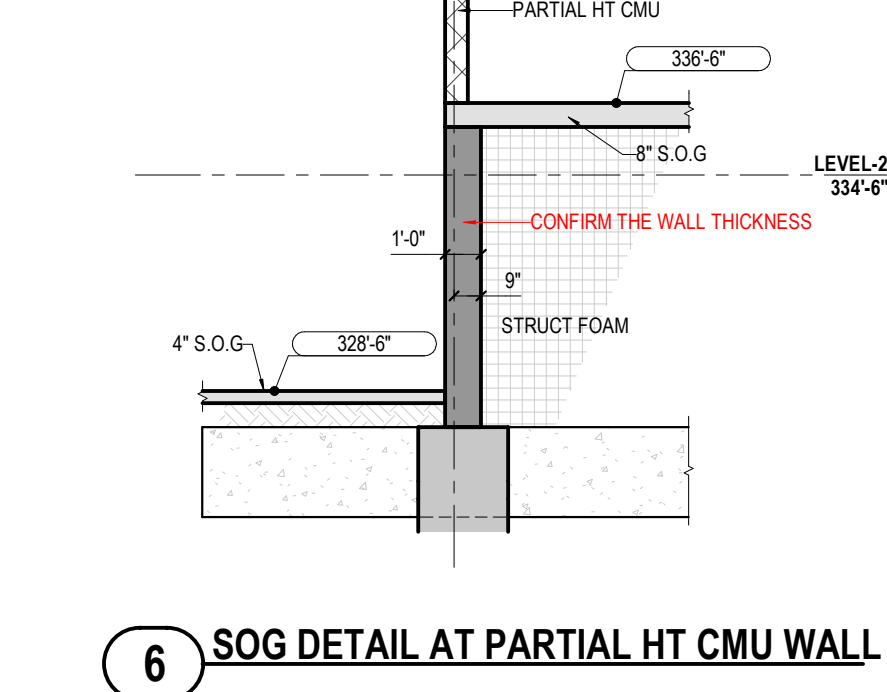


6 SOG DETAIL AT PARTIAL HT CMU WALL

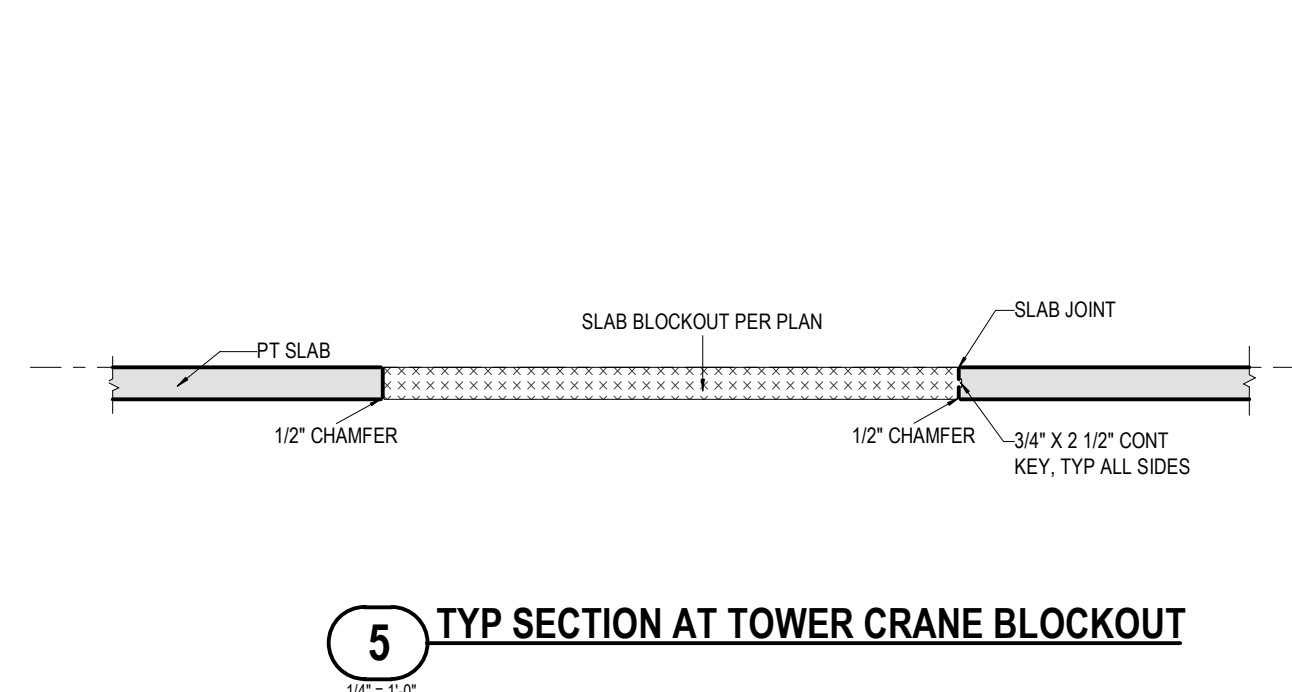

5 TYP SECTION AT TOWER CRANE BLOCKOUT


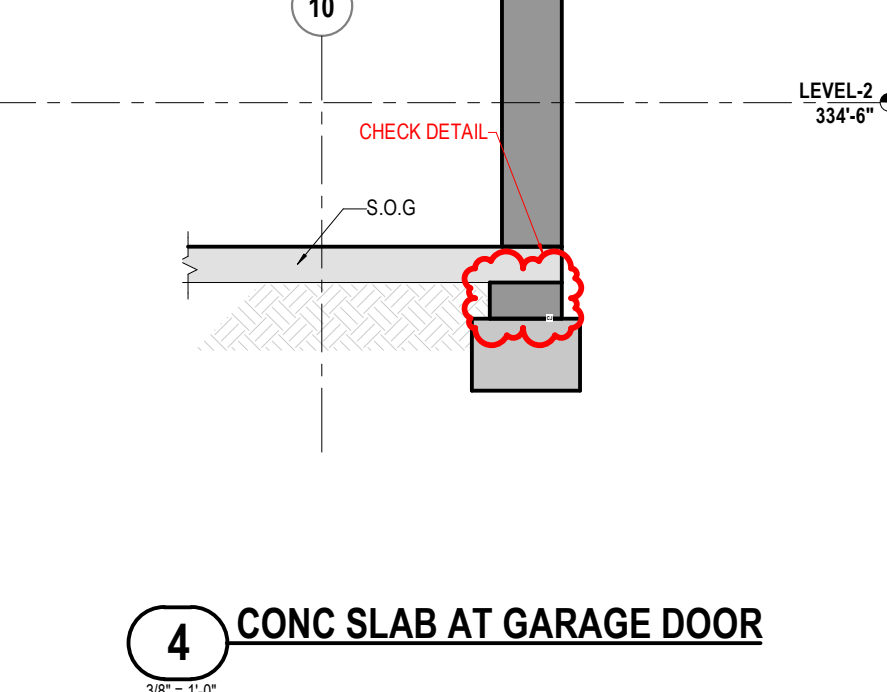


4 CONC SLAB AT GARAGE DOOR

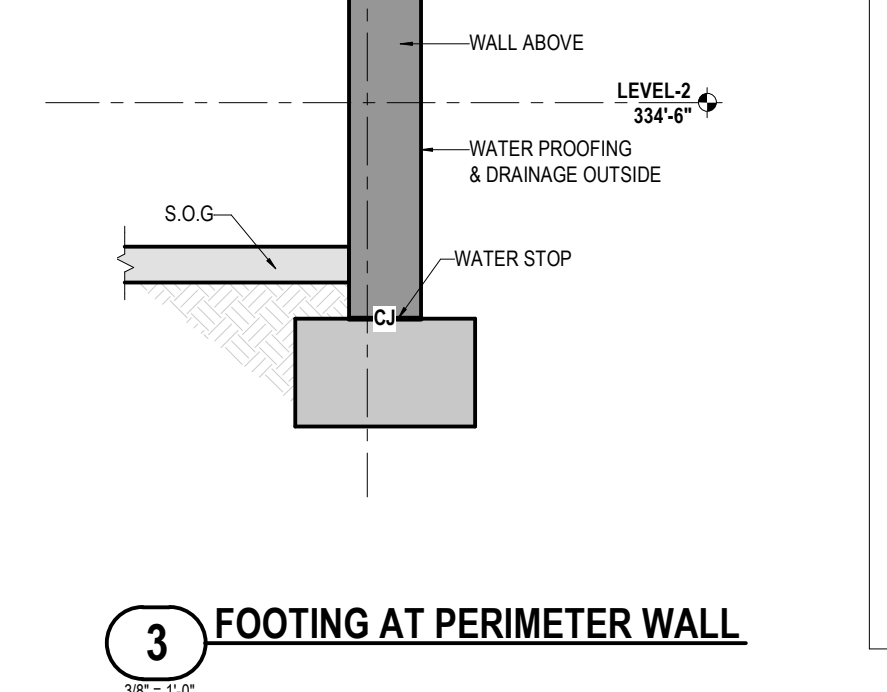


3 FOOTING AT PERIMETER WALL


THIS DRAWING IS FOR THE EXCLUSIVE USE OF MCCLONE CONSTRUCTION COMPANY. ON THE PROJECT ONLY. UTILIZATION OF THIS DRAWING BY OTHER PARTIES WITHOUT THE EXPRESSED WRITTEN CONSENT OF MCCLONE CONSTRUCTION COMPANY IS STRICTLY PROHIBITED.

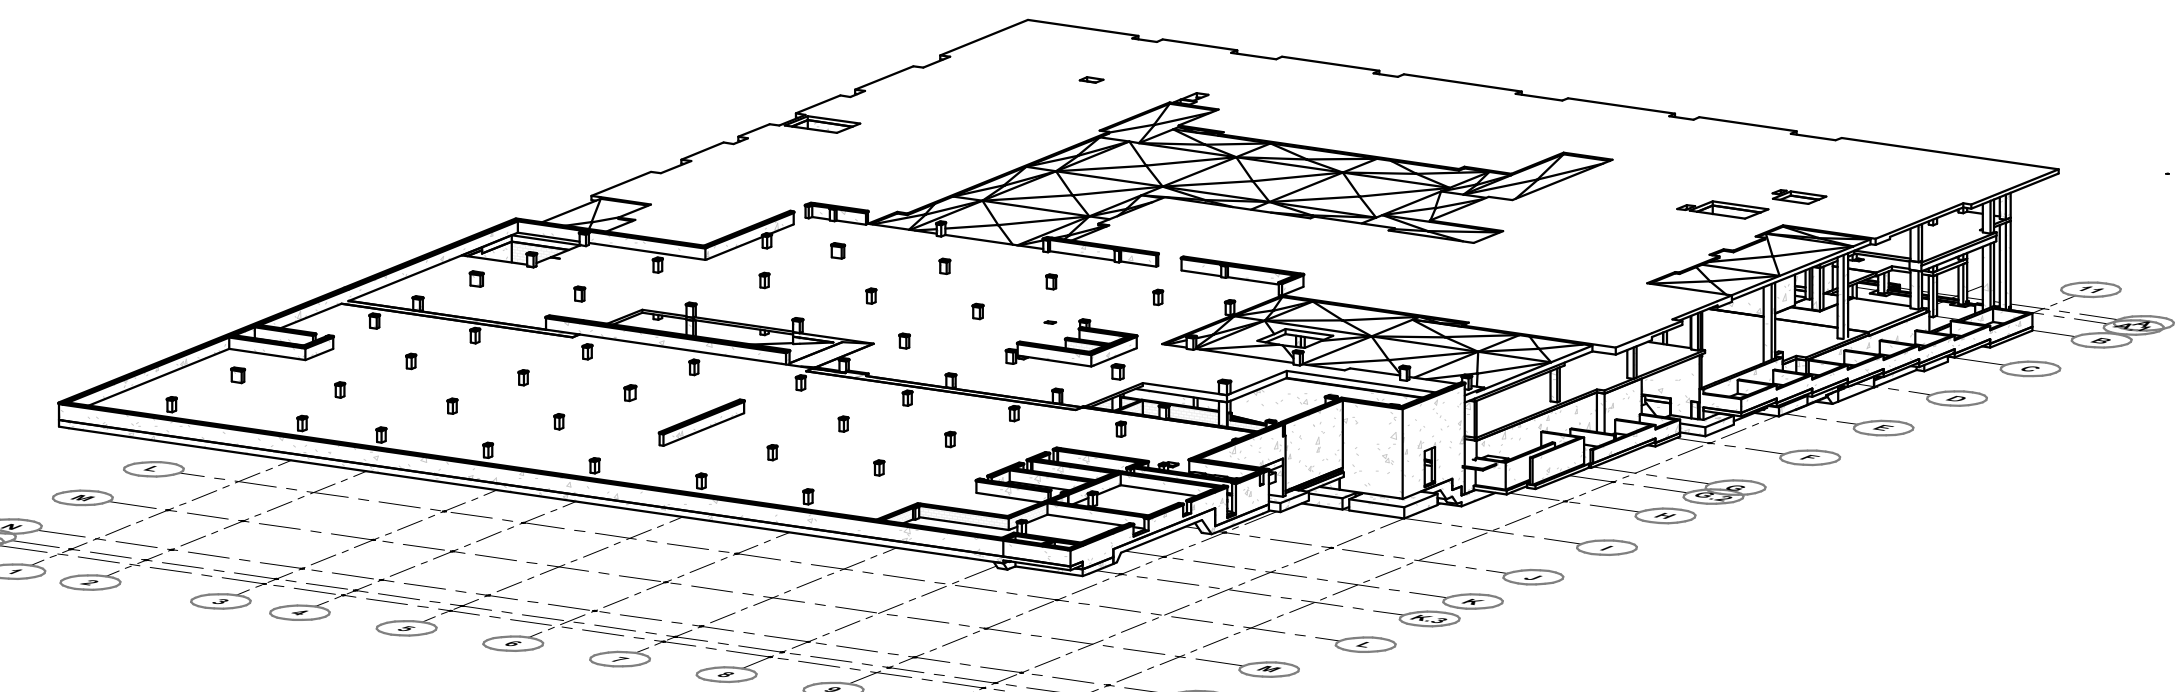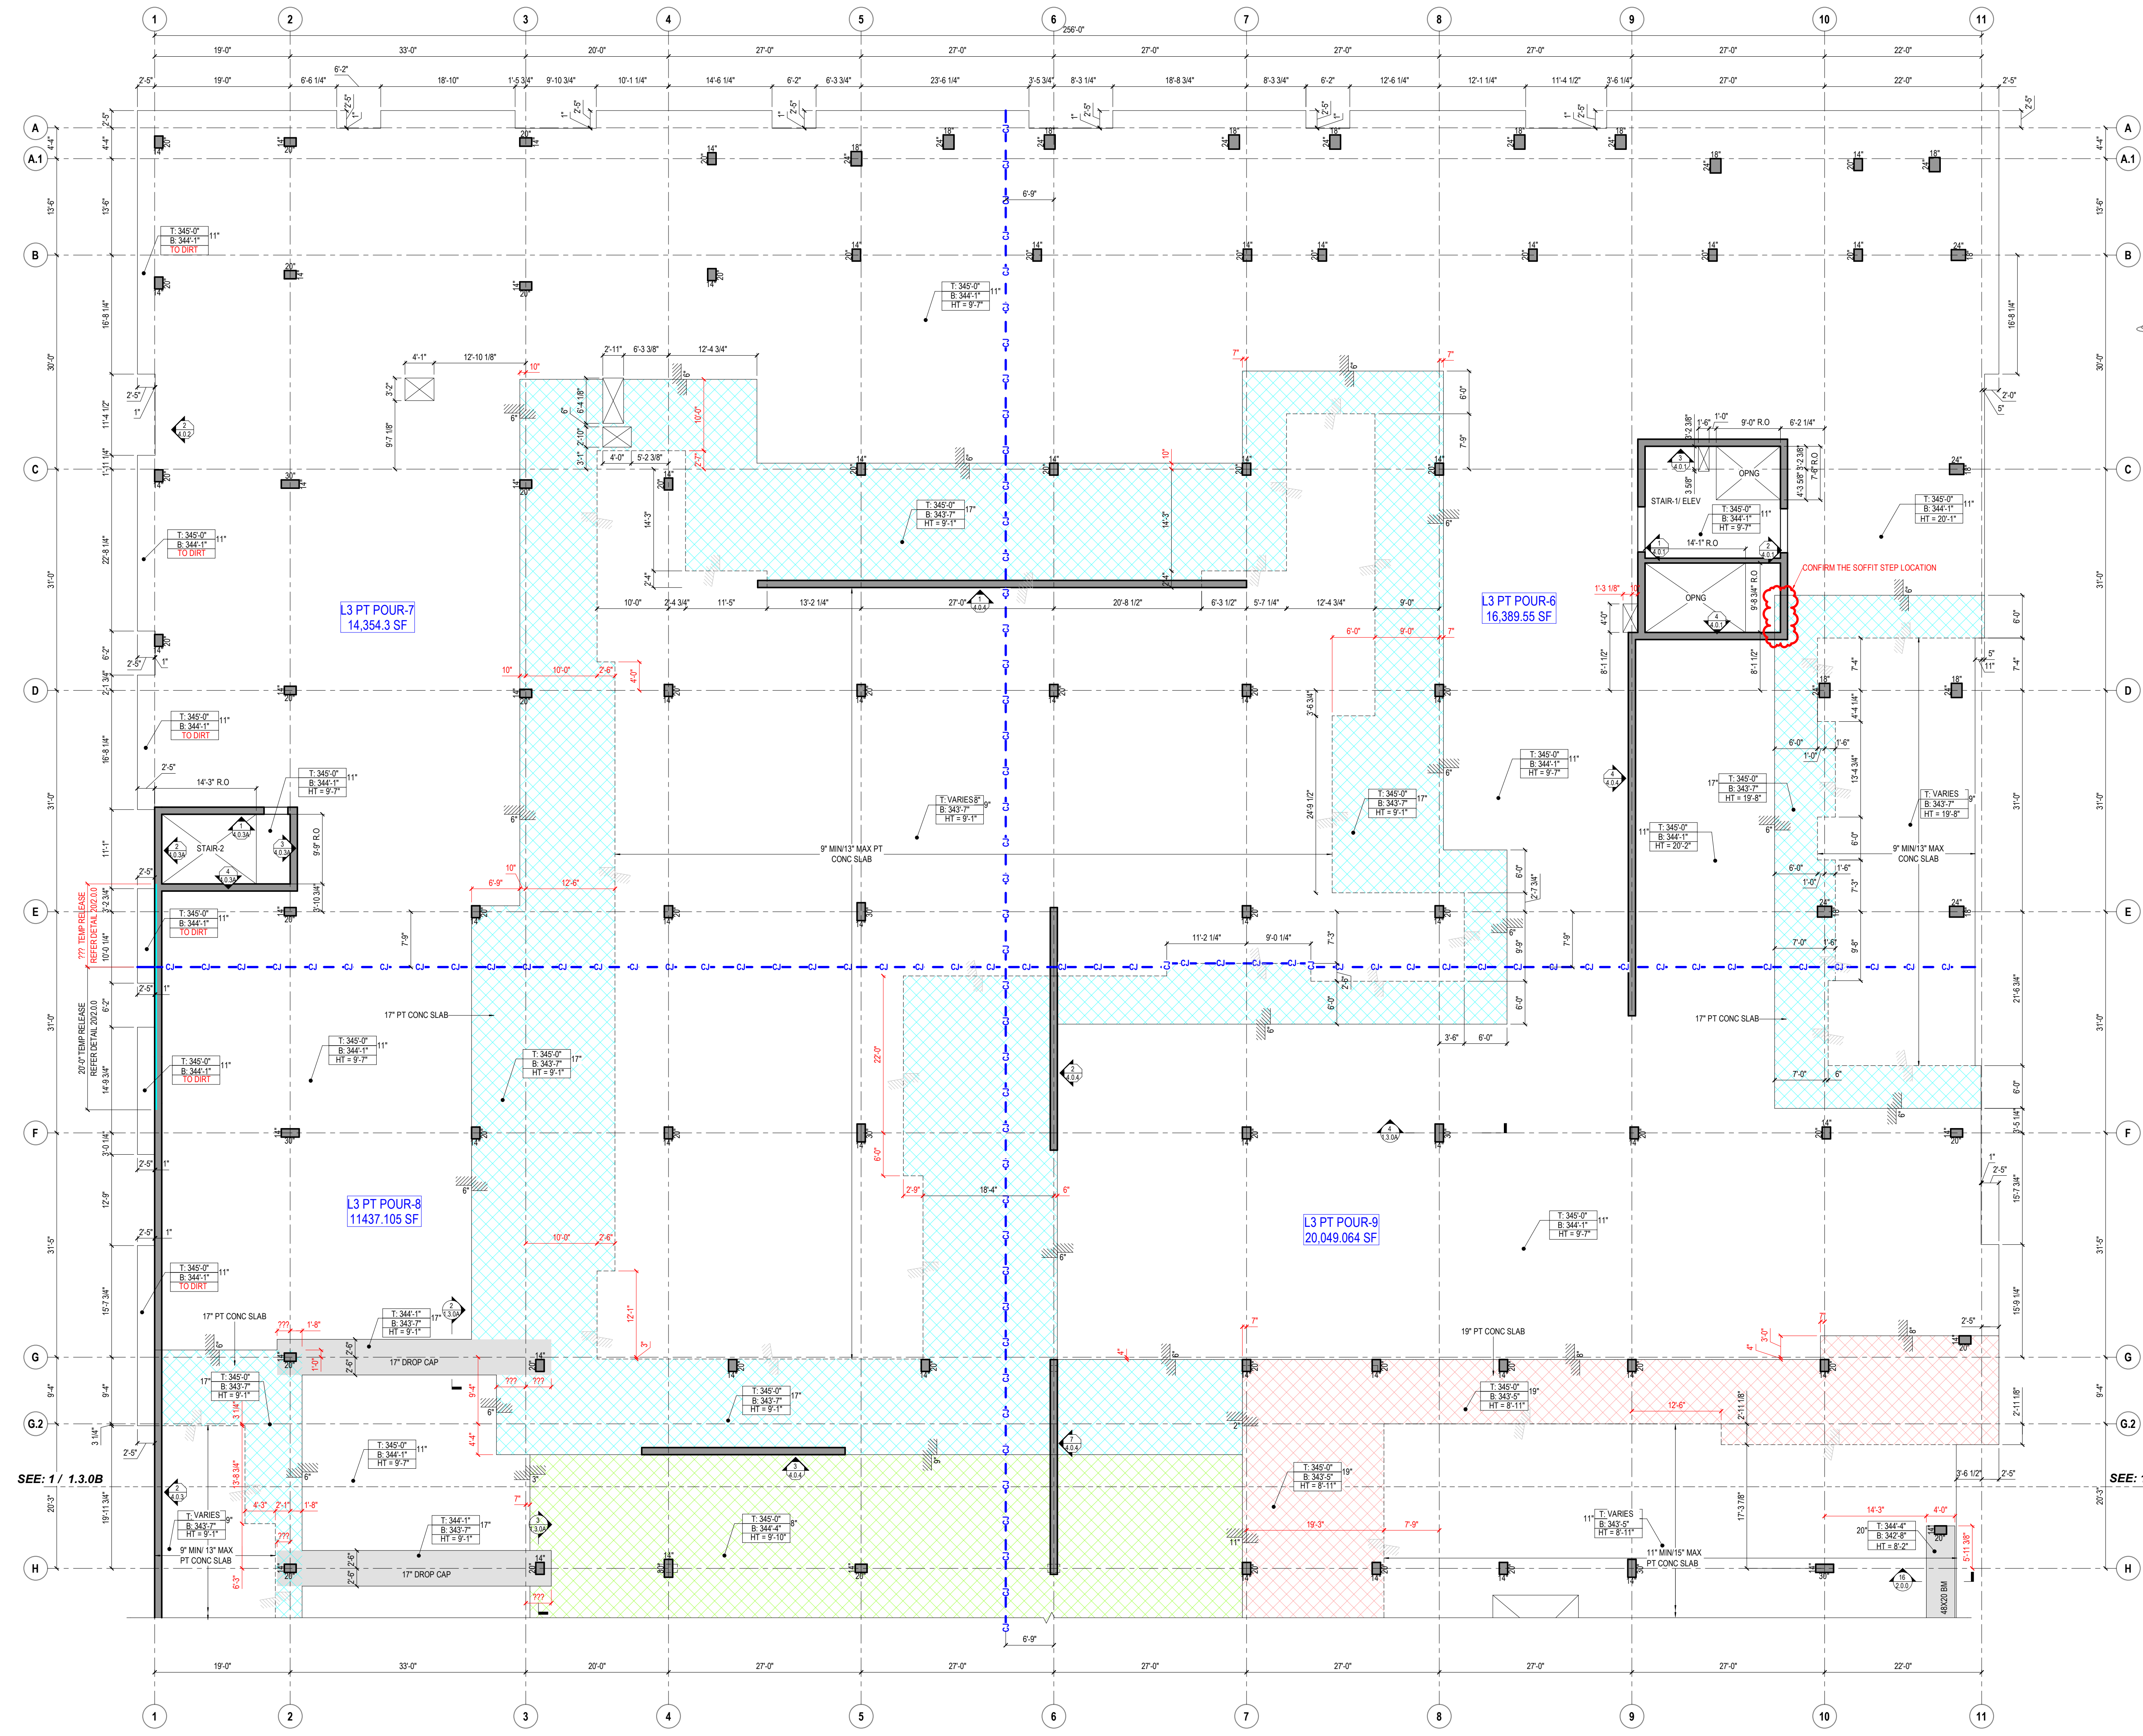


3D VIEW LEVEL-3

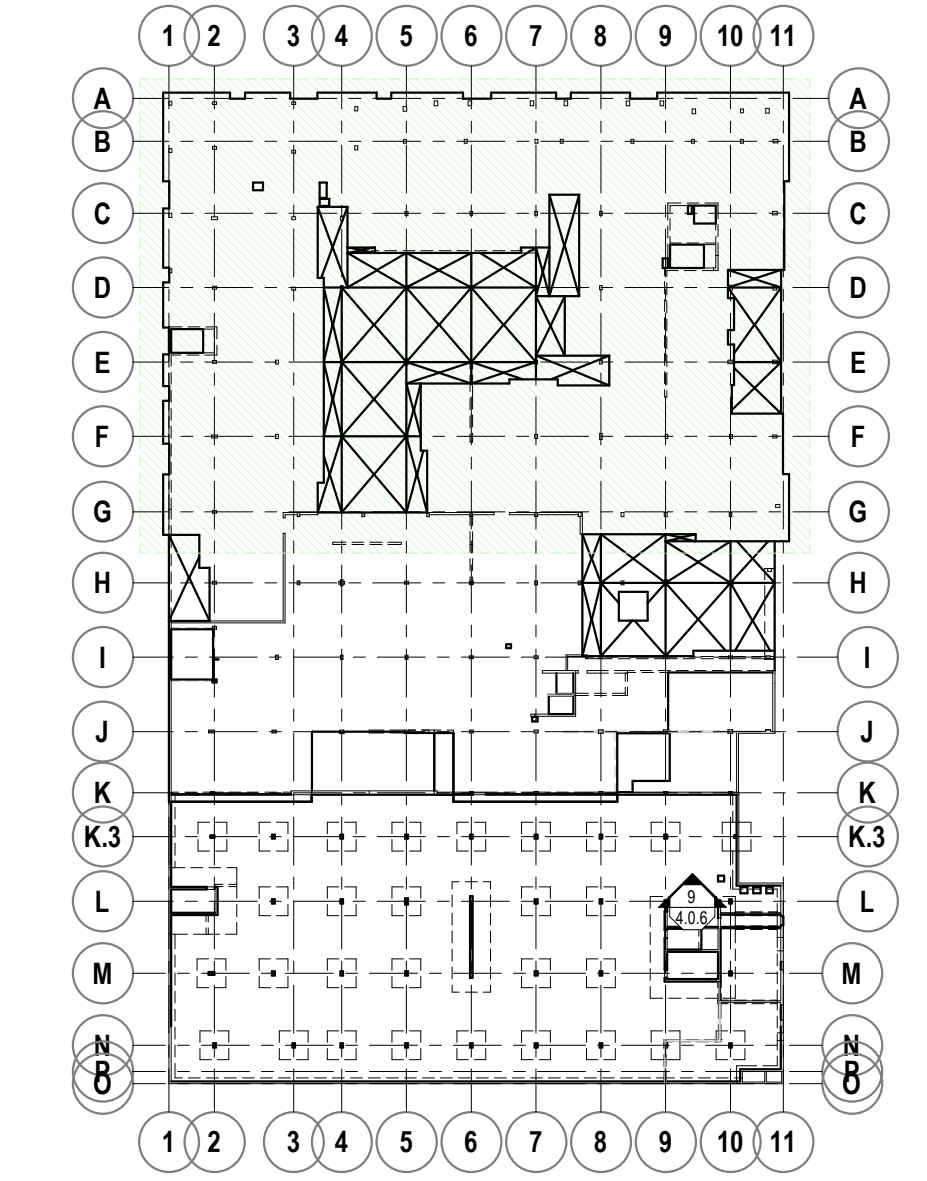

LEVEL-3 KEY PLAN NORTH

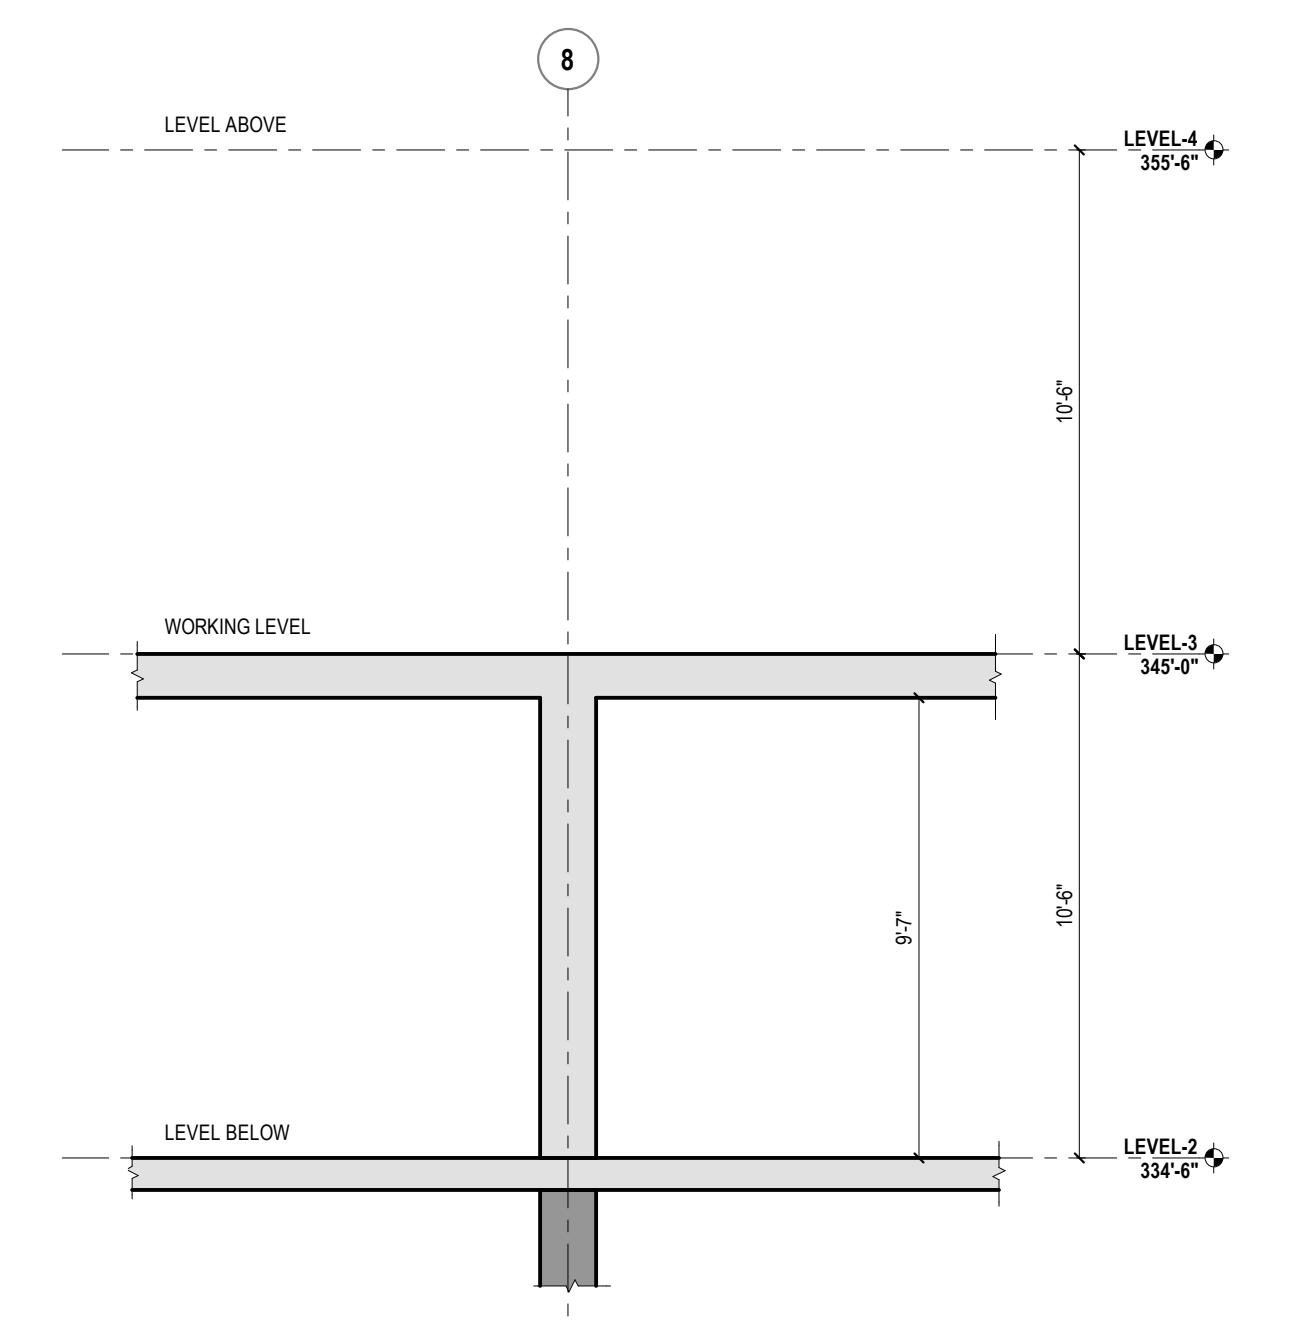

BUILDING SECTION LEVEL-3

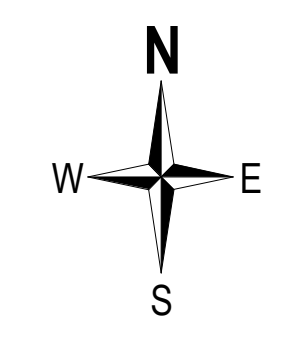

NOTES:


- 3/4" CHAMFER ON ALL EXPOSED CONCRETE CORNERS TYP.
- ALL COLUMNS ARE CENTERED ON GRID LINES U.N.O.
- ALL BEAMS ARE CENTERED ON GRID LINES U.N.O.
- SLAB THICKNESS IS 11" TYP. U.N.O.
- LEVEL 3 ELEVATION = 345'-0"

LEGEND


SYMBOLS		SHAPE DESIGNATIONS	
1-BLOCK (ROUND ENDS)	TOP OF CONCRETE ELEVATIONS	BEAM OR DROP CAP	
1-BLOCK (PLAN VIEWS)	TOP & BOTTOM ELEVATIONS	WALLS OR COLUMNS	
2-BLOCK (SOFFIT PLANS)	TOP & BOTTOM ELEVATIONS	CHU WALLS	
3-BLOCK (SOFFIT PLANS)	TOP & BOTTOM ELEVATIONS	DELAY STRIP OR CLOSURE POUR	
4-BLOCK (SOFFIT PLANS)	TOP & BOTTOM ELEVATIONS	GRADE OR SOIL	
5-BLOCK (SOFFIT PLANS)	TOP & BOTTOM ELEVATIONS	1" PTMS/CP SLAB	
6-BLOCK (SOFFIT PLANS)	TOP & BOTTOM ELEVATIONS	2" PTMS/CP SLAB	
7-BLOCK (SOFFIT PLANS)	TOP & BOTTOM ELEVATIONS	LINE DESIGNATIONS	
8-BLOCK (SOFFIT PLANS)	TOP & BOTTOM ELEVATIONS	INDICATES TOP OF SLAB CHANGE OR EDGE OF SLAB	
9-BLOCK (SOFFIT PLANS)	TOP & BOTTOM ELEVATIONS	INDICATES SOFFIT CHANGE	
10-BLOCK (SOFFIT PLANS)	TOP & BOTTOM ELEVATIONS	INDICATES CONSTRUCTION JOINT	
11-BLOCK (SOFFIT PLANS)	TOP & BOTTOM ELEVATIONS	INDICATES GRID LINE	

PLEASE PROVIDE / VERIFY THE INFORMATION IN RED

1 LEVEL-3 (SOFFIT PLAN) - NORTH

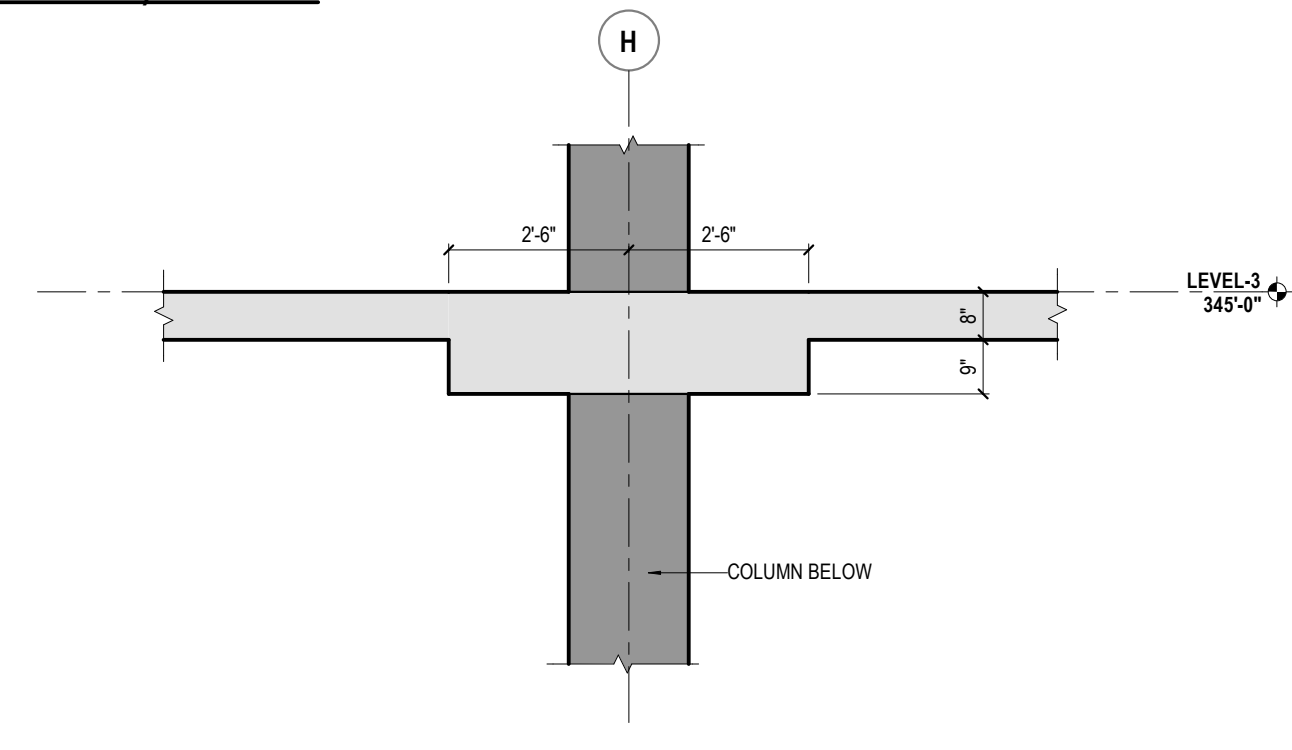

3 SECTION AT DROP CAP SOFFIT STEP

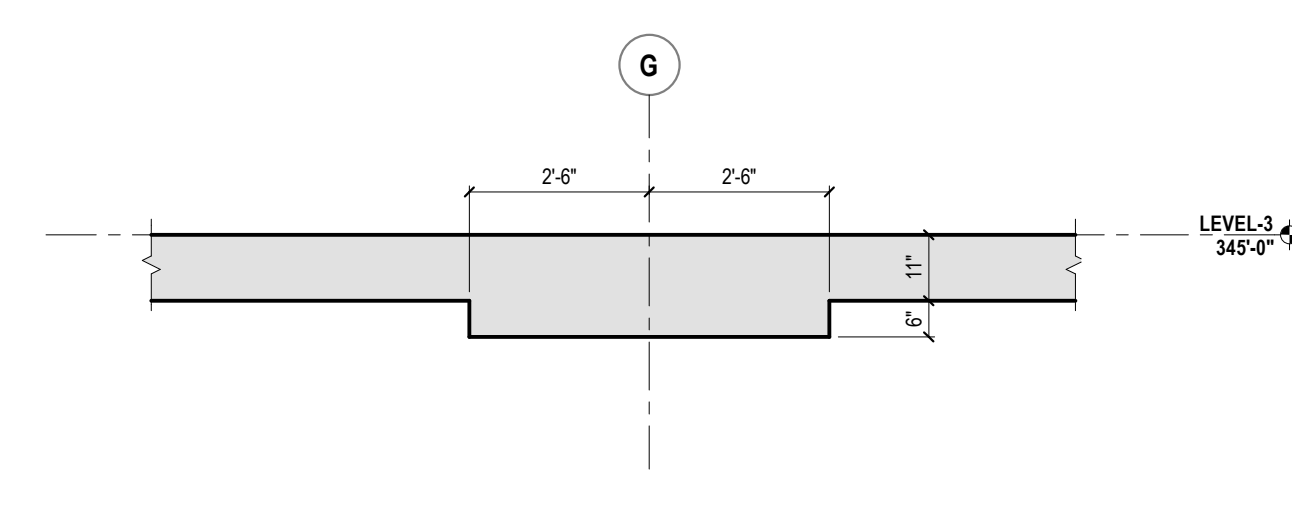

2 SECTION AT DROP CAP




1 LEVEL-3 (SOFFIT PLAN) - SOUTH



1. 3/4" CHAMFER ON ALL EXPOSED CONCRETE CORNERS TYP.
2. ALL COLUMNS ARE CENTERED ON GRID LINES U.N.O.
3. ALL BEAMS ARE CENTERED ON GRID LINES U.N.O.
4. SLAB THICKNESS IS 11" TYP. U.N.O.
5. LEVEL 3 ELEVATION = 345'-0"


EL-3 (SOFFIT PLAN) - SOUTH
KINECT @ GRESHAM
1010 NW 12TH ST GRESHAM, OR 97030

THIS DRAWING IS FOR THE EXCLUSIVE USE OF MCCLONE CONSTRUCTION COMPANY. ON THIS PROJECT ONLY. UTILIZATION OF THIS DRAWING BY OTHER PARTIES AND/OR ON OTHER PROJECTS WITHOUT THE EXPRESSED WRITTEN CONSENT OF MCCLONE CONSTRUCTION COMPANY IS STRICTLY PROHIBITED.

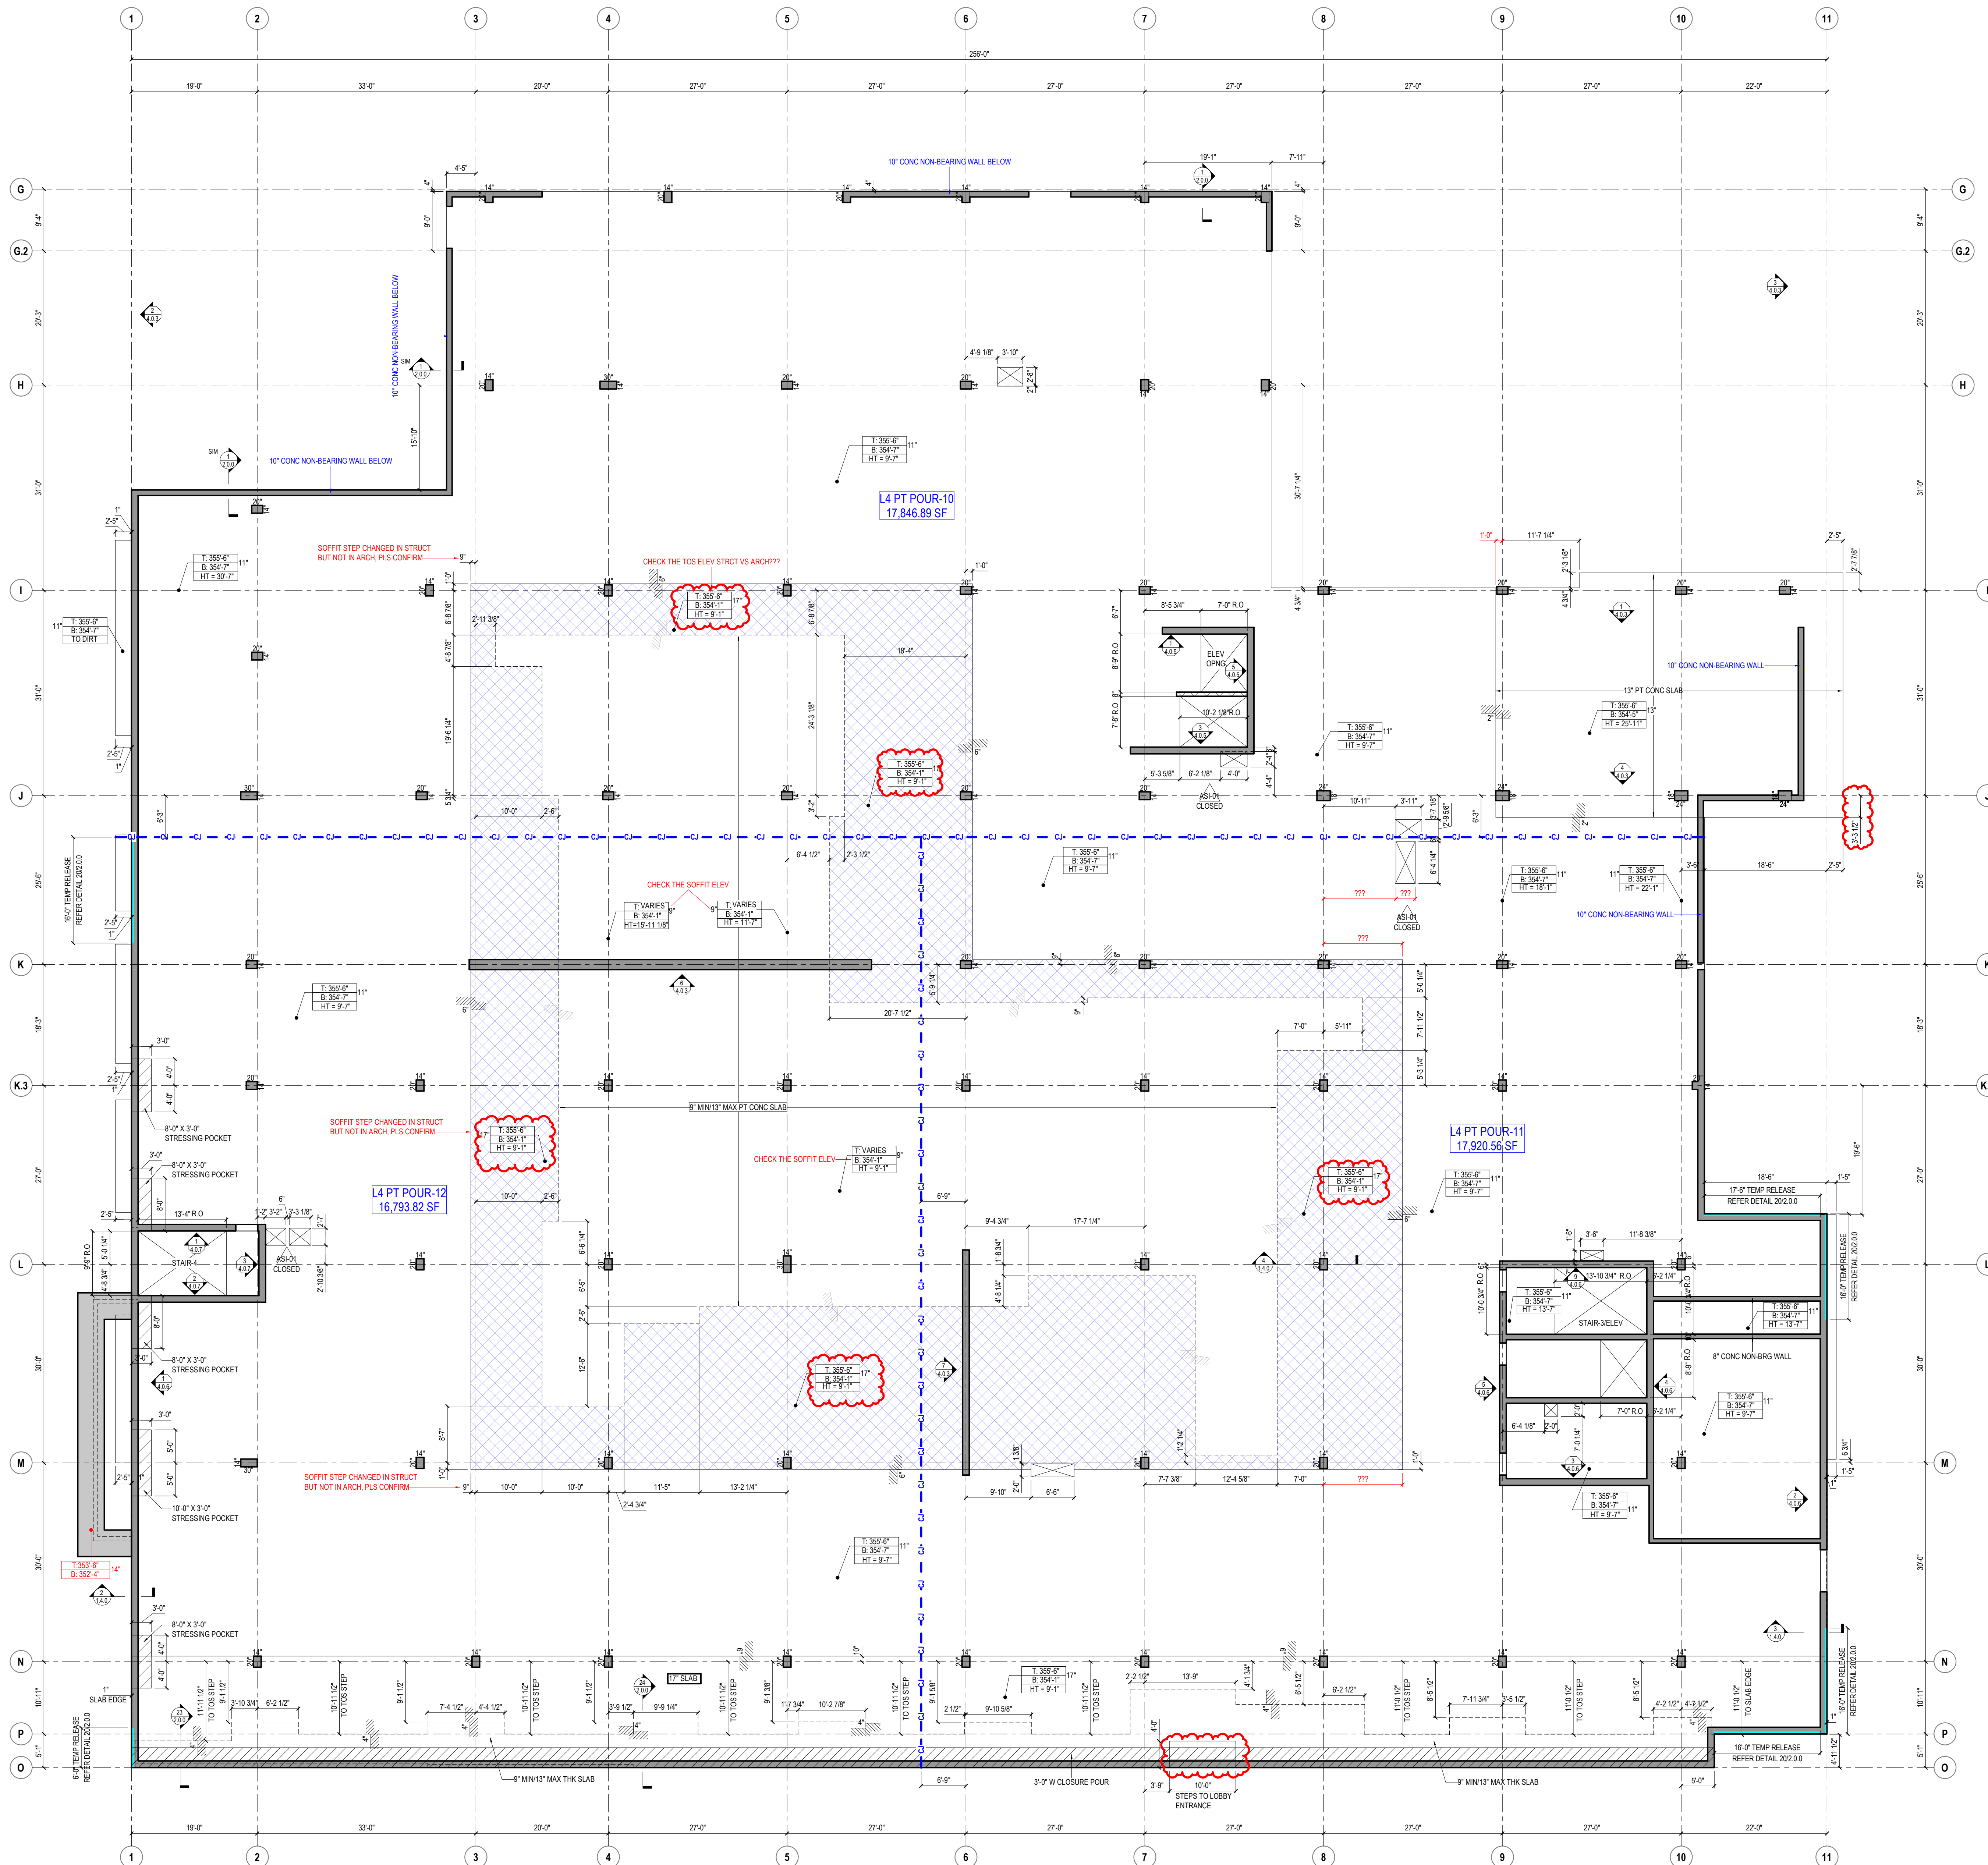


1 LEVEL-4 (SOFFIT PLAN) - SOUTH


PLEASE PROVIDE / VERIFY THE INFORMATION IN RED

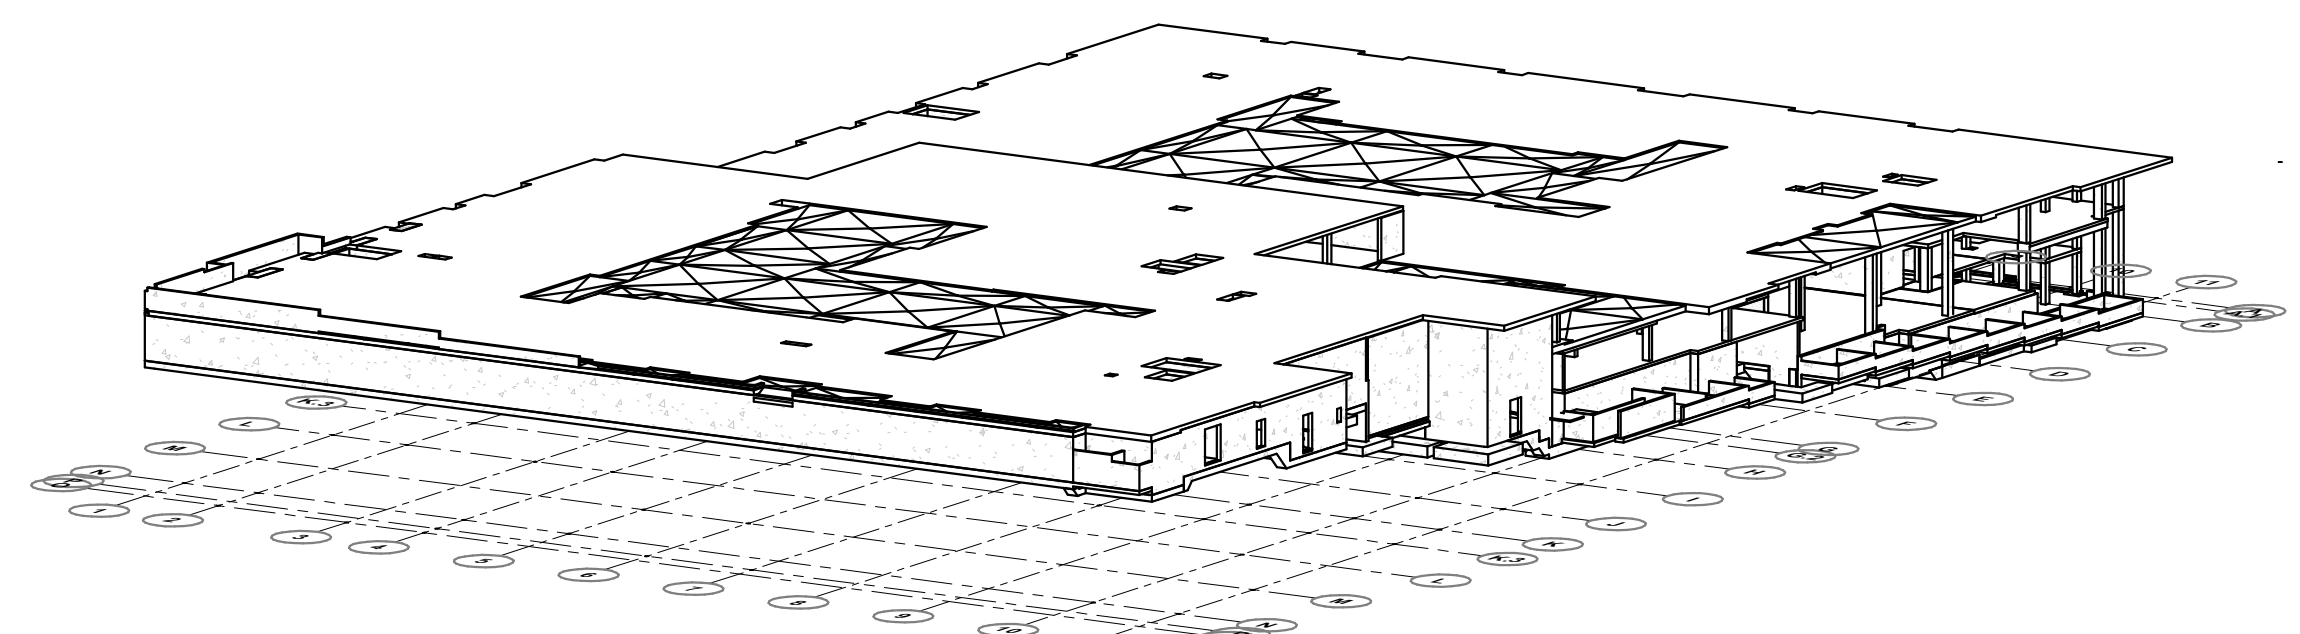


3D VIEW LEVEL-4

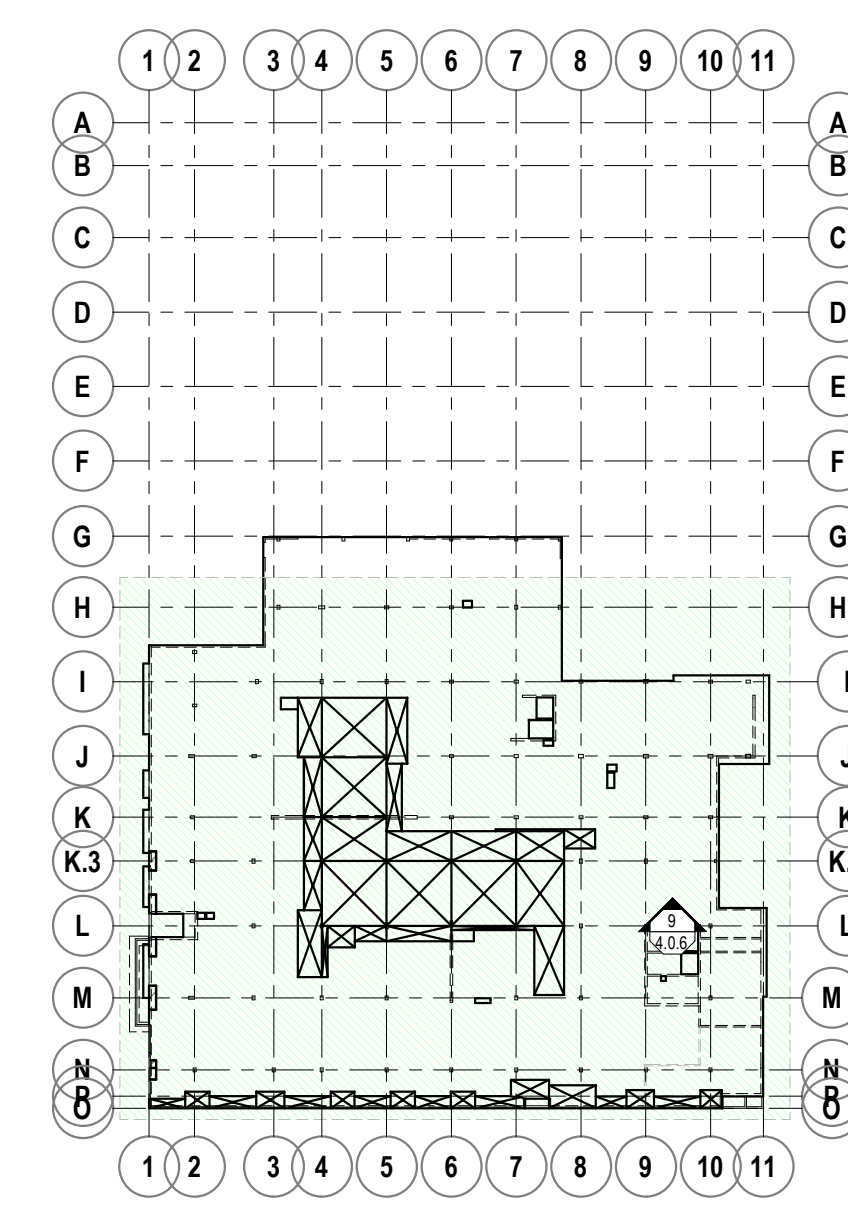

LEVEL-4 KEY PLAN SOUTH

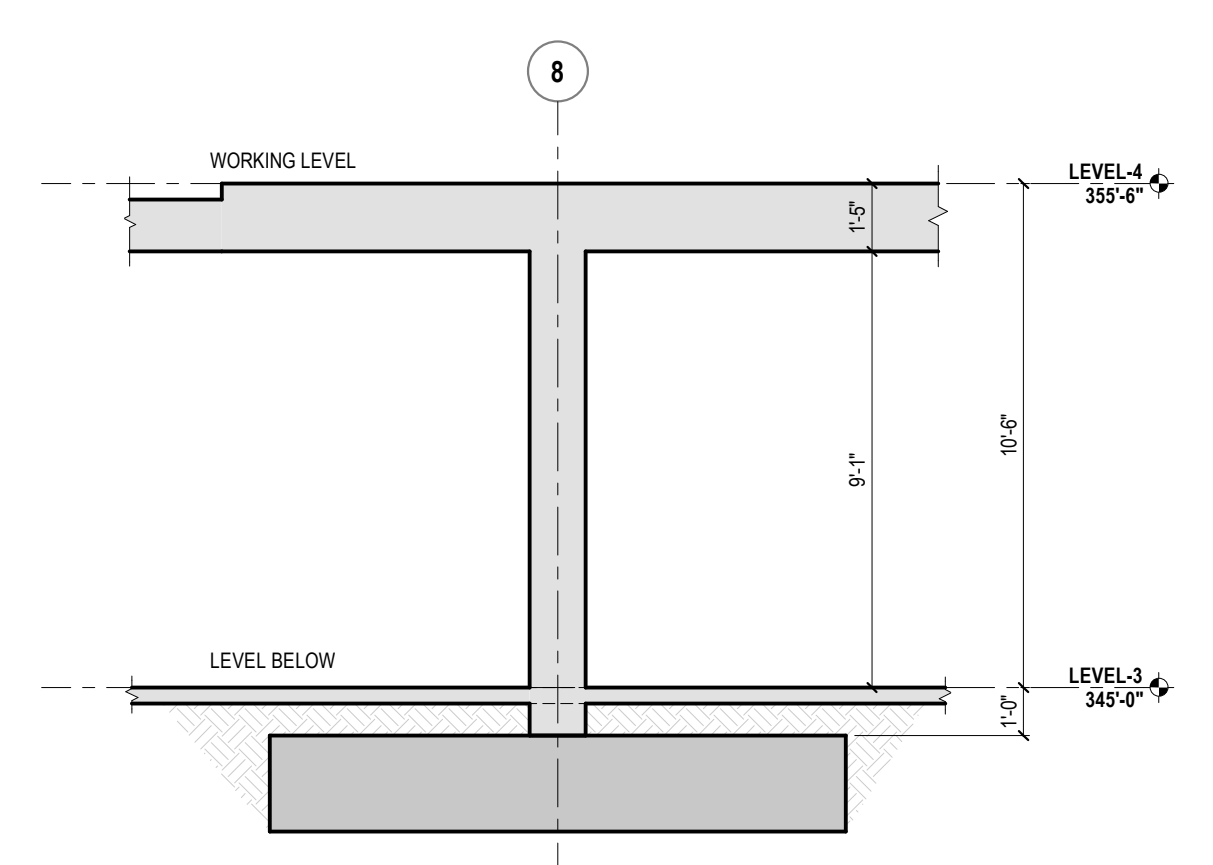

4 BUILDING SECTION LEVEL-4

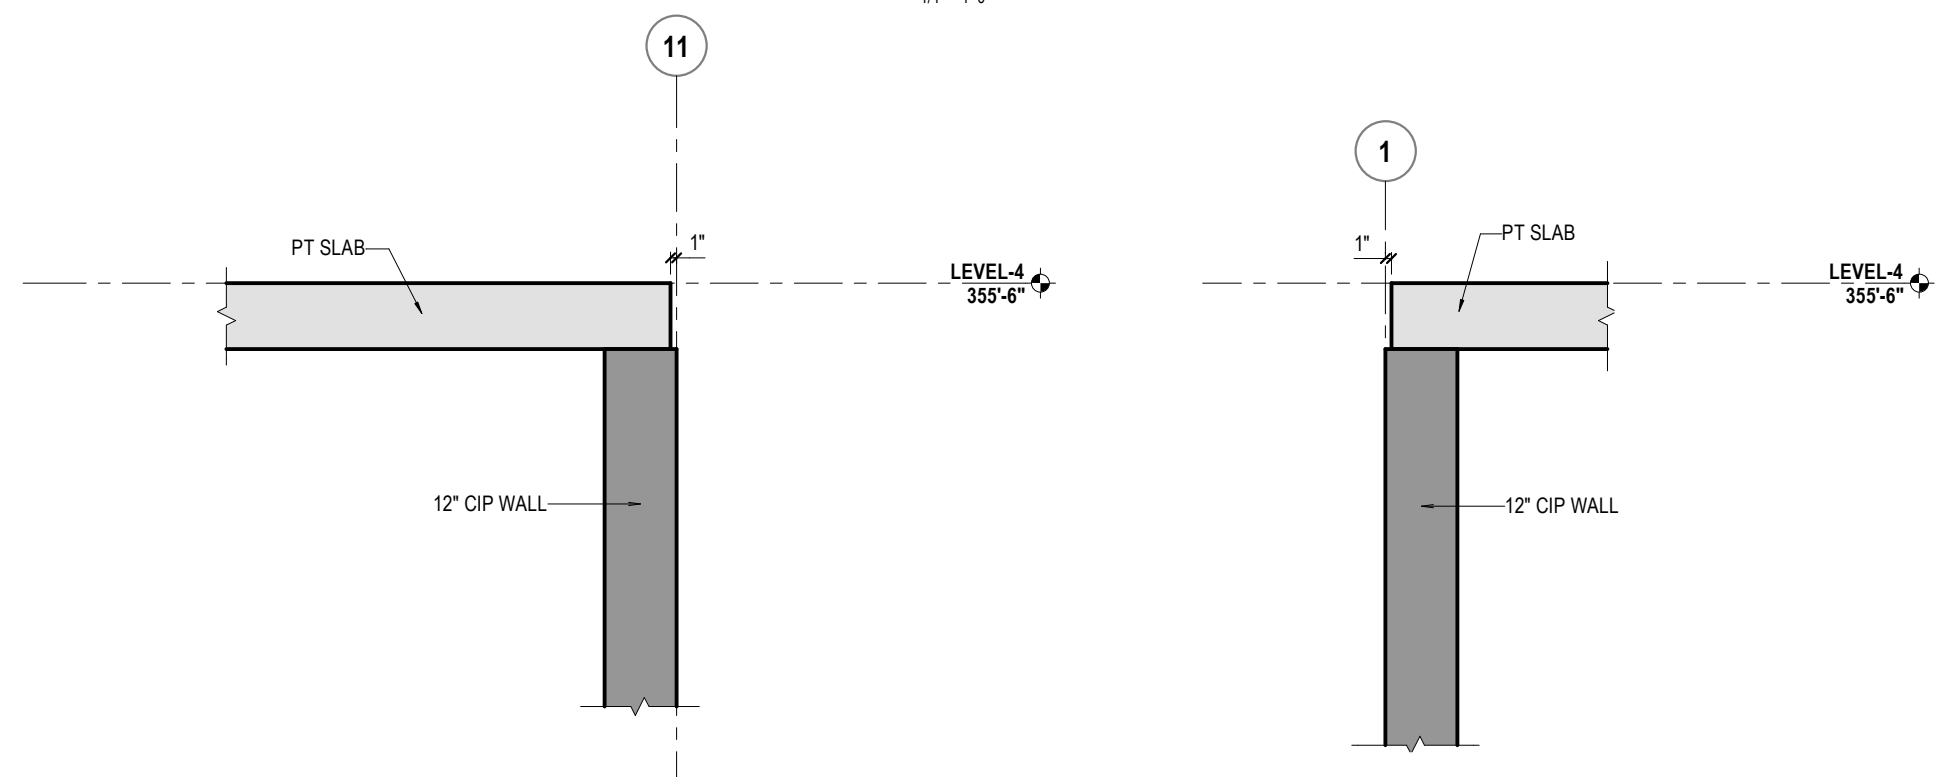

3 SLAB EDGE AT GL-11

2 SECTION AT SLAB EDGE

NOTES:

- 3/4\"/>
- ALL COLUMNS ARE CENTERED ON GRID LINES UNLESS NOTED OTHERWISE.
- ALL BEAMS ARE CENTERED ON GRID LINES UNLESS NOTED OTHERWISE.
- SLAB THICKNESS IS 11\"/>
- LEVEL 3 ELEVATION IS 355'-6\"/>

LEGEND

SYMBOLS	SHAPE DESIGNATIONS
1-BOX (ROUND ENDS) TOP OF CONCRETE ELEVATIONS	BEAM OR DROP CAP
1-BOX BOTTOM OF CONCRETE ELEVATIONS	WALLS OR COLUMNS
2-BOX (SOFFIT PLANS) TOP & BOTTOM ELEVATIONS	CONC WALLS
2-BOX (SOFFIT PLANS) TOP & BOTTOM ELEVATIONS	DELAY STRIP OR CLOSURE POUR
2-BOX (SOFFIT PLANS) TOP & BOTTOM ELEVATIONS	GRADE OR SOIL
2-BOX (SOFFIT PLANS) TOP & BOTTOM ELEVATIONS	1\"/>
2-BOX (SOFFIT PLANS) TOP & BOTTOM ELEVATIONS	2\"/>

SECTION VIEW	ELEVATION VIEW
1-BOX (ROUND ENDS) TOP OF CONCRETE ELEVATIONS	1-BOX (ROUND ENDS) TOP OF CONCRETE ELEVATIONS
1-BOX BOTTOM OF CONCRETE ELEVATIONS	1-BOX BOTTOM OF CONCRETE ELEVATIONS
2-BOX (SOFFIT PLANS) TOP & BOTTOM ELEVATIONS	2-BOX (SOFFIT PLANS) TOP & BOTTOM ELEVATIONS
2-BOX (SOFFIT PLANS) TOP & BOTTOM ELEVATIONS	2-BOX (SOFFIT PLANS) TOP & BOTTOM ELEVATIONS

LINE DESIGNATIONS
--- INDICATES TOP OF SLAB CHANGE OR EDGE OF SLAB
--- INDICATES SOFFIT CHANGE
--- INDICATES CONSTRUCTION JOINT
--- INDICATES GRID LINE

McCLONE
CONSTRUCTION
SINCE 1975
2860 MAPLE VALLEY BLVD. SUITE 200
MAPLE VALLEY, WA 98043-4254

LEVEL-4 (SOFFIT PLAN) - SOUTH
KINETIC @ GRESHAM
1010 NW 12TH ST GRESHAM, OR 97030

DATE: 08/05/2026
DRAWN BY: YK
CHECKED BY: 1326
SCALE: 1/4\"/>