

[illegible]

KINECT @ GRESHAM

1010 NW 12TH ST
GRESHAM, OR 97030

DRAWN BY
 MH

CHECKED BY
 EP

DRAWING SET DATE
 APRIL 10, 2026


DRAWING SET TITLE
BID ADDENDUM #4

CITY OF GRESHAM PROJECT # 077531

SOUTHEAST CORNER OF SECTION 4,
 TOWNSHIP 1 SOUTH, RANGE 3

STRUCTURAL LOADING PLANS

\$0.20

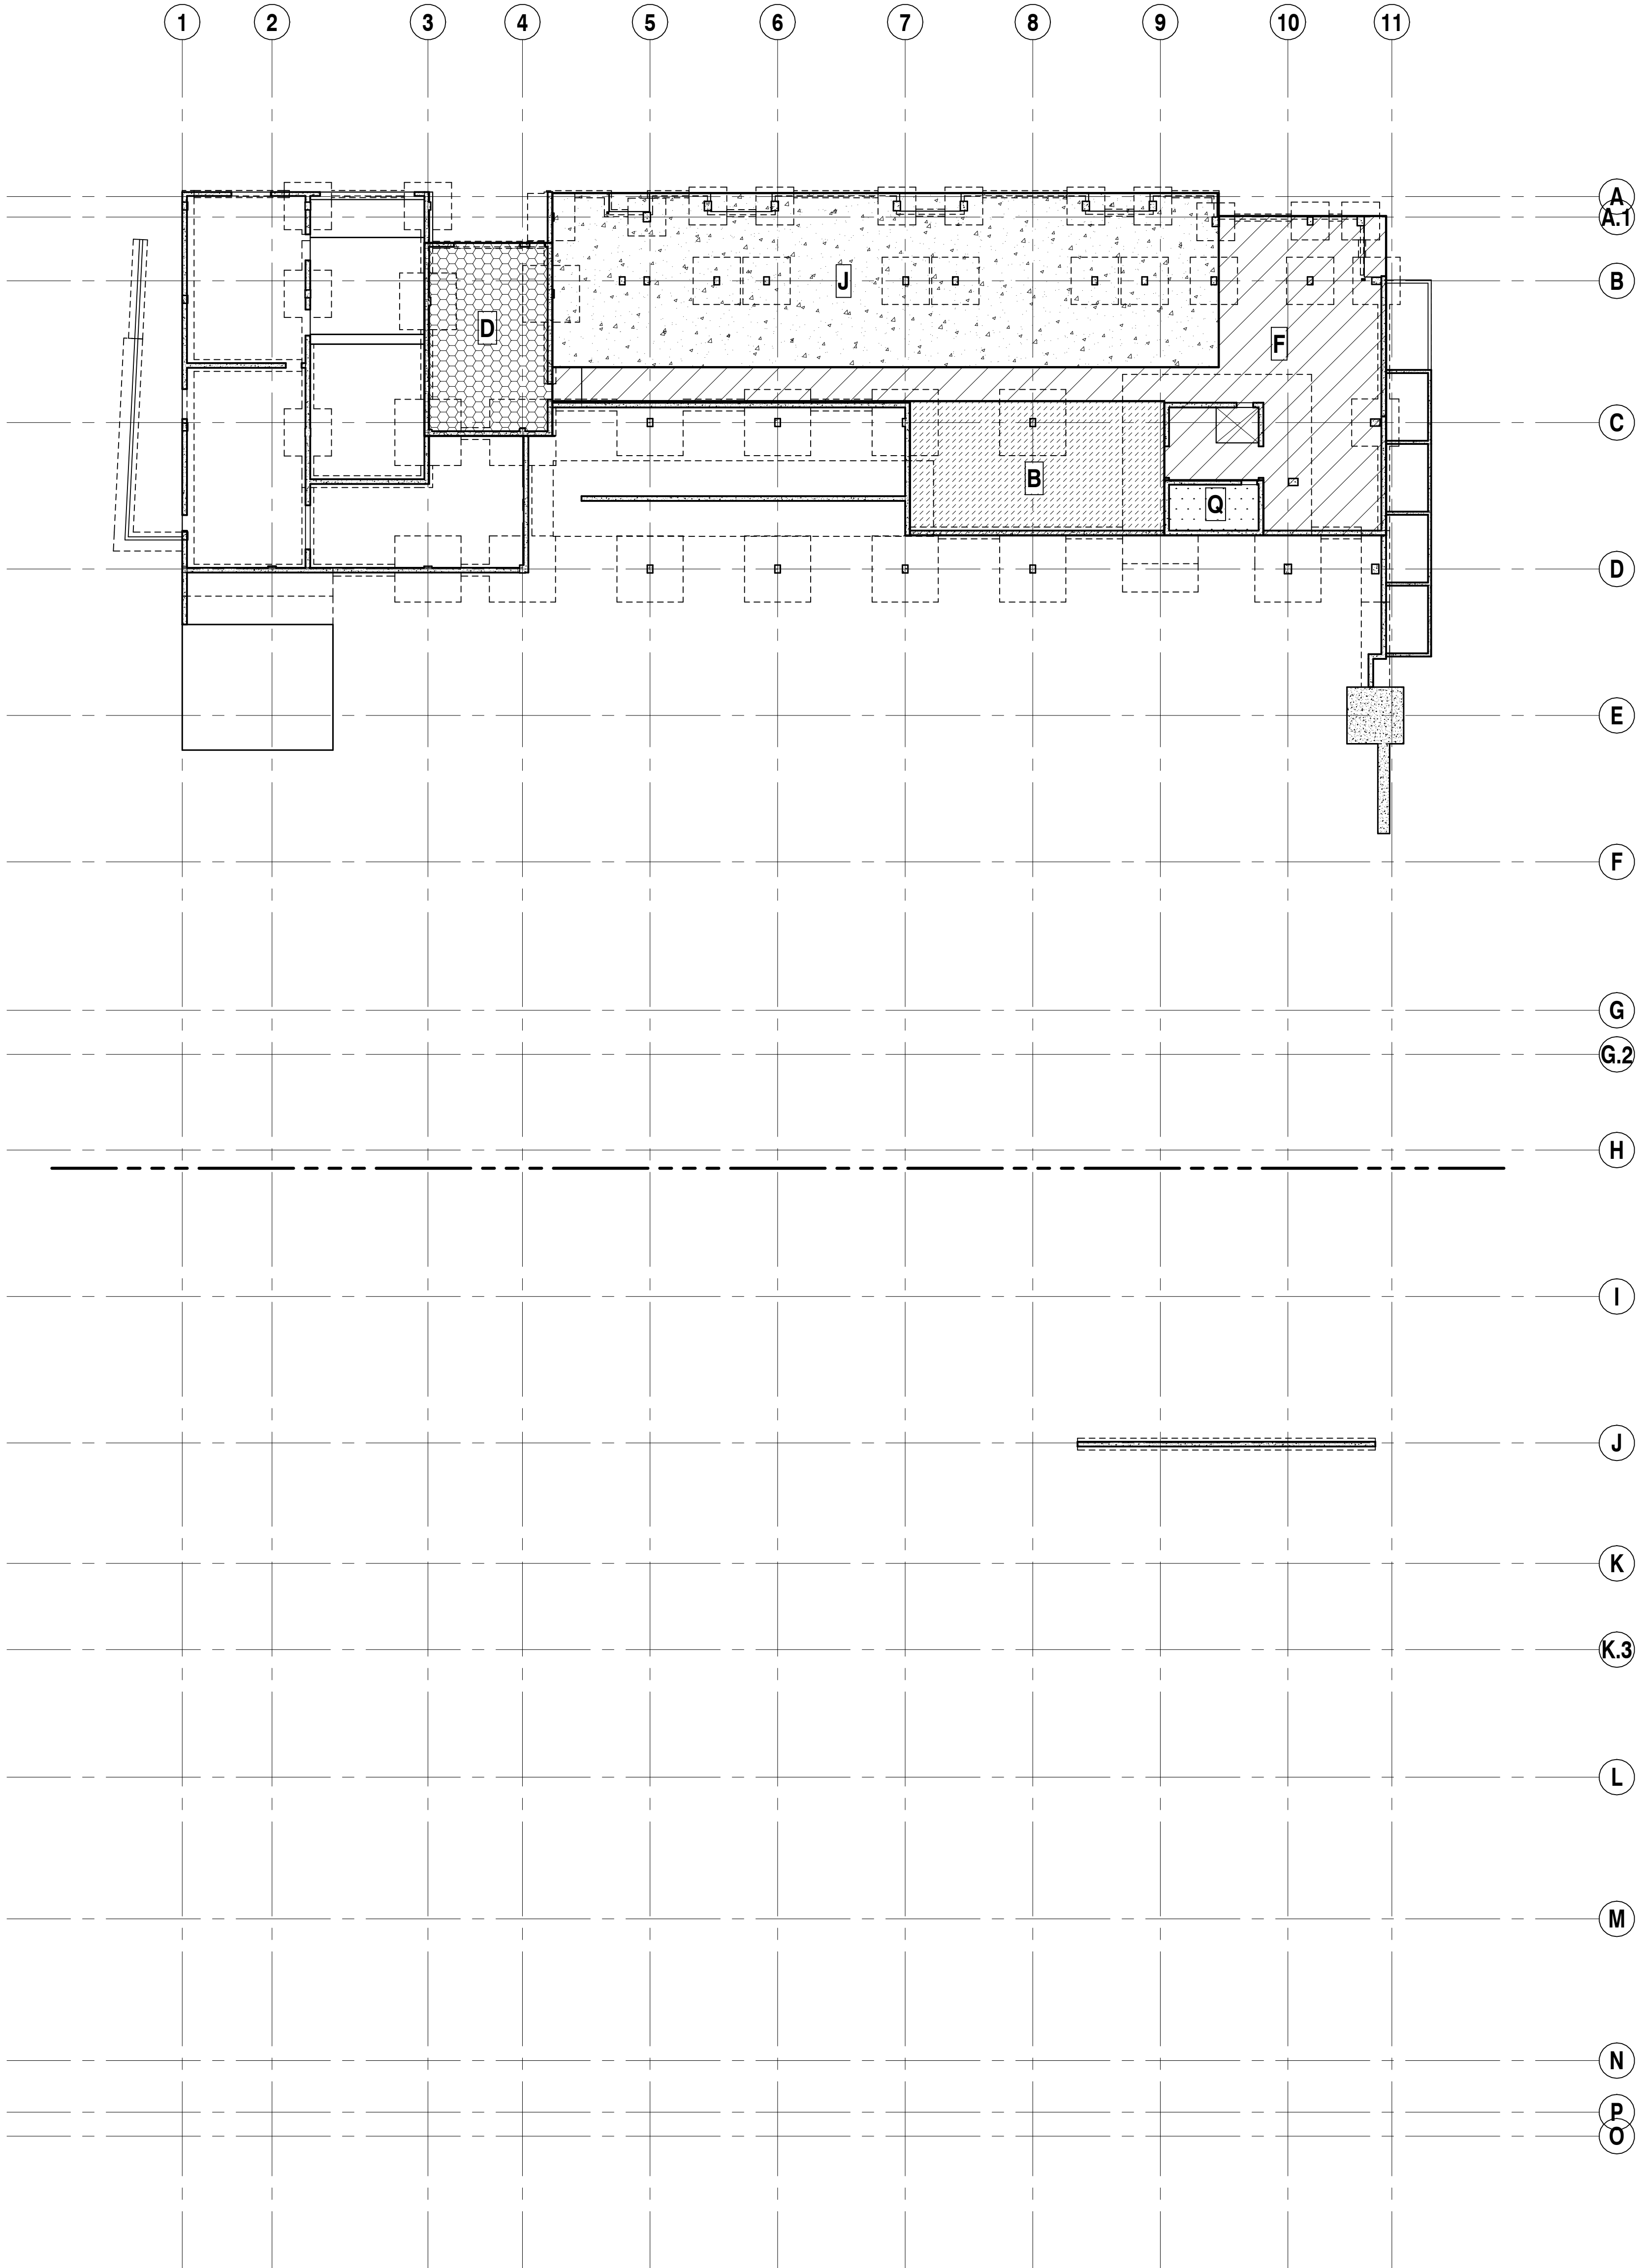


LOAD MAP LEGEND				
DESIGN LOAD LEGEND				
MARK / PATTERN	AREA	ADDED DEAD LOAD	LIVE LOAD	
A 	PARKING	5 PSF	40 PSF	
B 	MECHANICAL	40 PSF	40 PSF	
C 	STORAGE	10 PSF	125 PSF	
D 	TRASH ROOM	10 PSF	100 PSF	
E 	GENERATOR/ TRANSFORMER	150 PSF	20 PSF	
F 	RETAIL/ FITNESS/LOBBY	15 PSF	100 PSF	
G 	LEVEL 3 AND 4 LANDSCAPE	150 PSF	100 PSF	
H 	DETENTION VAULT	250 PSF	40 PSF	
J 	RESIDENTIAL	CONC = 10 PSF WOOD = 23 PSF	40 PSF	
K 	TERRACE	30 PSF	40 PSF	
L 	ROOF	17 PSF	25 PSF	
M 	MECHANICAL	35 PSF	25 PSF	
Q 	STAIRS/ CORRIDOR	15 PSF (STAIRS)	100 PSF	

LEVEL 1A LOADING PLAN
SCALE: 1" = 20'-0"




ALL RIGHTS RESERVED. REPRODUCTION OR TRANSLATION OF ANY PART OF THIS WORK WITHOUT WRITTEN PERMISSION OF AMERICAN CAPITAL GROUP IS UNLAWFUL AND SUBJECT TO CRIMINAL PROSECUTION.

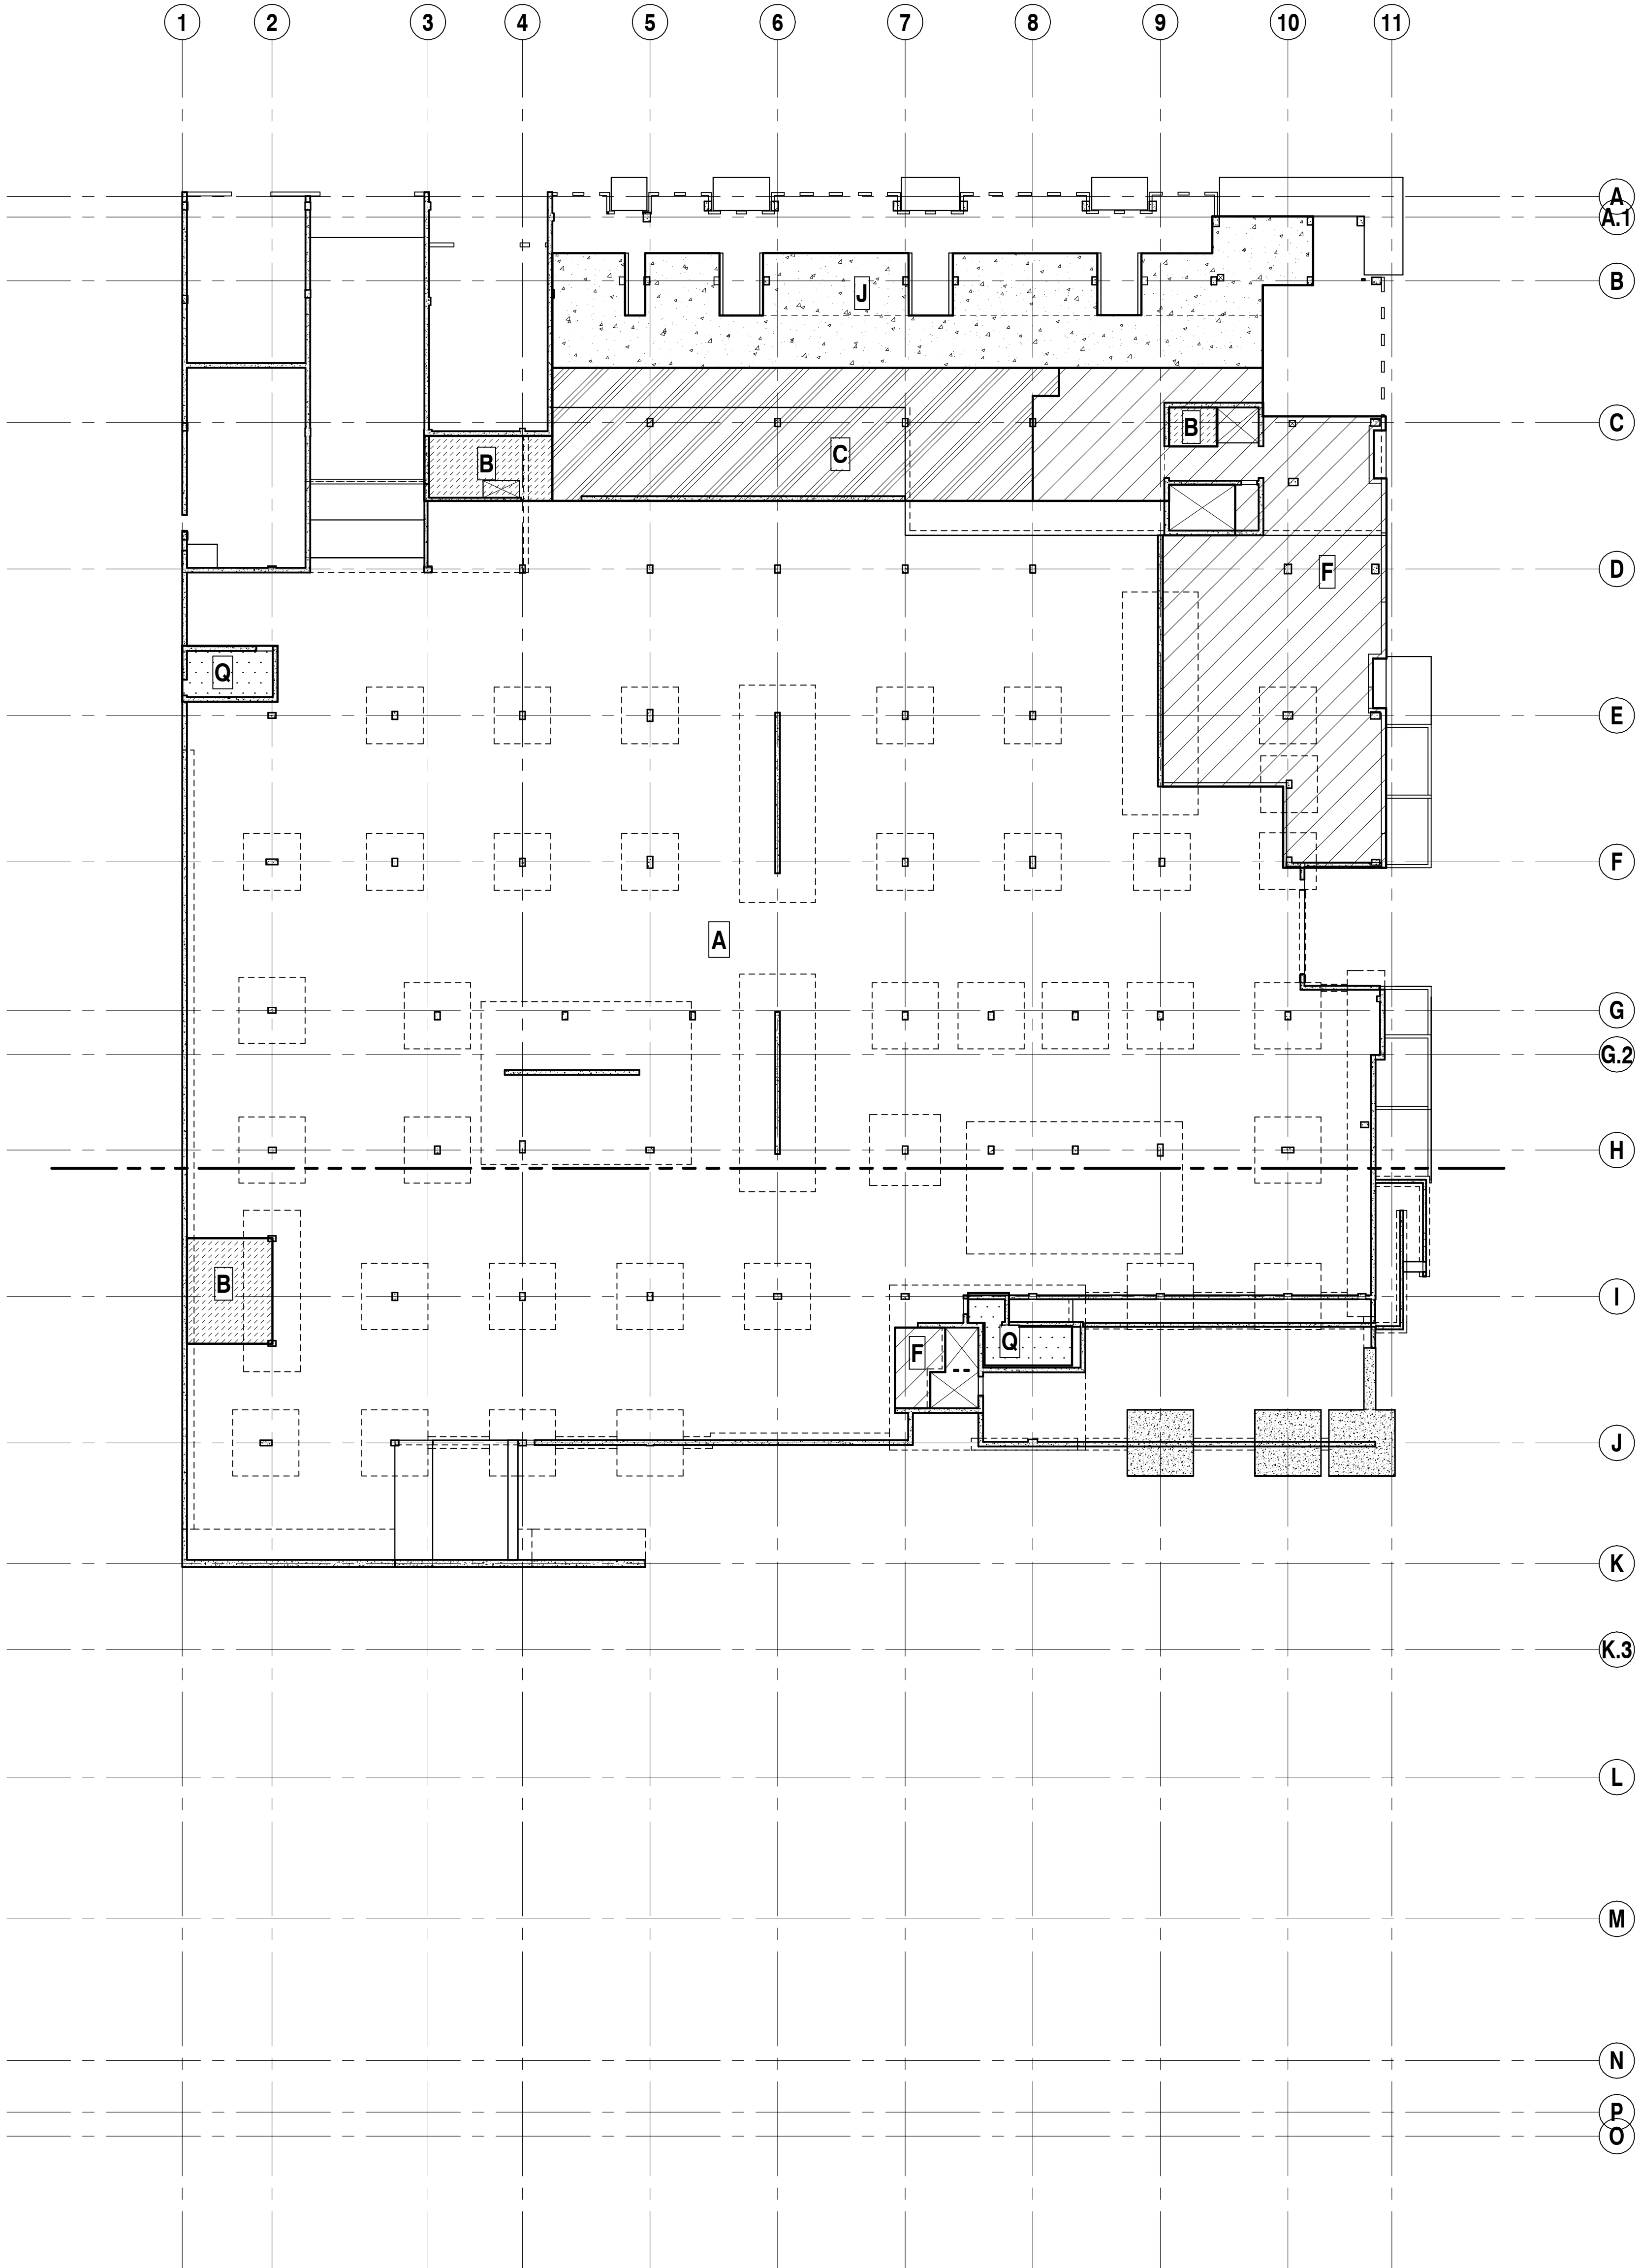

01601 LOAD MAP LEGEND			
DESIGN LOAD LEGEND			
MARK / PATTERN	AREA	ADDED DEAD LOAD	LIVE LOAD
A	PARKING	5 PSF	40 PSF
B	MECHANICAL	40 PSF	40 PSF
C	STORAGE	10 PSF	125 PSF
D	TRASH ROOM	10 PSF	100 PSF
E	GENERATOR/ TRANSFORMER	150 PSF	20 PSF
F	RETAIL/ FITNESS/LOBBY	15 PSF	100 PSF
G	LEVEL 3 AND 4 LANDSCAPE	150 PSF	100 PSF
H	DETENTION VAULT	250 PSF	40 PSF
J	RESIDENTIAL	CONC = 10 PSF WOOD = 23 PSF	40 PSF
K	TERRACE	30 PSF	40 PSF
L	ROOF	17 PSF	25 PSF
M	ROOF MECHANICAL	35 PSF	25 PSF
Q	STAIRS/ CORRIDOR	15 PSF (STAIRS)	100 PSF

LEVEL 1B LOADING PLAN

SCALE: 1" = 20'-0"

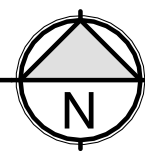

SUBMITTAL - REVISIONS		
NO.	DATE	DESCRIPTION
A1	11/29/2023	REVISION #1
B1	5/26/2024	REVISION #2
A2	5/26/2024	REVISION #3
A3	5/26/2024	REVISION #4
A4	5/26/2024	REVISION #5
A99	5/26/2024	REVISION #100

PROJECT
KINECT @ GRESHAM
1010 NW 12TH ST
GRESHAM, OR 97030

DRAWN BY
MH

CHECKED BY
EP

DRAWING SET DATE
APRIL 10, 2026

DRAWING SET TITLE
BID ADDENDUM #4

CITY OF GRESHAM PROJECT # 077031
SOUTHEAST CORNER OF SECTION 4,
TOWNSHIP 1 SOUTH, RANGE 3

TITLE
STRUCTURAL LOADING
PLANS

S0.21

[illegible]

KINECT @ GRESHAM

1010 NW 12TH ST
GRESHAM, OR 97030

DRAWN BY
 MH

CHECKED BY
 EP

DRAWING SET DATE
APRIL 10, 2026

BID ADDENDUM #4

SOUTHEAST CORNER OF SECTION 4,
TOWNSHIP 1 SOUTH, RANGE 3

STRUCTURAL LOADING PLANS


S0.22




LOAD MAP LEGEND			
DESIGN LOAD LEGEND			
MARK / PATTERN	AREA	ADDED DEAD LOAD	LIVE LOAD
A 	PARKING	5 PSF	40 PSF
B 	MECHANICAL	40 PSF	40 PSF
C 	STORAGE	10 PSF	125 PSF
D 	TRASH ROOM	10 PSF	100 PSF
E 	GENERATOR/ TRANSFORMER	150 PSF	20 PSF
F 	RETAIL/ FITNESS/LOBBY	15 PSF	100 PSF
G 	LEVEL 3 AND 4 LANDSCAPE	150 PSF	100 PSF
H 	DETENTION VAULT	250 PSF	40 PSF
J 	RESIDENTIAL	CONC = 10 PSF WOOD = 23 PSF	40 PSF
K 	TERRACE	30 PSF	40 PSF
L 	ROOF	17 PSF	25 PSF
M 	ROOF MECHANICAL	35 PSF	25 PSF
Q 	STAIRS/ CORRIDOR	15 PSF (STAIRS)	100 PSF

LEVEL 2 LOADING PLAN

SCALE: 1" = 20'-0"

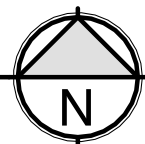


ALL RIGHTS RESERVED. REPRODUCTION OR TRANSLATION OF ANY PART OF THIS WORK WITHOUT WRITTEN PERMISSION OF AMERICAN CAPITAL GROUP IS UNLAWFUL AND SUBJECT TO CRIMINAL PROSECUTION.

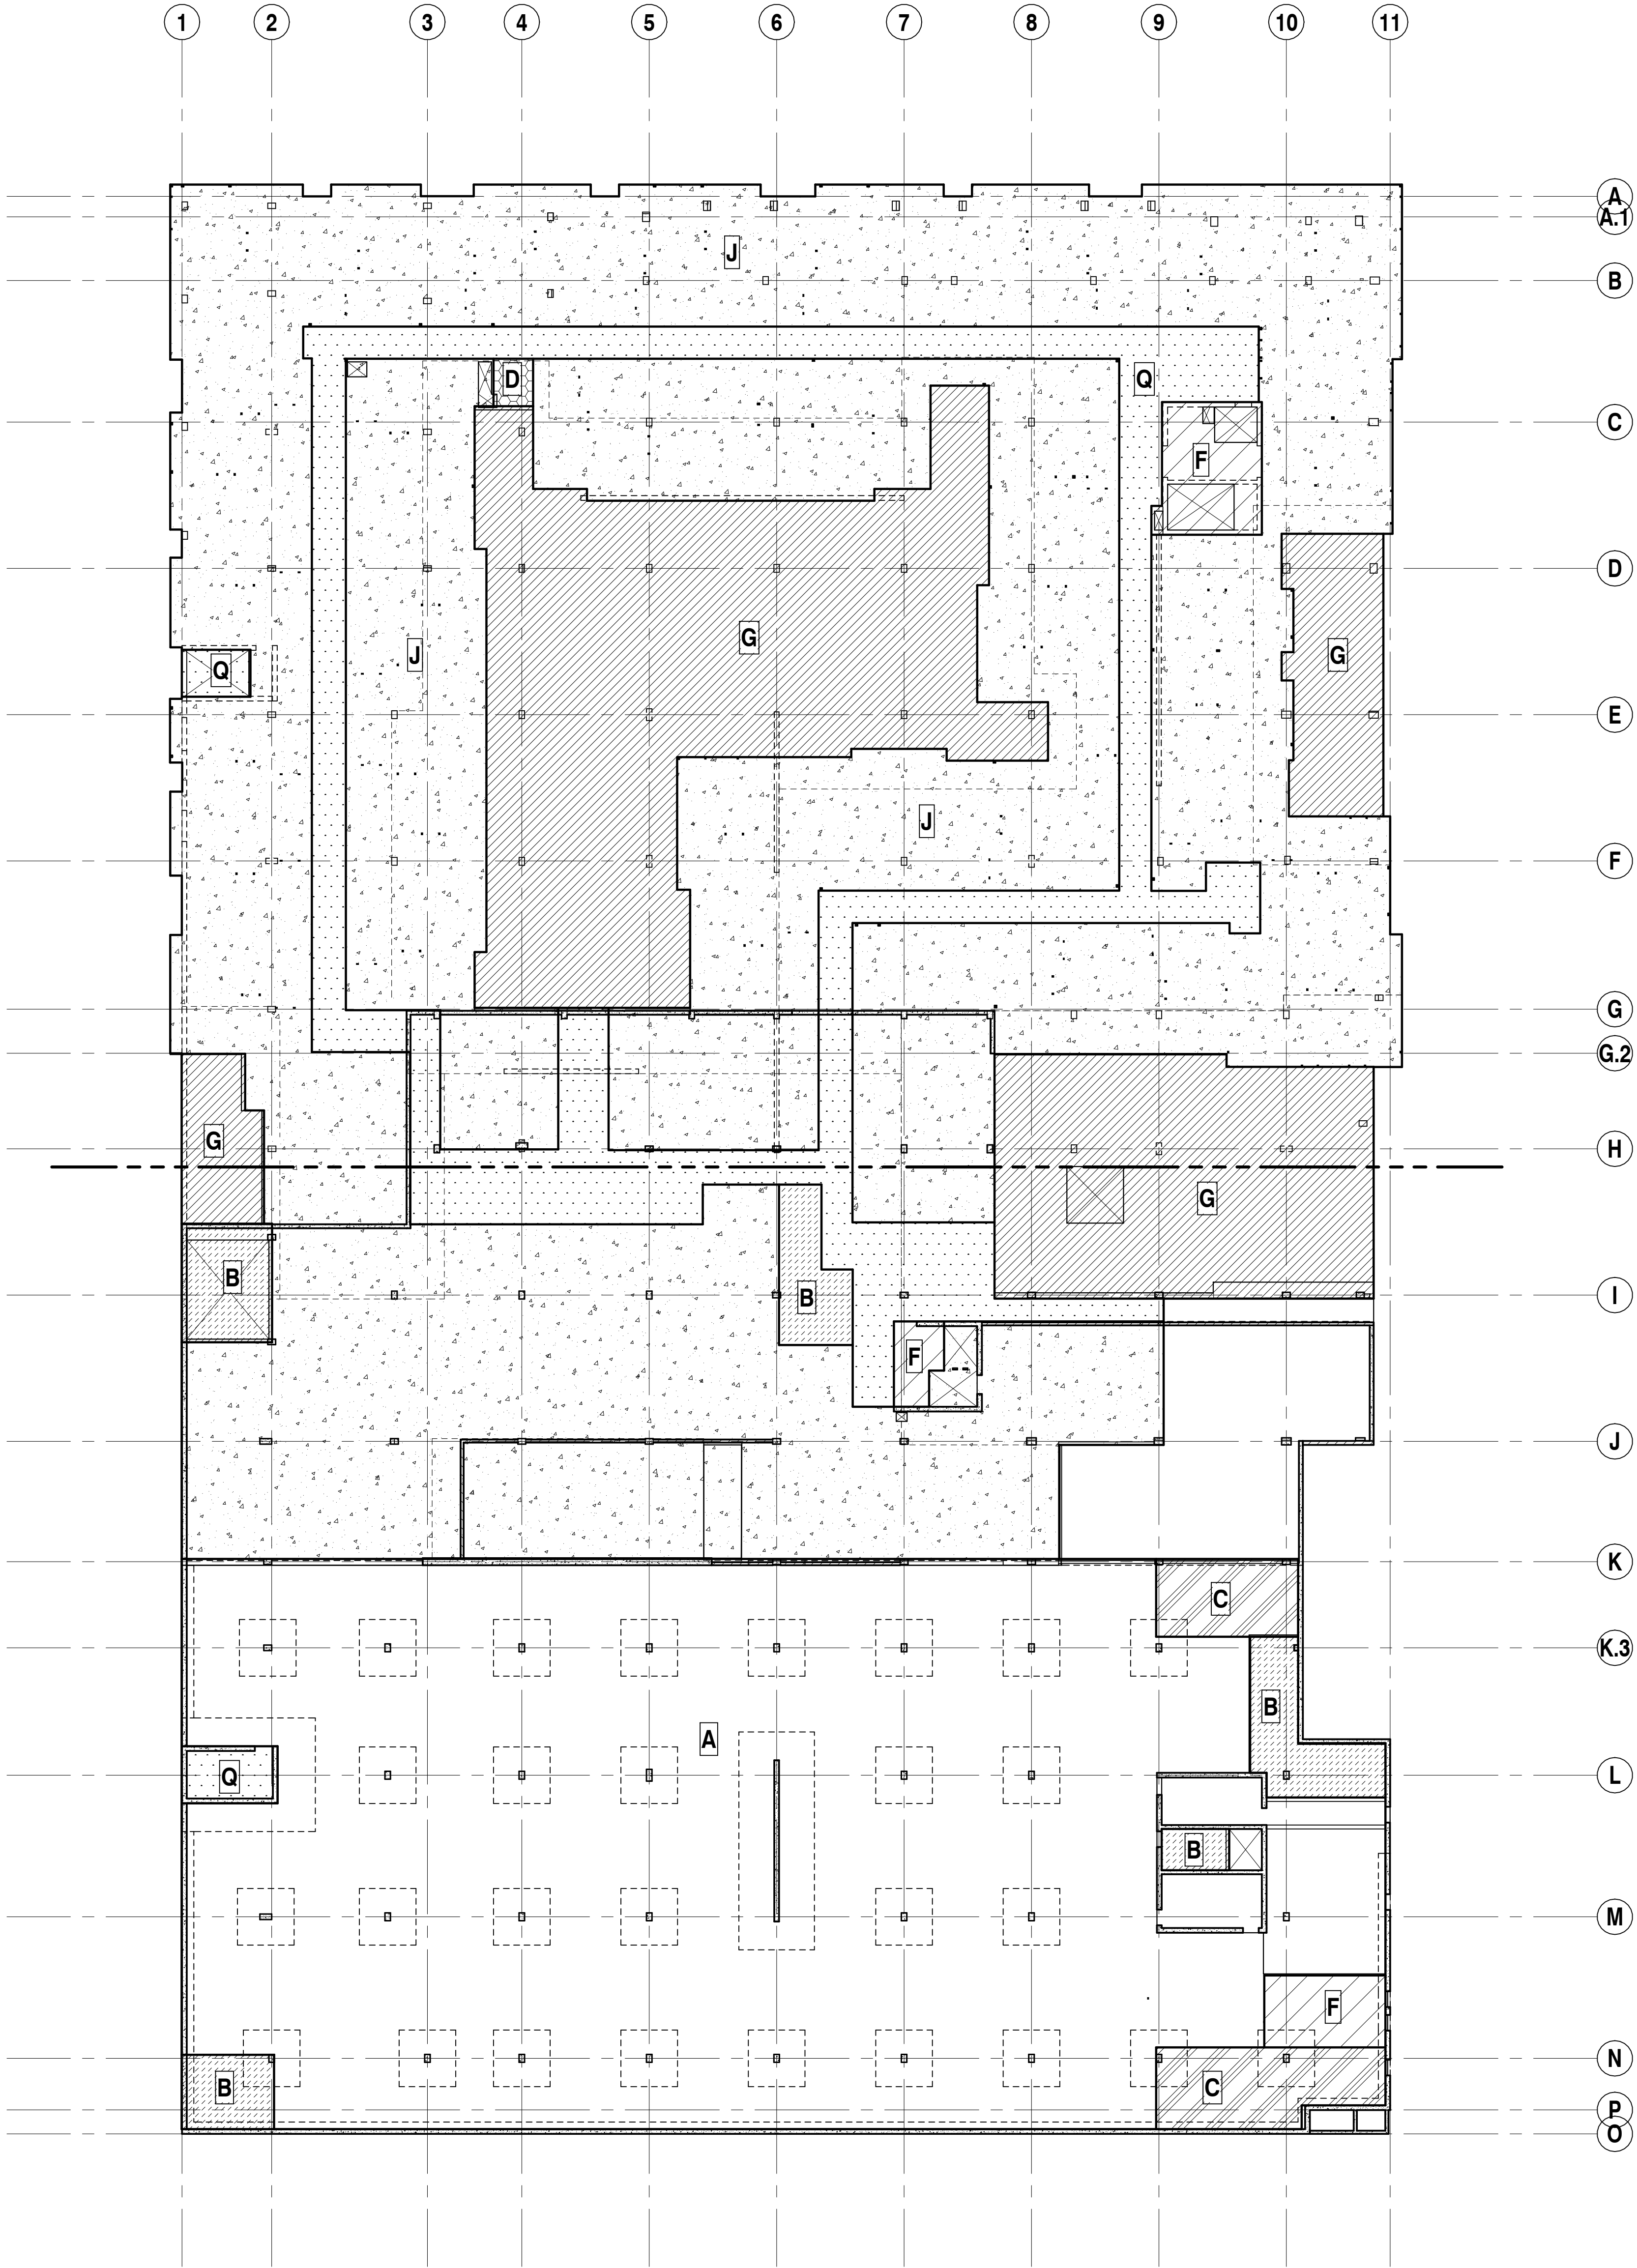

01601 LOAD MAP LEGEND			
DESIGN LOAD LEGEND			
MARK / PATTERN	AREA	ADDED DEAD LOAD	LIVE LOAD
A	PARKING	5 PSF	40 PSF
B	MECHANICAL	40 PSF	40 PSF
C	STORAGE	10 PSF	125 PSF
D	TRASH ROOM	10 PSF	100 PSF
E	GENERATOR/ TRANSFORMER	150 PSF	20 PSF
F	RETAIL/ FITNESS/LOBBY	15 PSF	100 PSF
G	LEVEL 3 AND 4 LANDSCAPE	150 PSF	100 PSF
H	DETENTION VAULT	250 PSF	40 PSF
J	RESIDENTIAL	CONC = 10 PSF WOOD = 23 PSF	40 PSF
K	TERRACE	30 PSF	40 PSF
L	ROOF	17 PSF	25 PSF
M	ROOF MECHANICAL	35 PSF	25 PSF
Q	STAIRS/ CORRIDOR	15 PSF (STAIRS)	100 PSF

LEVEL 3 LOADING PLAN

SCALE: 1" = 20'-0"

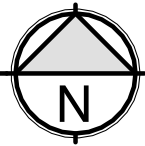

SUBMITTAL - REVISIONS		
NO.	DATE	DESCRIPTION
A1	11/29/2023	REVISION #1
B1	5/26/2024	REVISION #2
A2	5/26/2024	REVISION #3
A3	5/26/2024	REVISION #4
A4	5/26/2024	REVISION #5
A99	5/26/2024	REVISION #100

PROJECT
KINECT @ GRESHAM
1010 NW 12TH ST
GRESHAM, OR 97030

DRAWN BY
MH

CHECKED BY
EP

DRAWING SET DATE
APRIL 10, 2026

DRAWING SET TITLE
BID ADDENDUM #4


CITY OF GRESHAM PROJECT # 077031

SOUTHEAST CORNER OF SECTION 4,
TOWNSHIP 1 SOUTH, RANGE 3

TITLE
**STRUCTURAL LOADING
PLANS**

S0.23


ALL RIGHTS RESERVED. REPRODUCTION OR TRANSLATION OF ANY PART OF THIS WORK WITHOUT WRITTEN PERMISSION OF AMERICAN CAPITAL GROUP IS UNLAWFUL AND SUBJECT TO CRIMINAL PROSECUTION.

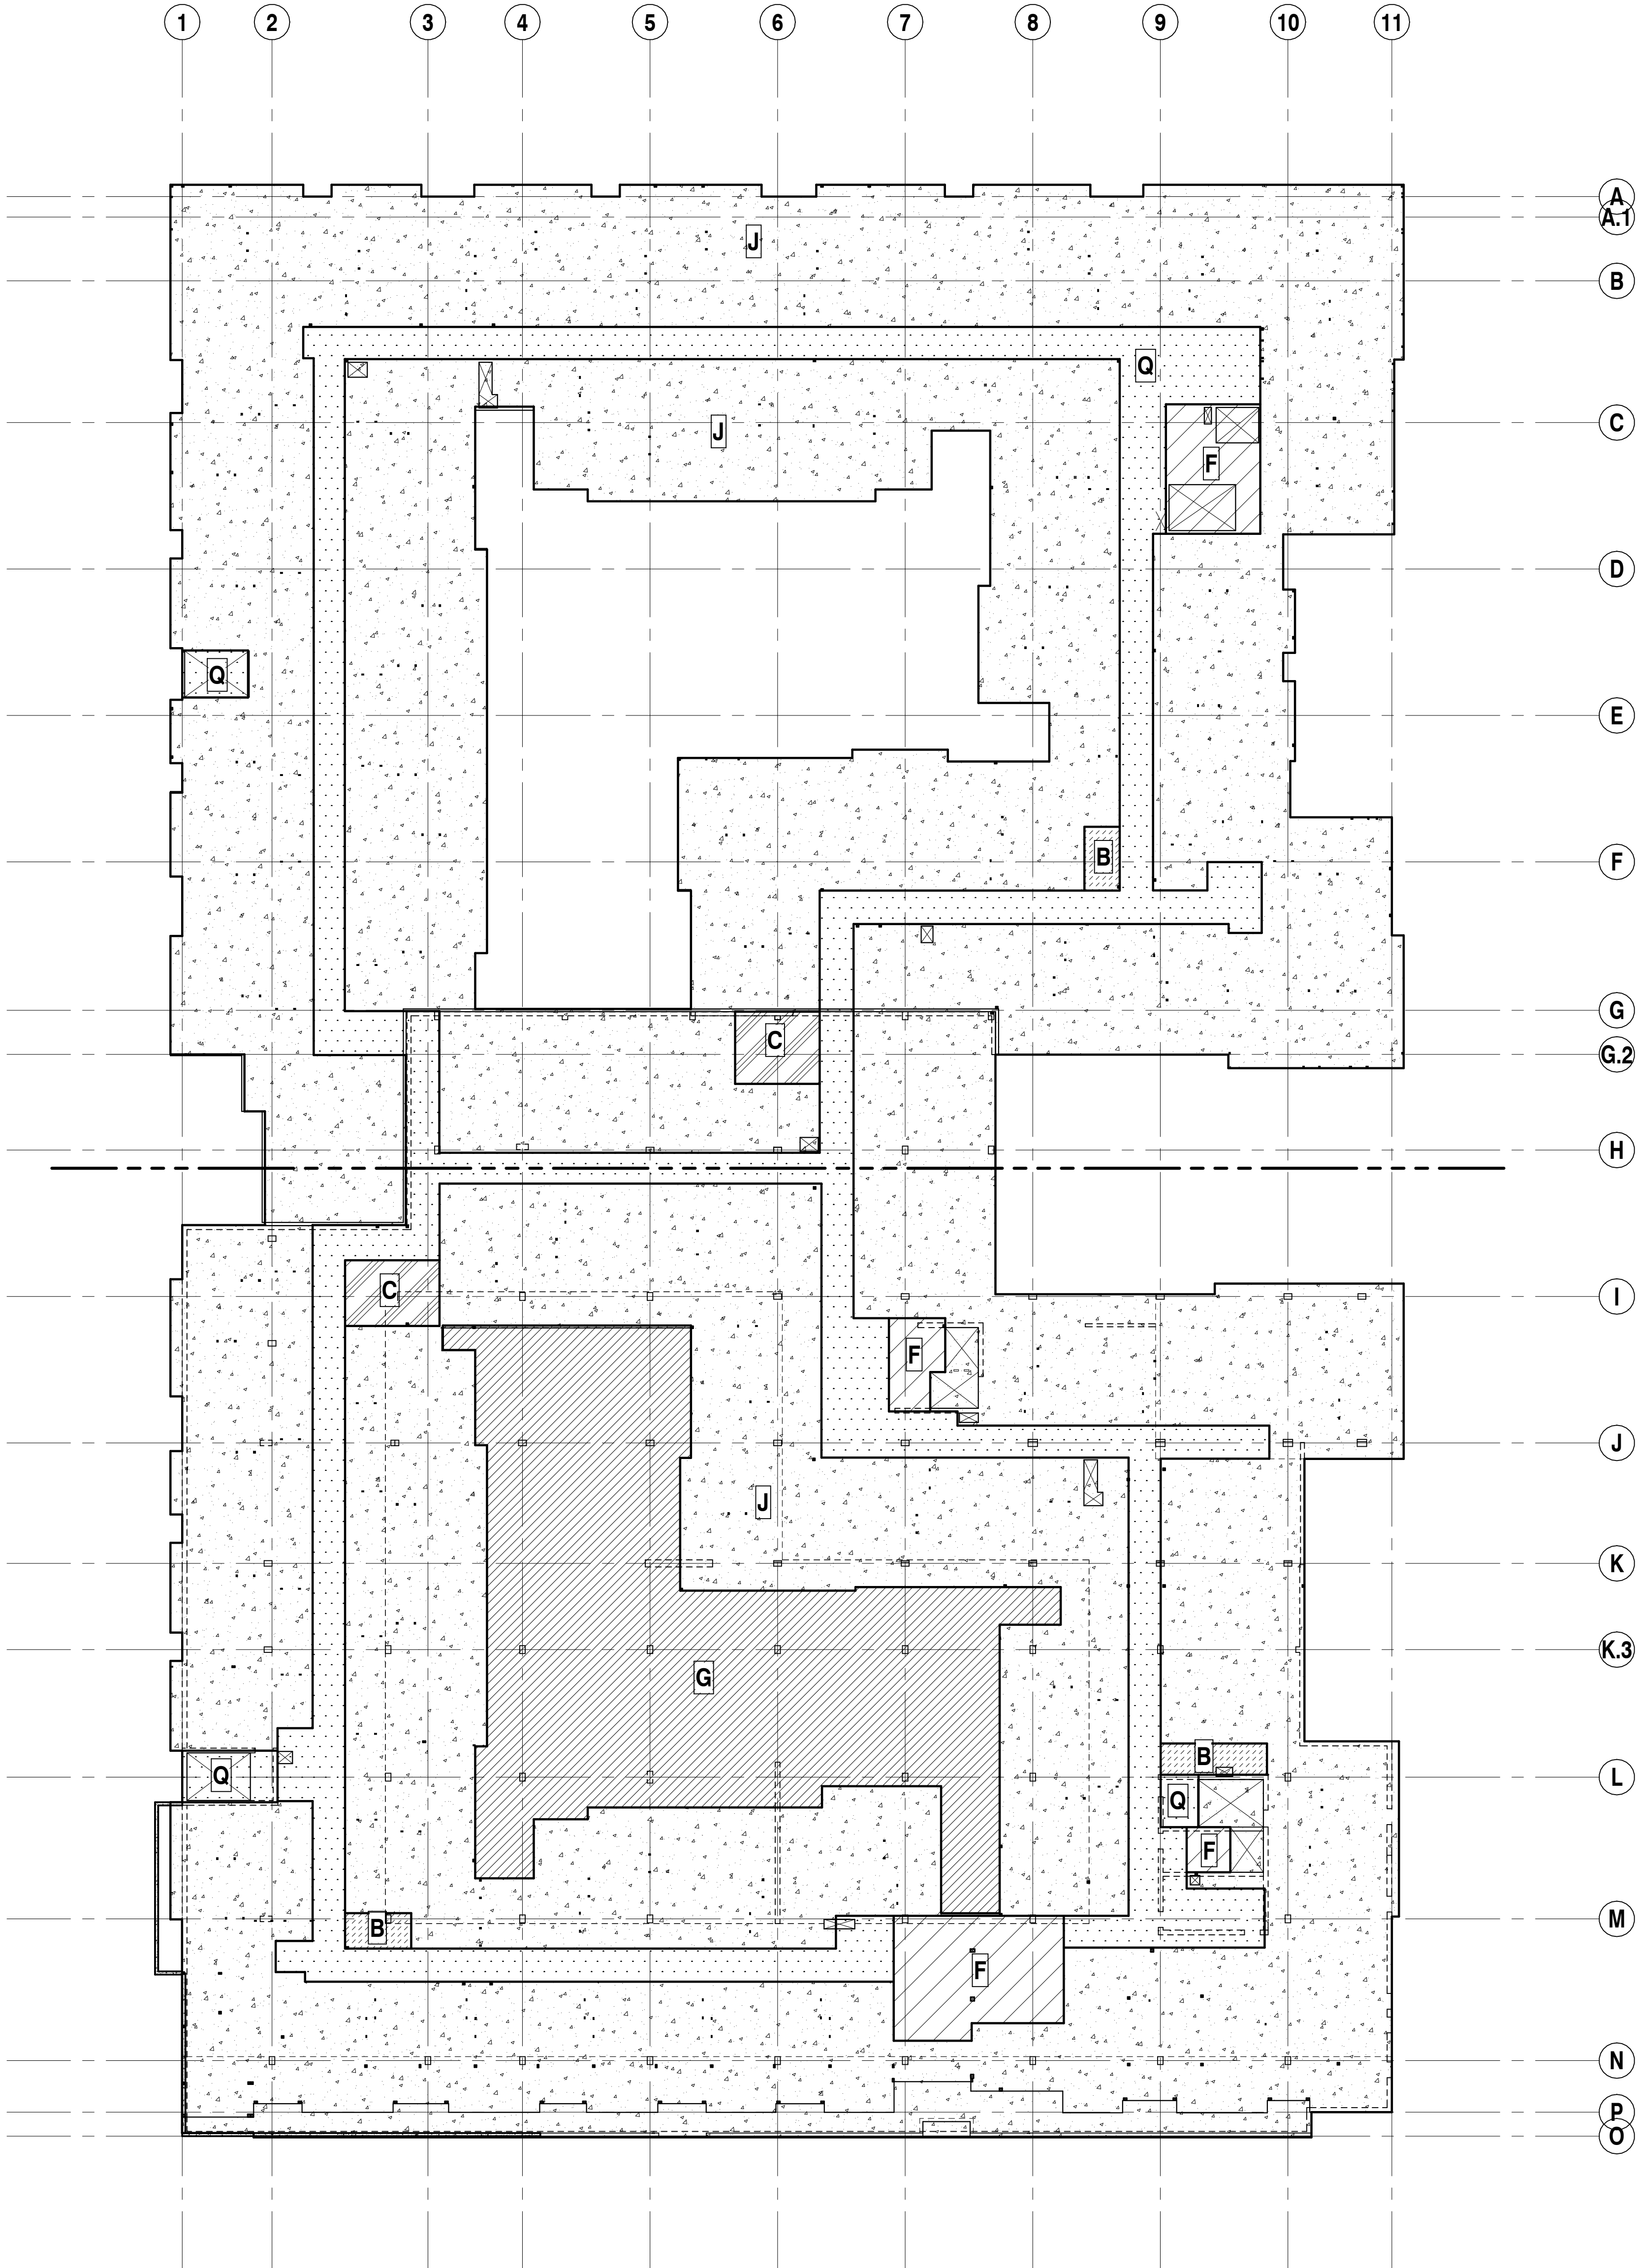

01601 LOAD MAP LEGEND			
DESIGN LOAD LEGEND			
MARK / PATTERN	AREA	ADDED DEAD LOAD	LIVE LOAD
A	PARKING	5 PSF	40 PSF
B	MECHANICAL	40 PSF	40 PSF
C	STORAGE	10 PSF	125 PSF
D	TRASH ROOM	10 PSF	100 PSF
E	GENERATOR/ TRANSFORMER	150 PSF	20 PSF
F	RETAIL/ FITNESS/LOBBY	15 PSF	100 PSF
G	LEVEL 3 AND 4 LANDSCAPE	150 PSF	100 PSF
H	DETENTION VAULT	250 PSF	40 PSF
J	RESIDENTIAL	CONC = 10 PSF WOOD = 23 PSF	40 PSF
K	TERRACE	30 PSF	40 PSF
L	ROOF	17 PSF	25 PSF
M	ROOF MECHANICAL	35 PSF	25 PSF
Q	STAIRS/ CORRIDOR	15 PSF (STAIRS)	100 PSF

LEVEL 4 LOADING PLAN

SCALE: 1" = 20'-0"

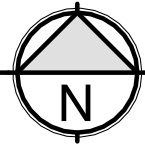

SUBMITTAL - REVISIONS		
NO.	DATE	DESCRIPTION
A1	11/29/2023	REVISION #1
B1	5/26/2024	REVISION #2
A2	5/26/2024	REVISION #3
A3	5/26/2024	REVISION #4
A4	5/26/2024	REVISION #5
A99	5/26/2024	REVISION #100

PROJECT
KINECT @ GRESHAM
1010 NW 12TH ST
GRESHAM, OR 97030

DRAWN BY
MH

CHECKED BY
EP

DRAWING SET DATE
APRIL 10, 2026


DRAWING SET TITLE
BID ADDENDUM #4

CITY OF GRESHAM PROJECT # 077531
SOUTHEAST CORNER OF SECTION 4,
TOWNSHIP 1 SOUTH, RANGE 3

TITLE
STRUCTURAL LOADING
PLANS


S0.24

THIS DRAWING IS FOR THE EXCLUSIVE USE OF MCCLONE CONSTRUCTION COMPANY. ON THE PROJECT ONLY. UTILIZATION OF THIS DRAWING BY OTHER PARTIES WITHOUT THE EXPRESSED WRITTEN CONSENT OF MCCLONE CONSTRUCTION COMPANY IS STRICTLY PROHIBITED.

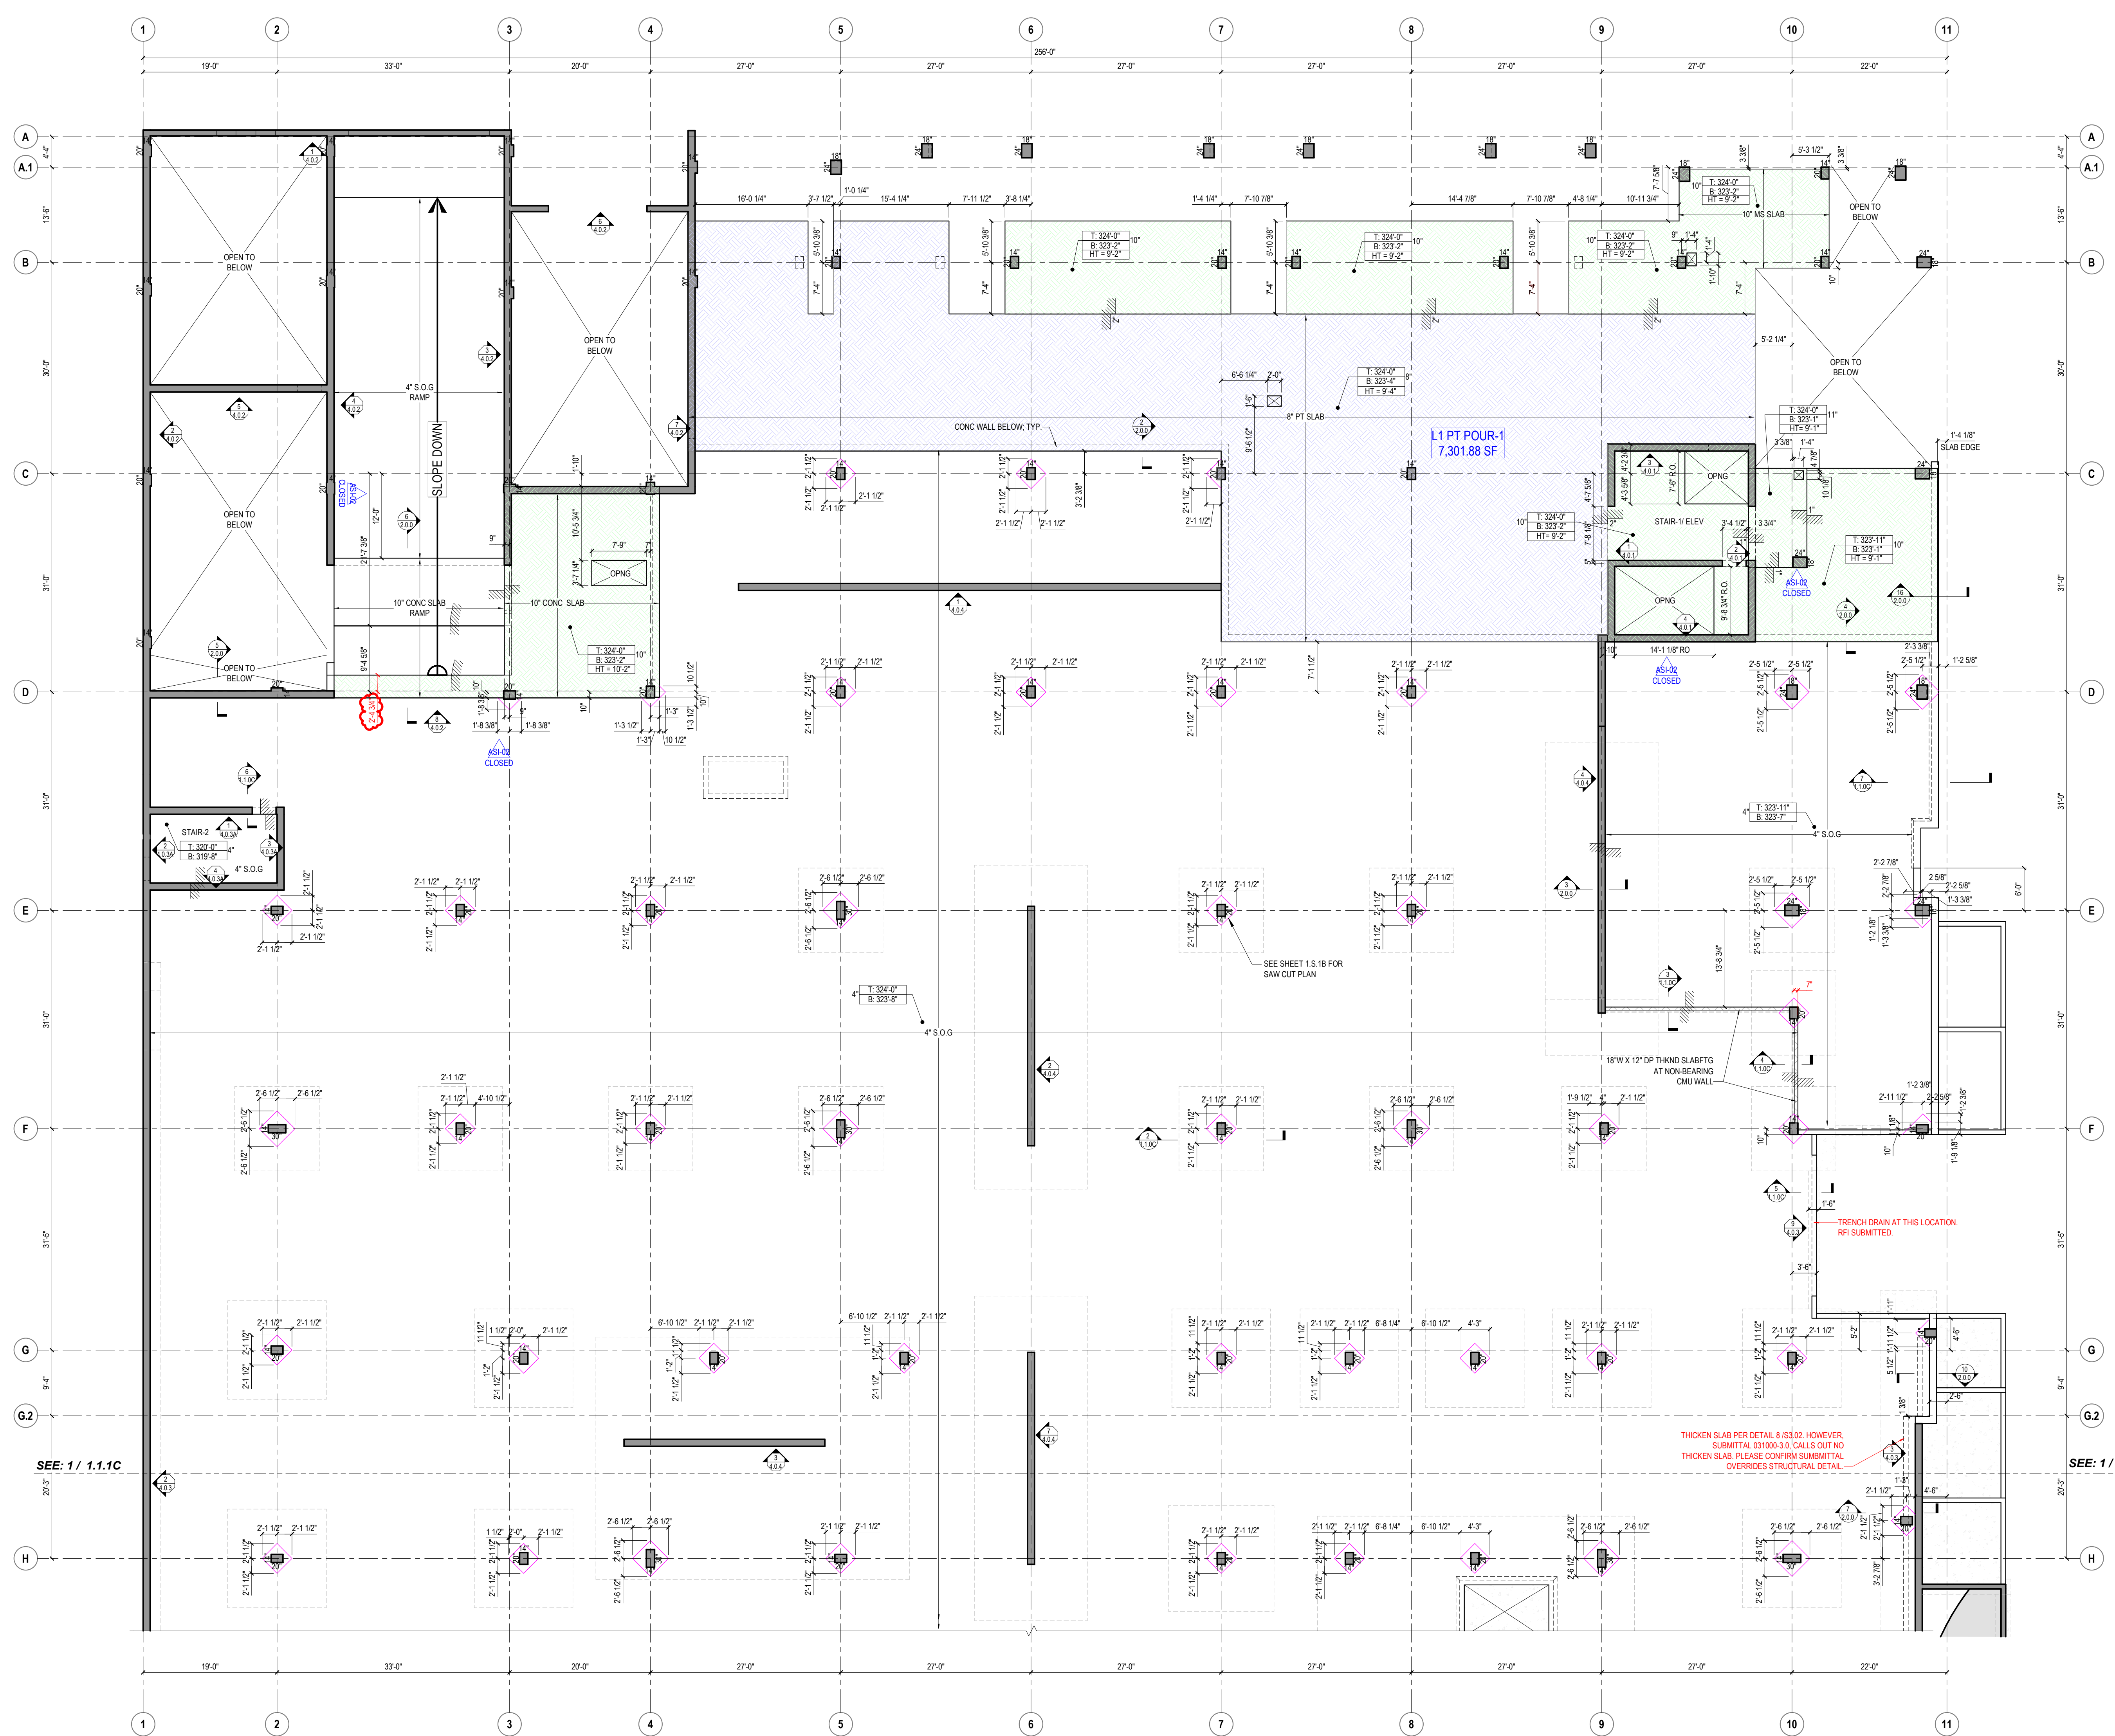

1 LEVEL-1B (FLOOR PLAN) - NORTH

PLEASE PROVIDE / VERIFY THE INFORMATION IN RED

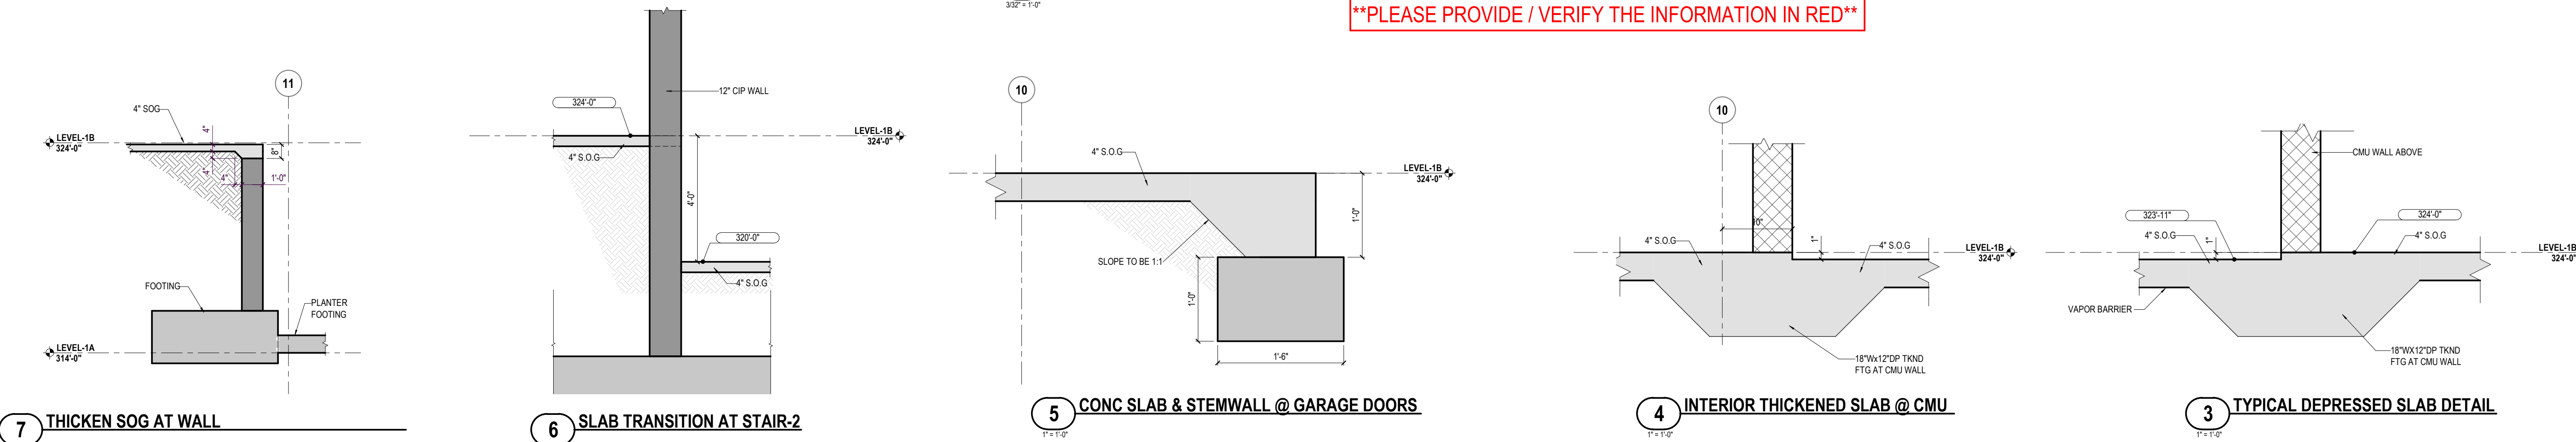


7 THICKEN SOG AT WALL

6 SLAB TRANSITION AT STAIR-2


5 CONC SLAB & STEMWALL @ GARAGE DOORS

4 INTERIOR THICKENED SLAB @ CMU


3 TYPICAL DEPRESSED SLAB DETAIL

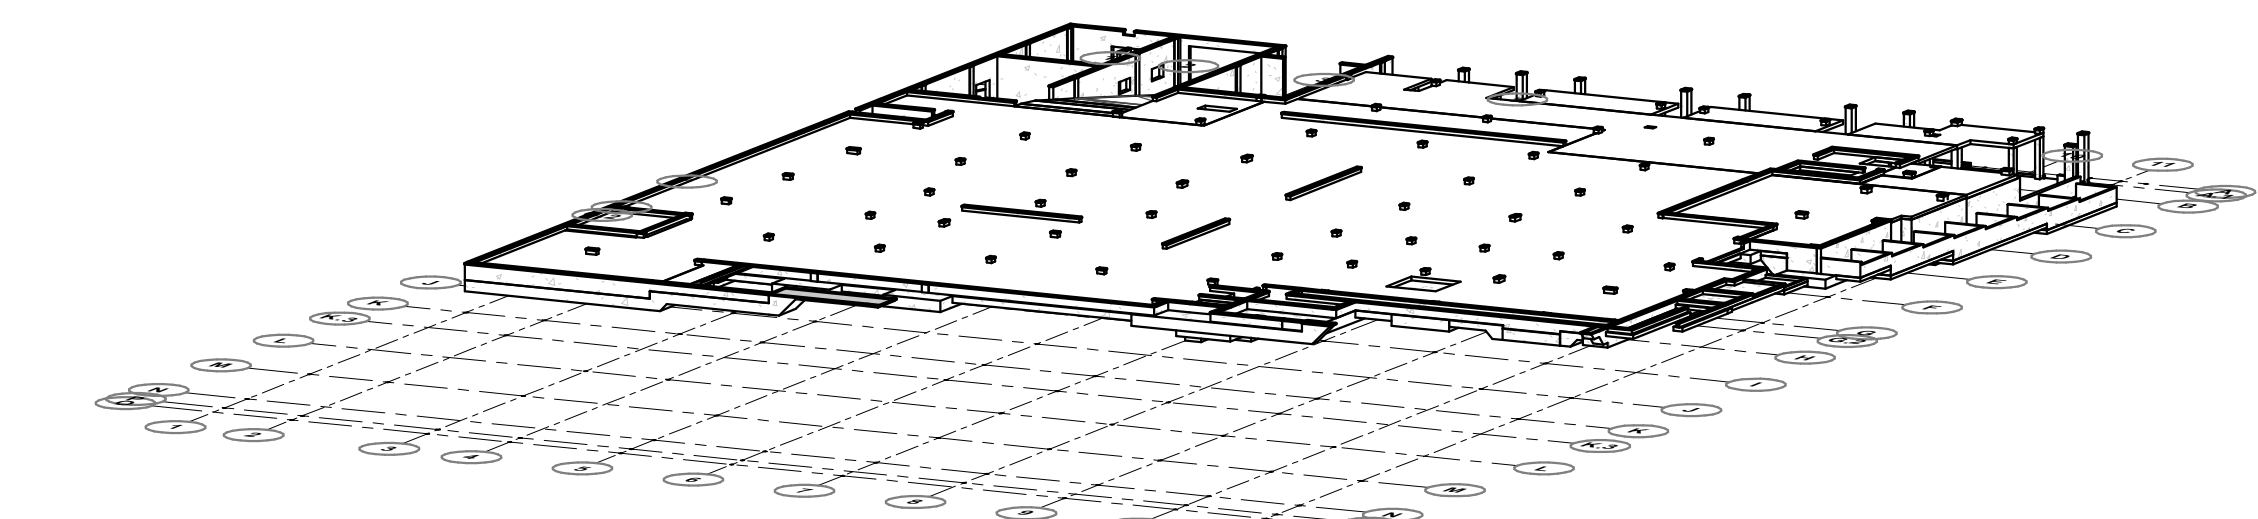

3D VIEW-LEVEL-1B

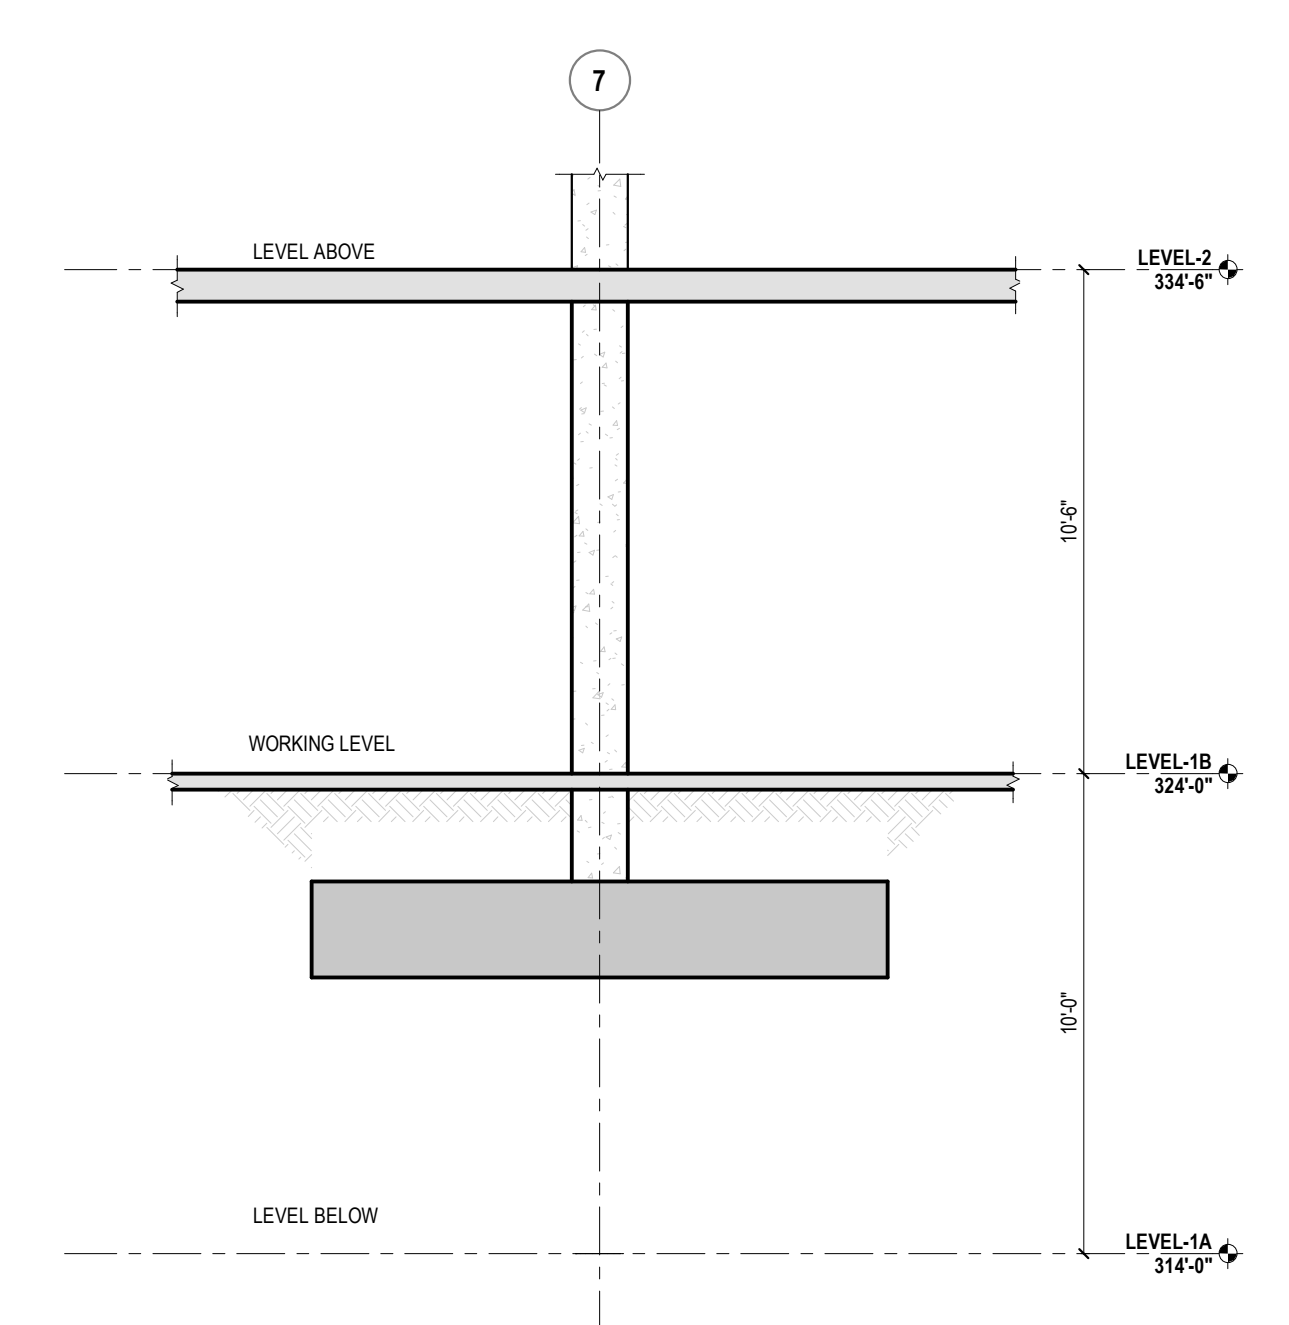

2 BUILDING SECTION LEVEL-1B

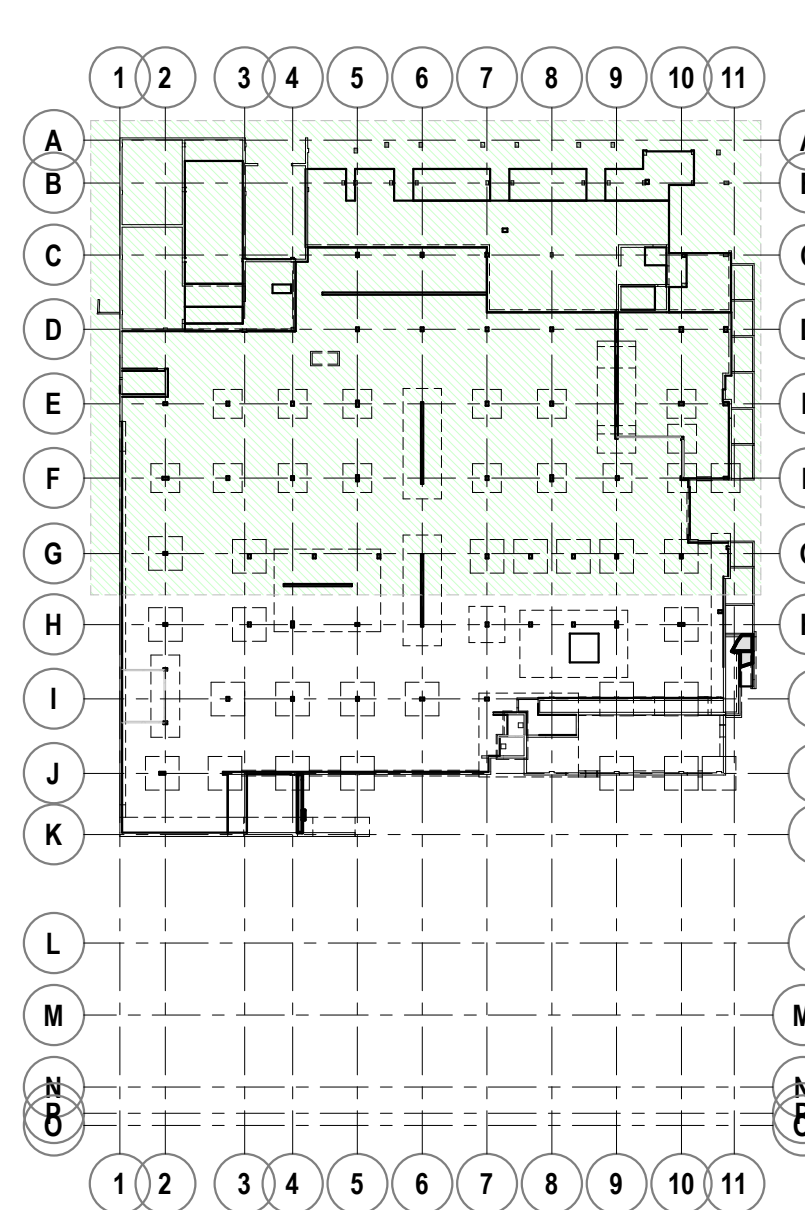

LEVEL-1B KEYPLAN NORTH

NOTES:

- 3/4" CHAMFER ON ALL EXPOSED CONCRETE CORNERS TYP.
- ALL COLUMNS ARE CENTERED ON GRID LINES UNO.
- ALL BEAMS ARE CENTERED ON GRID LINES UNO.
- SLAB ON GRADE THICKNESS IS 4" TYP. UNO.
- LEVEL 1B ELEVATION = 324'-0"

LEGEND

SYMBOLS	SHADE DESIGNATIONS
FOOTING OR FOUNDATIONS	(TOP ELEV.)
TOP OF CONCRETE ELEVATIONS	(RBT ELEV.)
1-BOX	(TOP ELEV.)
BOTTOM OF CONCRETE ELEVATIONS	(RBT ELEV.)
2-BOX (PLAN VIEWS)	(TOP ELEV.)
TOP & BOTTOM ELEVATIONS	(RBT ELEV.)
3-BOX (FLOOR PLANS)	(TOP ELEV.)
TOP & BOTTOM ELEVATIONS	(RBT ELEV.)
COLUMN ELEVATION ABOVE REF. LEVEL	(TOP ELEV.)
4-BOX (FLOOR PLANS)	(RBT ELEV.)
TOP & BOTTOM ELEVATIONS	(TOP ELEV.)
COLUMN ELEVATION ABOVE REF. LEVEL	(RBT ELEV.)
5-BOX (FLOOR PLANS)	(TOP ELEV.)
TOP & BOTTOM ELEVATIONS	(RBT ELEV.)
COLUMN ELEVATION ABOVE REF. LEVEL	(RBT ELEV.)
6-BOX (FLOOR PLANS)	(TOP ELEV.)
TOP & BOTTOM ELEVATIONS	(RBT ELEV.)
COLUMN ELEVATION ABOVE REF. LEVEL	(RBT ELEV.)


LINE DESIGNATIONS
INDICATES TOP OF FTG CHANGE & EDGE OF FTG
INDICATES BOTTOM OF FTG CHANGE
INDICATES CONSTRUCTION JOINT
INDICATES GRID LINE

McCLONE
CONSTRUCTION COMPANY
2850 MAPLE VALLEY BLVD. SUITE 200
MAPLE VALLEY, WA 98043 • (206) 415-1400

LEVEL-1B FLOOR PLAN - NORTH
KINETIC @ GRESHAM
1010 NW 12TH ST GRESHAM, OR 97030


DATE: 08/28/2025
BY: [Signature]
CHECKED: [Signature]
SCALE: AS SHOWN
SHEET: 1326
REV: 1.1.0C

THIS DRAWING IS FOR THE EXCLUSIVE USE OF MCCLONE CONSTRUCTION COMPANY. ON THE PROJECT ONLY. UTILIZATION OF THIS DRAWING BY OTHER PARTIES WITHOUT THE EXPRESSED WRITTEN CONSENT OF MCCLONE CONSTRUCTION COMPANY IS STRICTLY PROHIBITED.

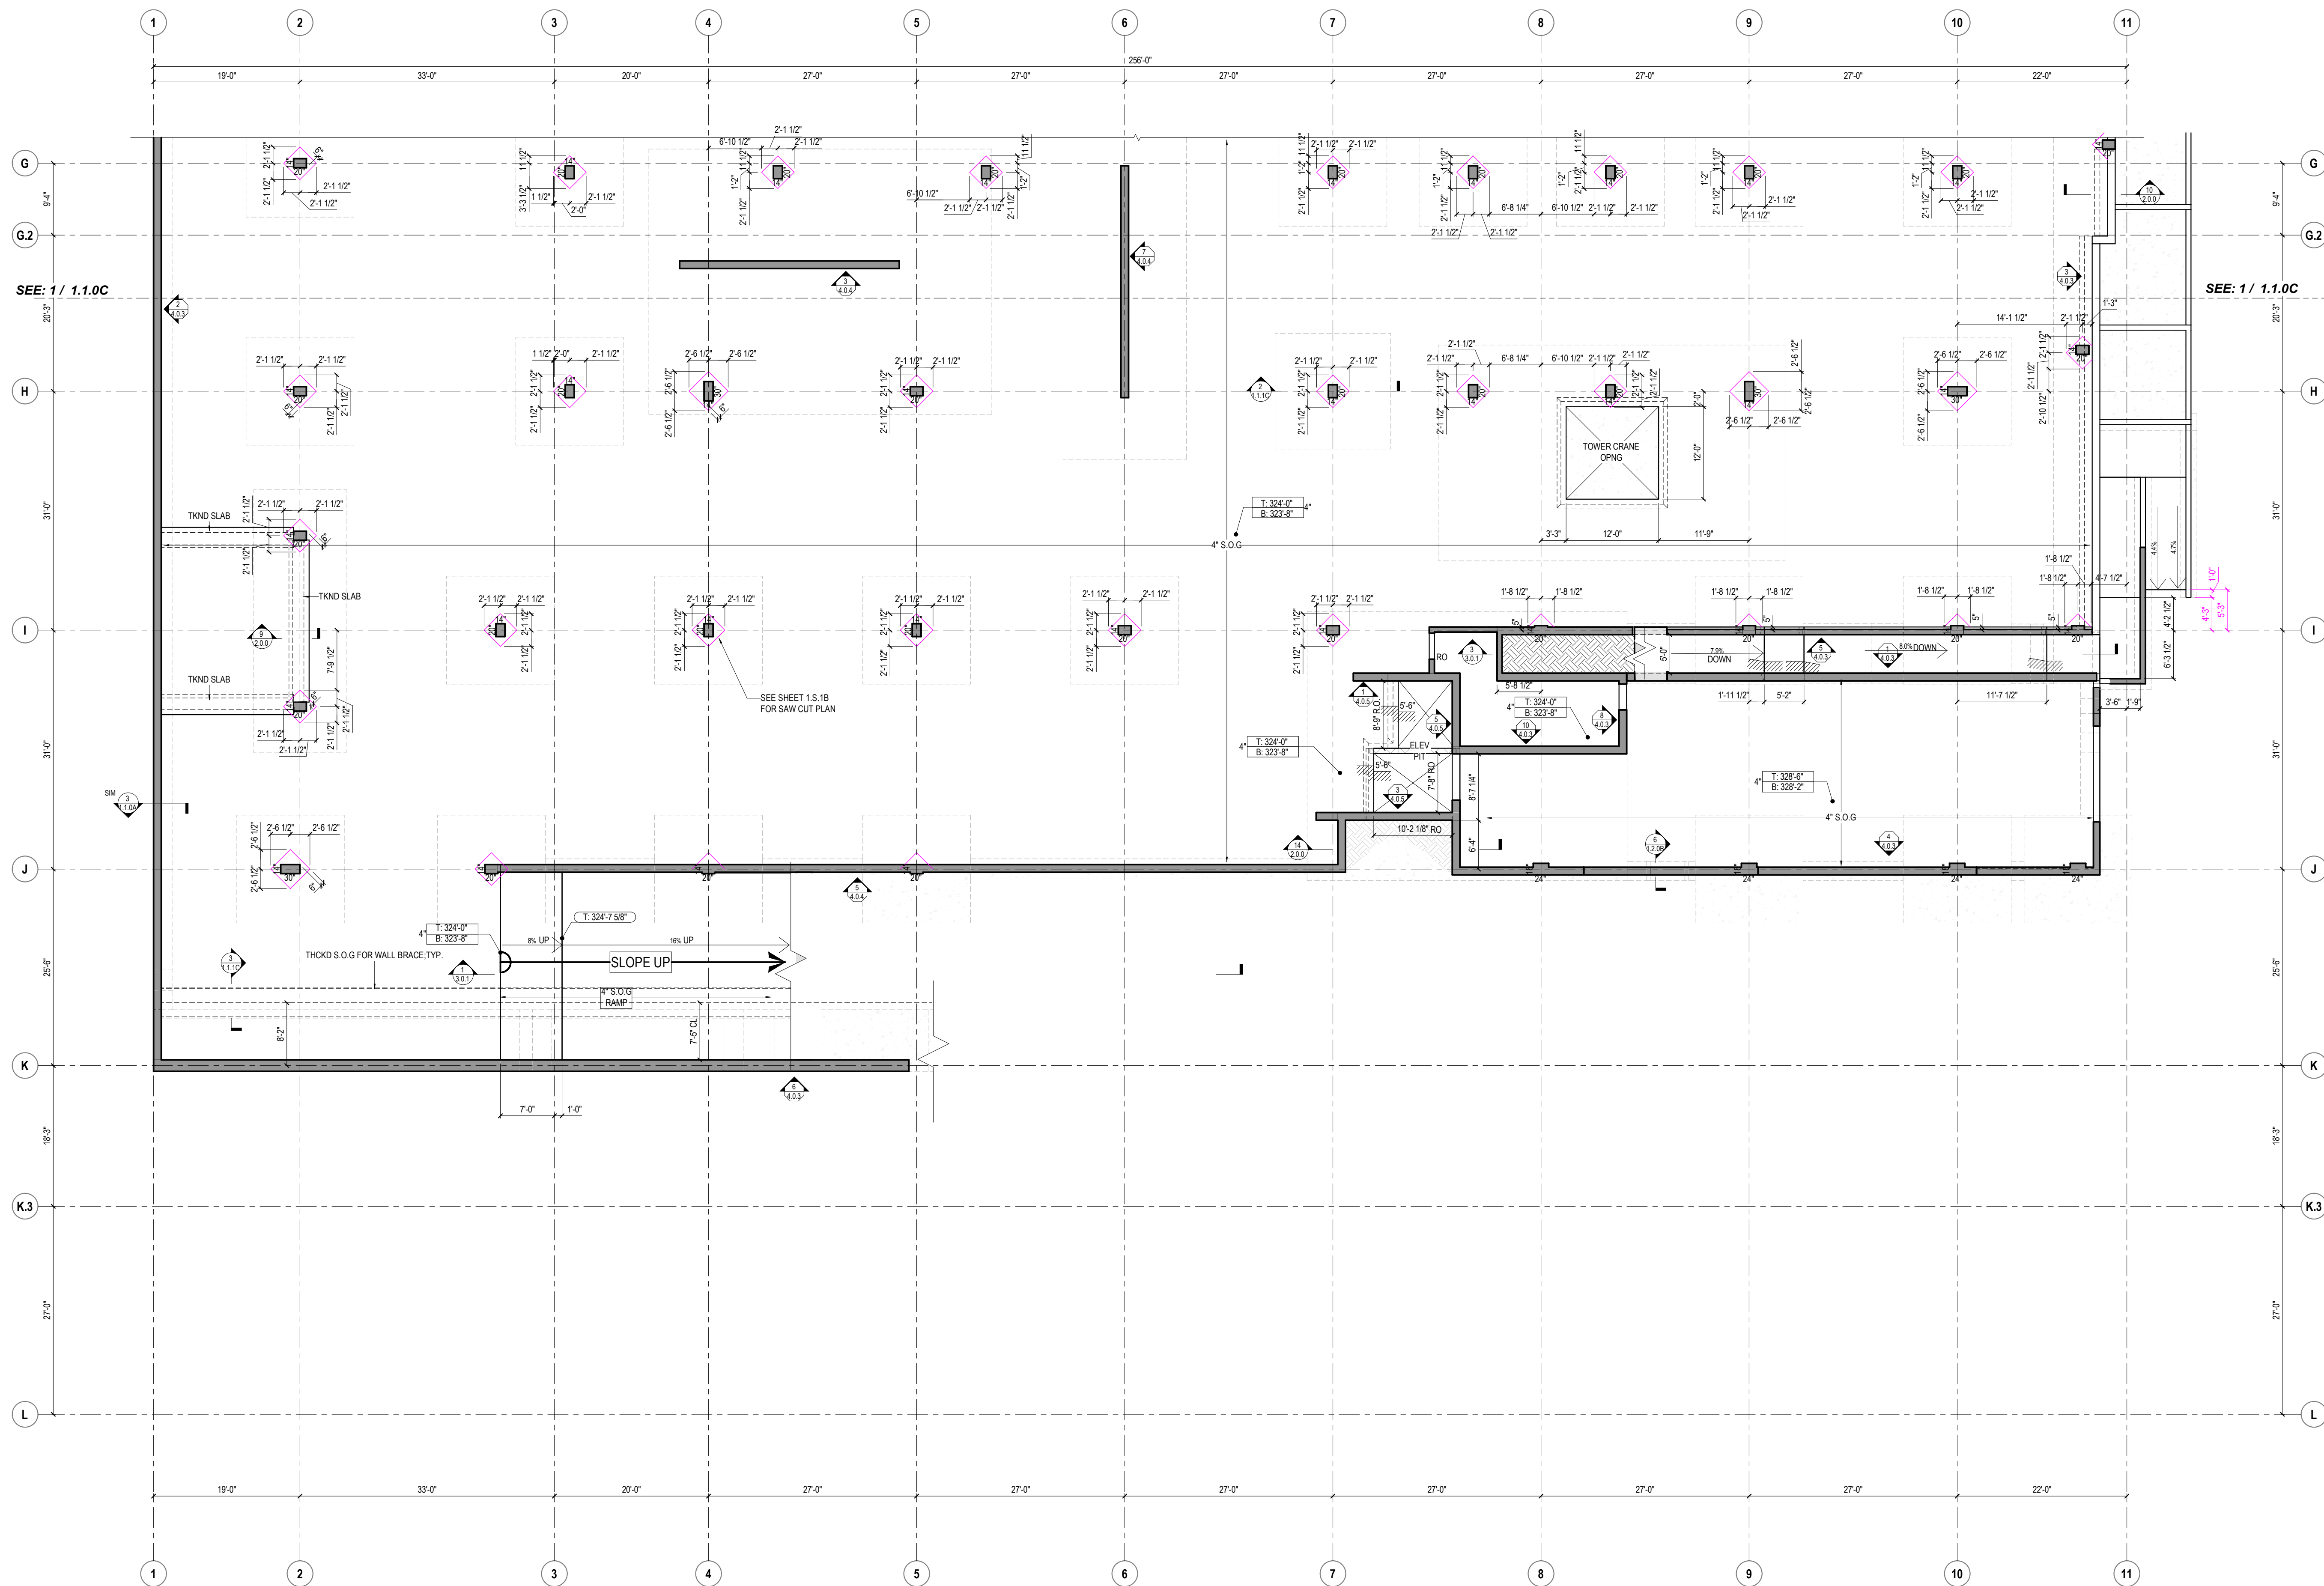


1 LEVEL-1B S.O.G FLOOR PLAN - SOUTH
31' x 11'


PLEASE PROVIDE / VERIFY THE INFORMATION IN MAGENTA

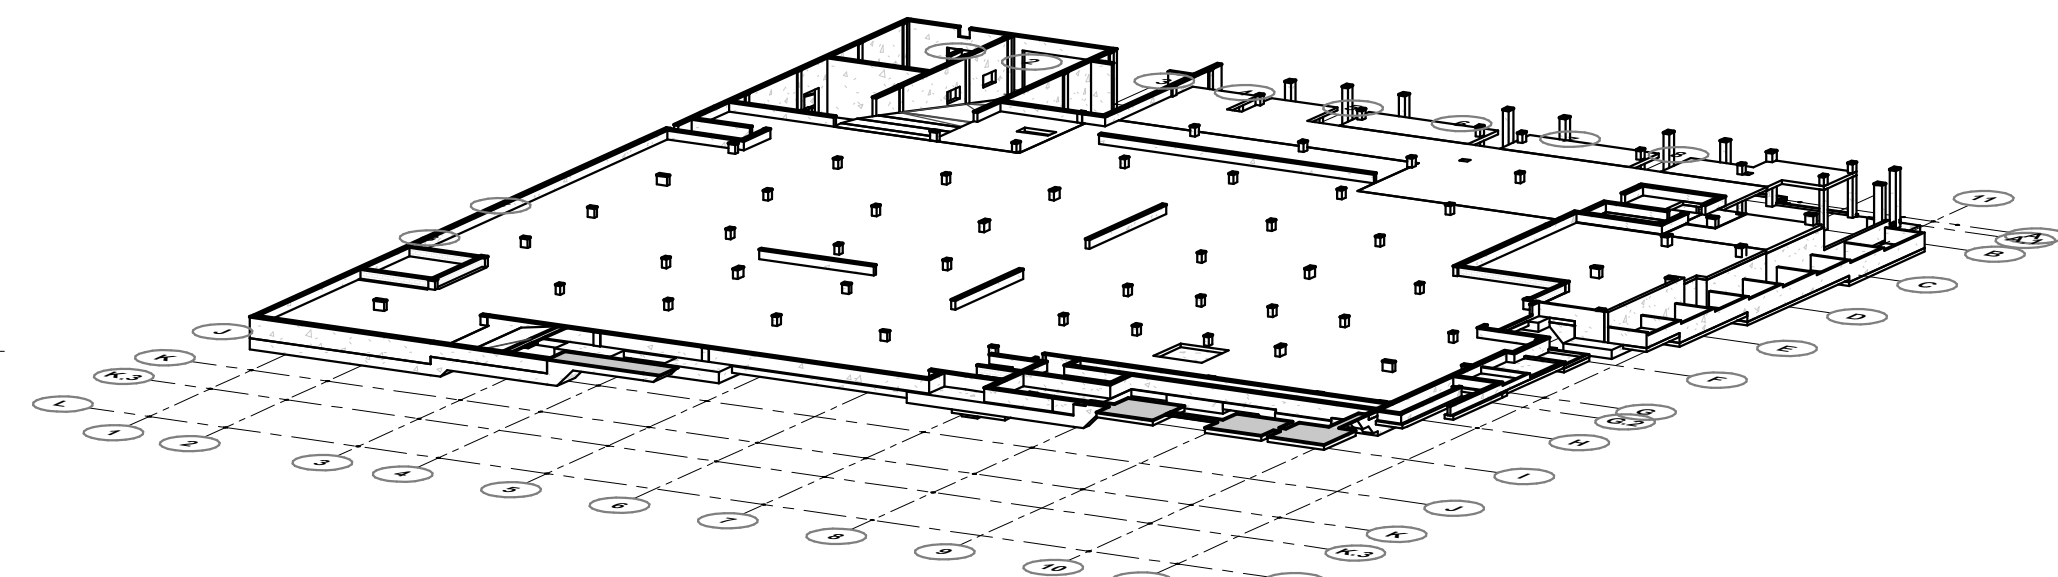


3D VIEW - LEVEL 1B SOUTH

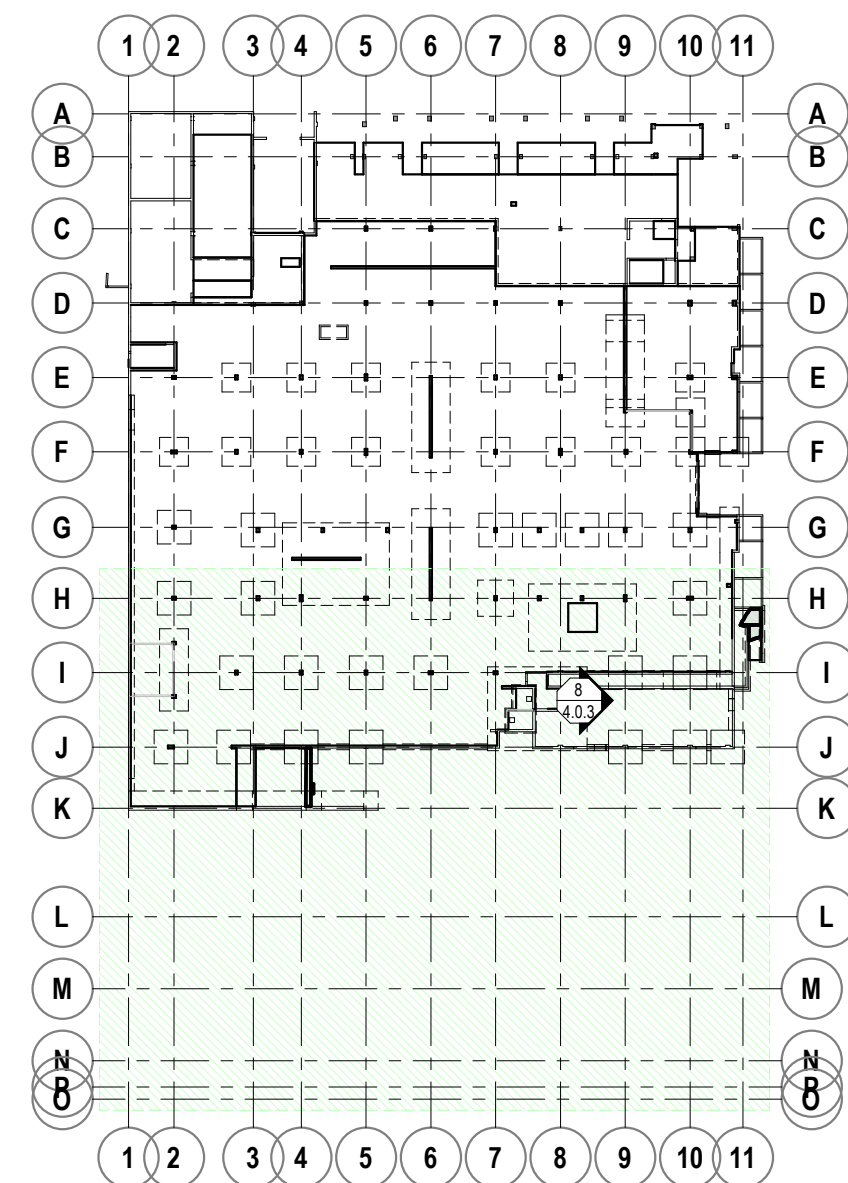

LEVEL-1B KEY PLAN SOUTH

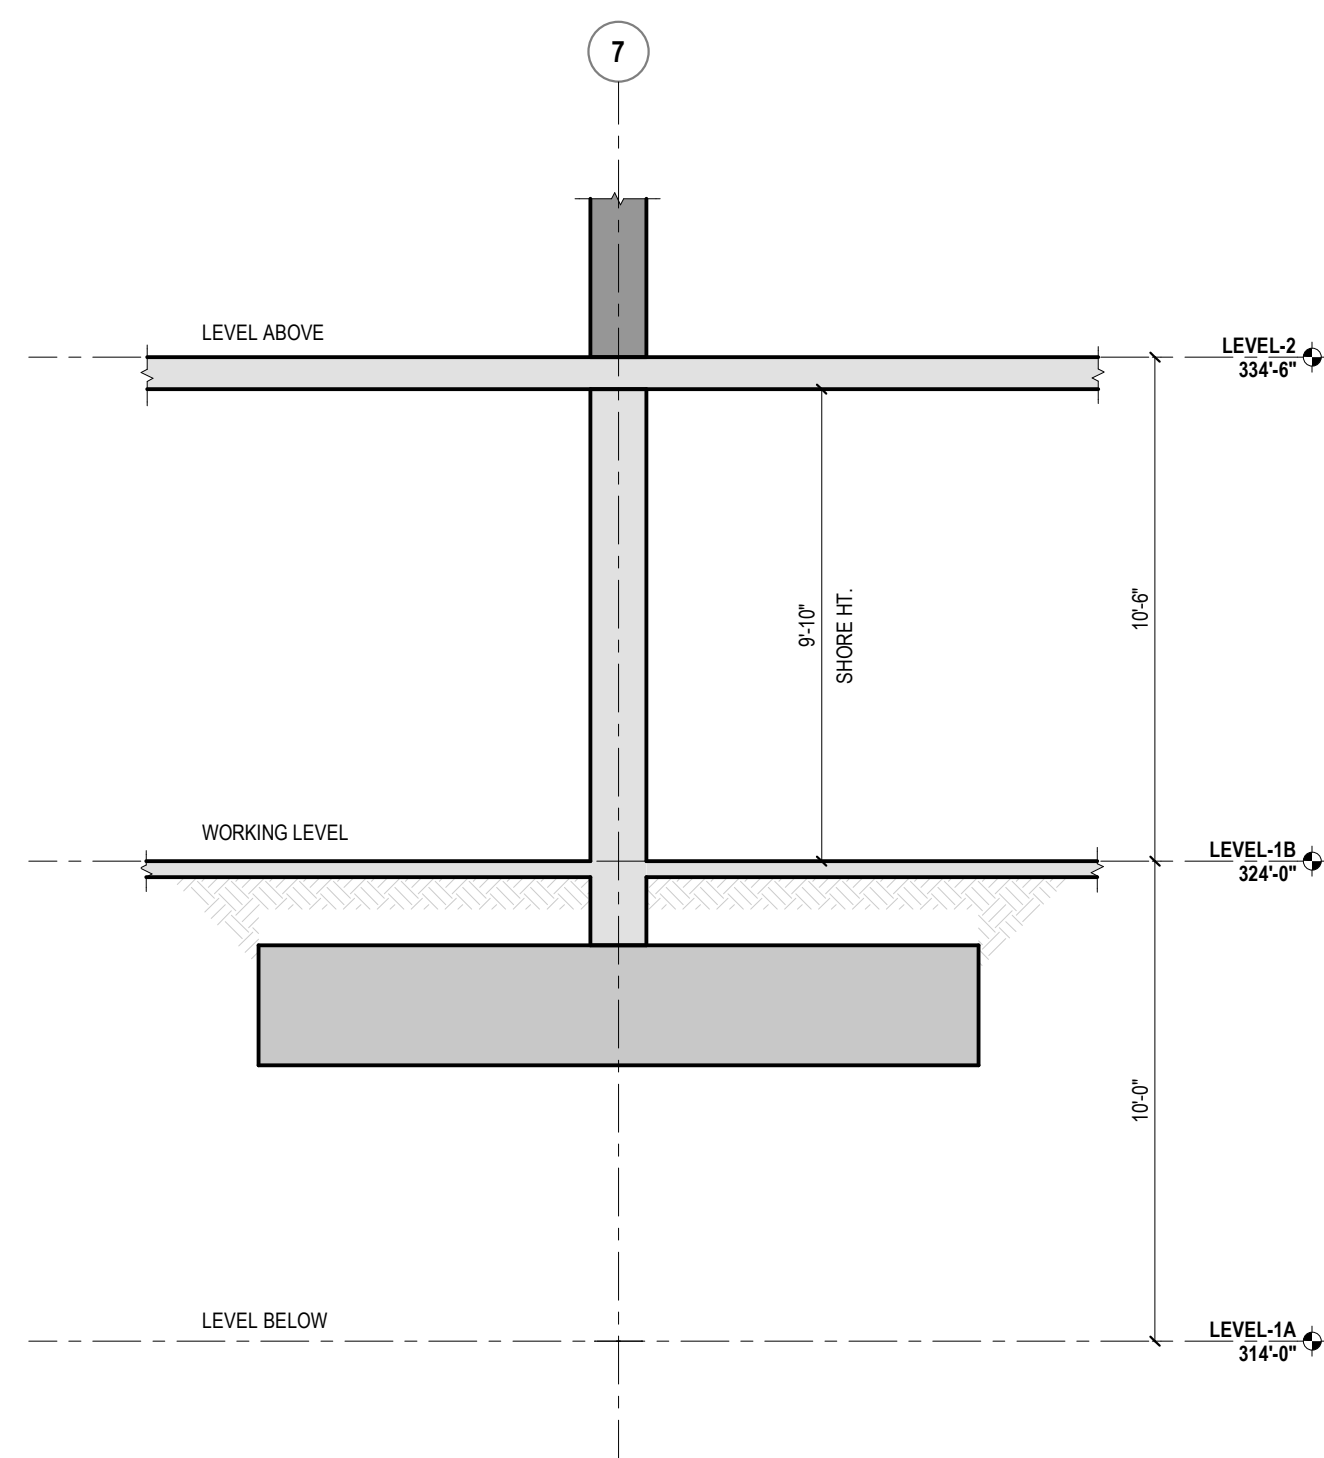


2 BUILDING SECTION LEVEL-1B
10' x 10'

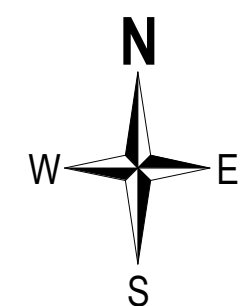


NOTES:

- 3/4\"/>

SYMBOLS		SHADE DESIGNATIONS	
1-BOX (ROUND-ENDS) TOP OF CONCRETE ELEVATIONS		BEAM OR DROP CAP	
1-BOX BOTTOM OF CONCRETE ELEVATIONS		WALLS OR COLUMNS	
2-BOX (PLAN VIEWS) TOP & BOTTOM ELEVATIONS D+ DEPTH OF CONC. MEMBER		CMU WALLS	
3-BOX (FLOOR PLANS) TOP & BOTTOM ELEVATIONS COLUMN ELEVATION ABOVE REF. LEVEL D+ DEPTH OF CONC. MEMBER		DELAY STRIP OR CLOSURE POUR GRADE OR SOIL	
		Y\"/>	
		Z\"/>	
SECTION VIEW		LINE DESIGNATIONS	
INDICATES TOP OF SLAB CHANGE OR EDGE OF SLAB		INDICATES TOP OF SLAB CHANGE OR EDGE OF SLAB	
INDICATES SOFFIT CHANGE		INDICATES SOFFIT CHANGE	
INDICATES CONSTRUCTION JOINT		INDICATES CONSTRUCTION JOINT	
INDICATES GRID LINE		INDICATES GRID LINE	

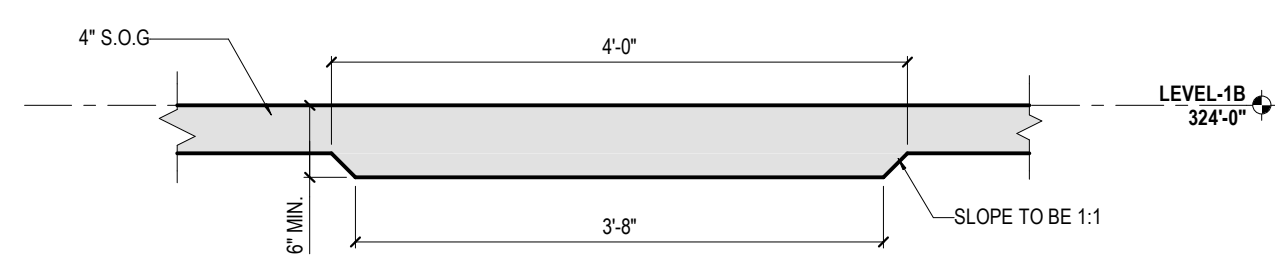


3 THICKENED S.O.G FOR WALL BRACE
31' x 11'

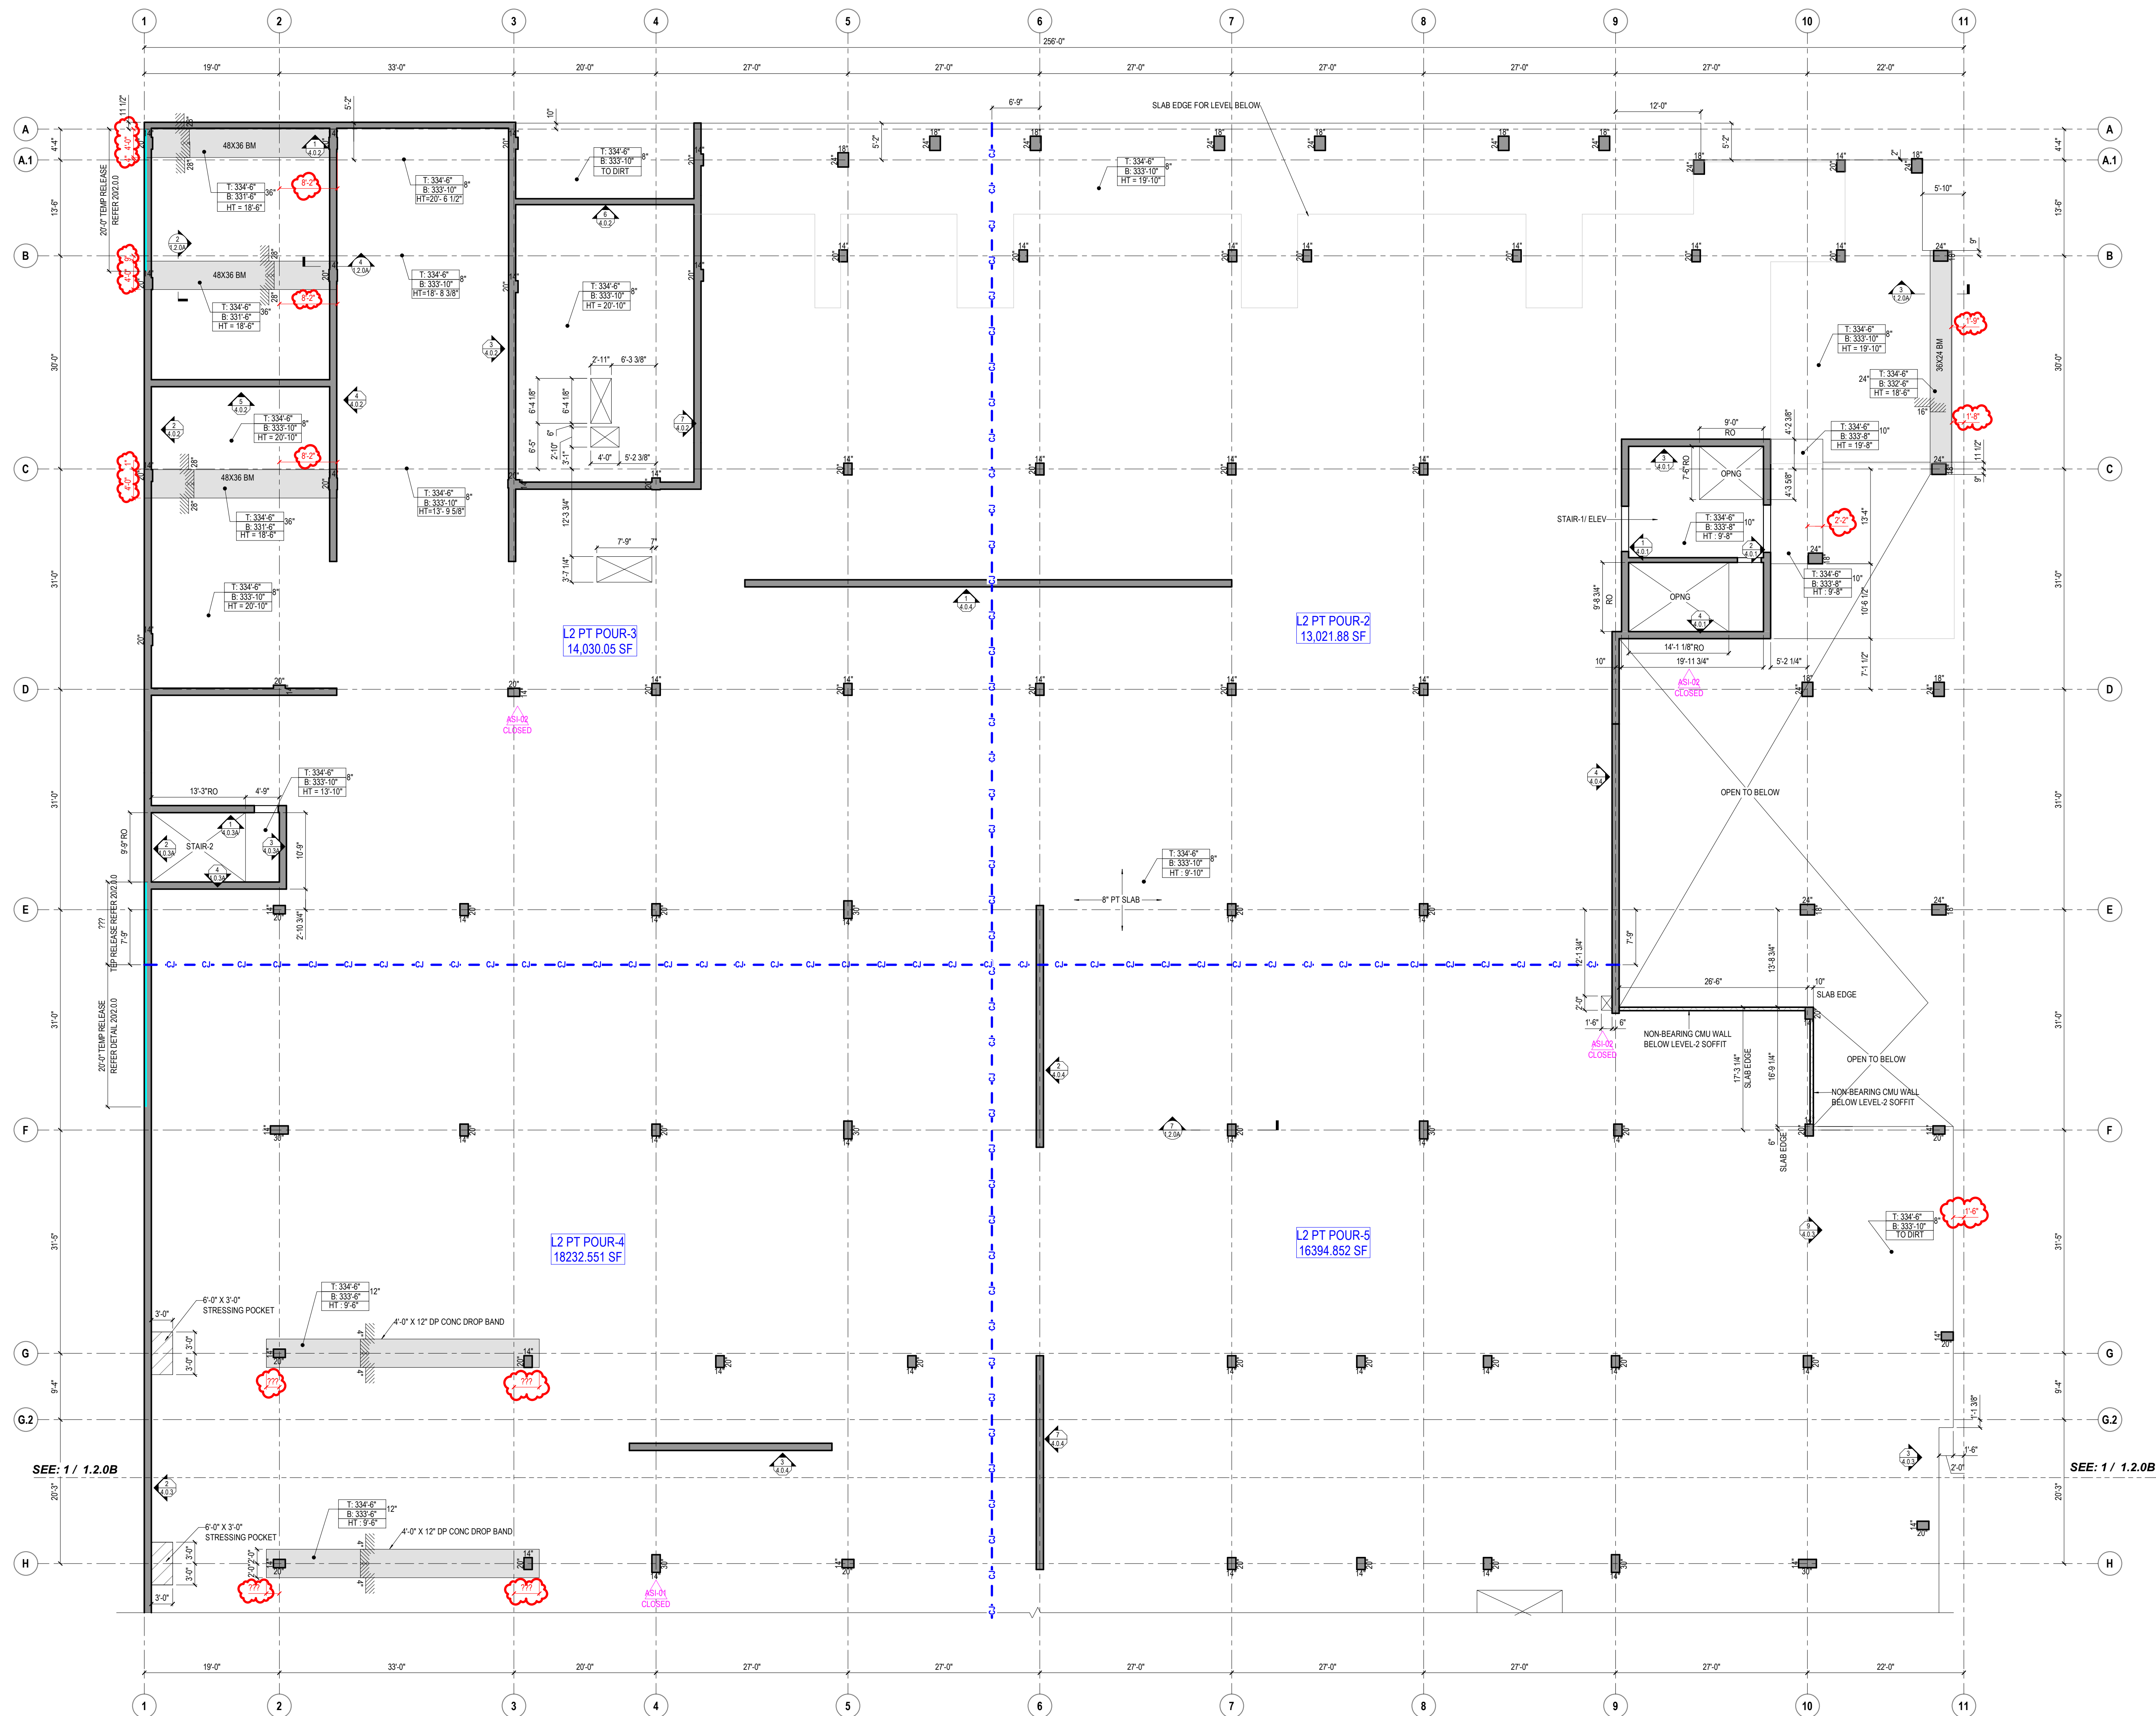


1 LEVEL-2 (SOFFIT PLAN) - NORTH


****PLEASE PROVIDE / VERIFY THE INFORMATION IN RED****

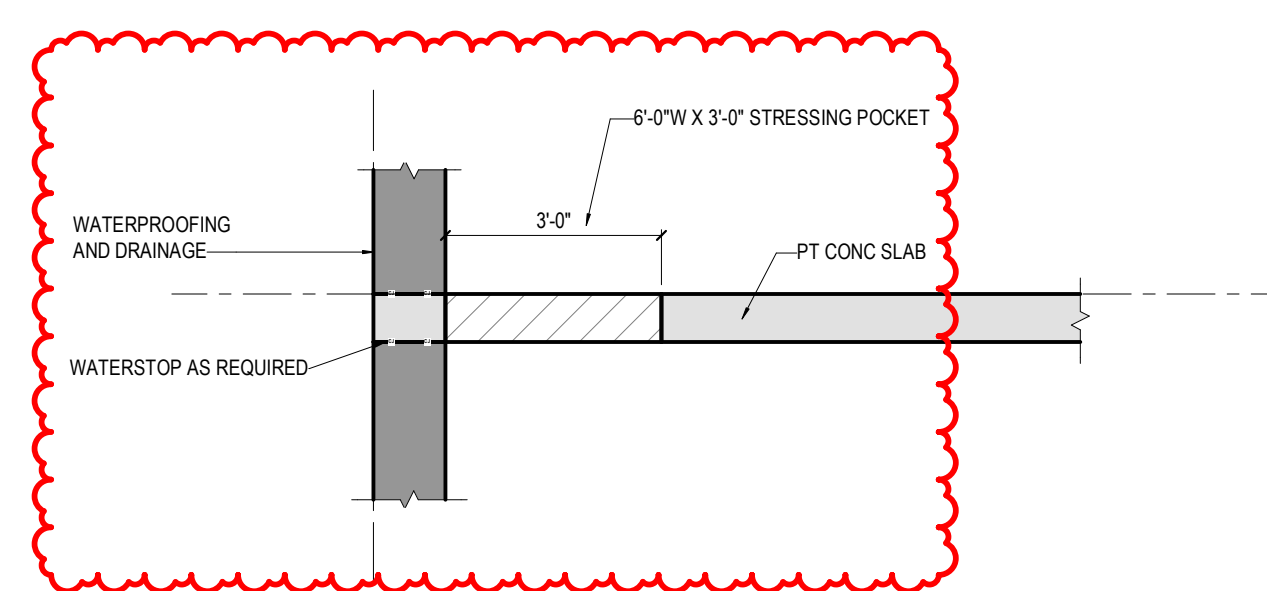


5 TYPICAL STRSSING POCKET

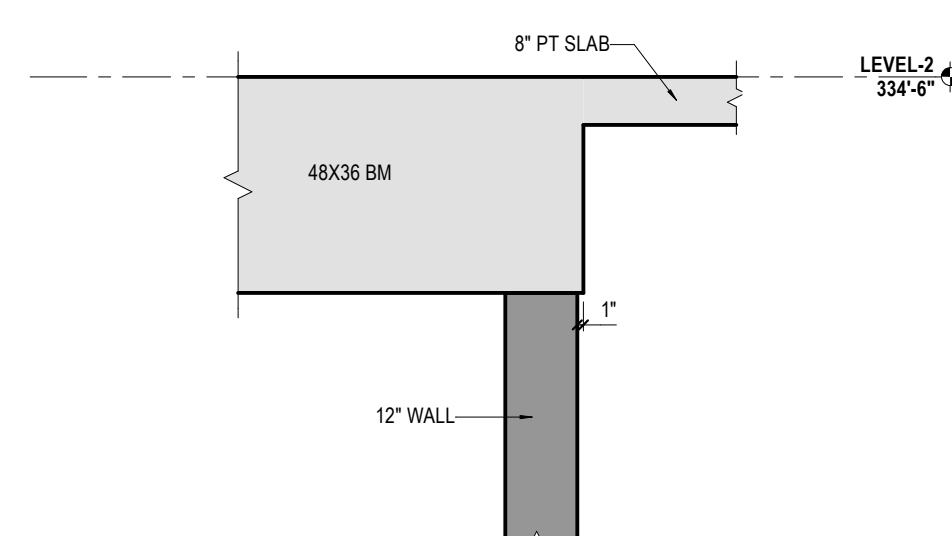


4 BEAM AT THE WALL LOCATION

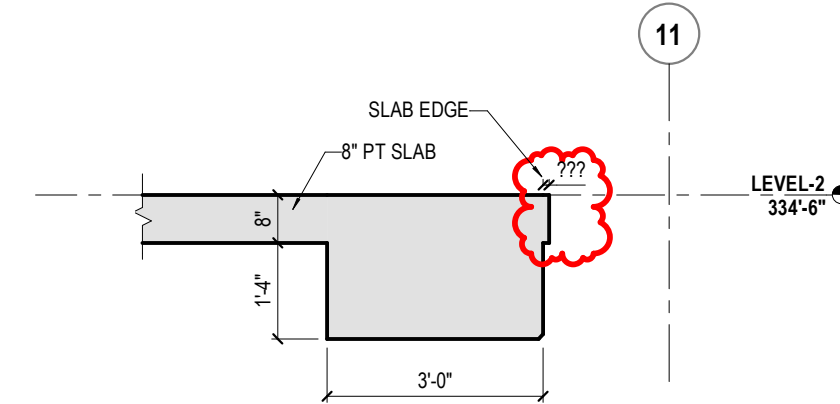


3 TYP EXTERIOR BEAM

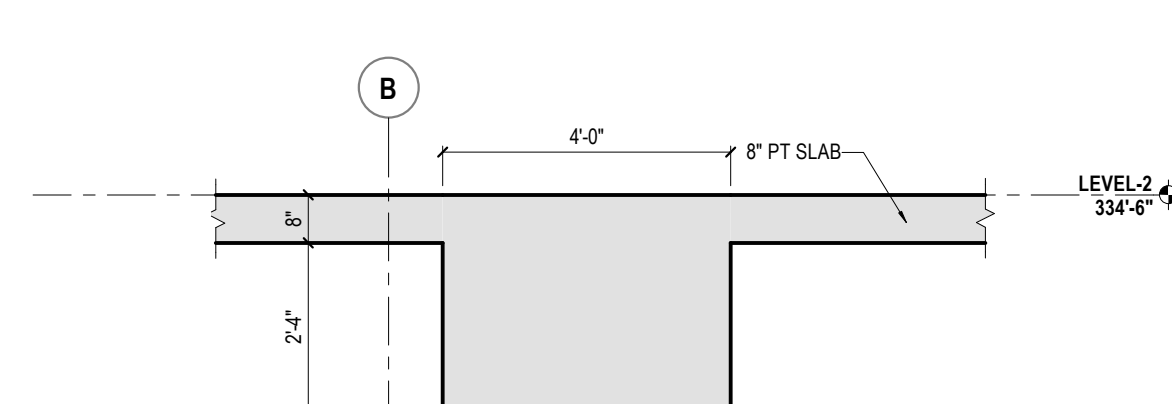


2 TYP INTERIOR BEAM

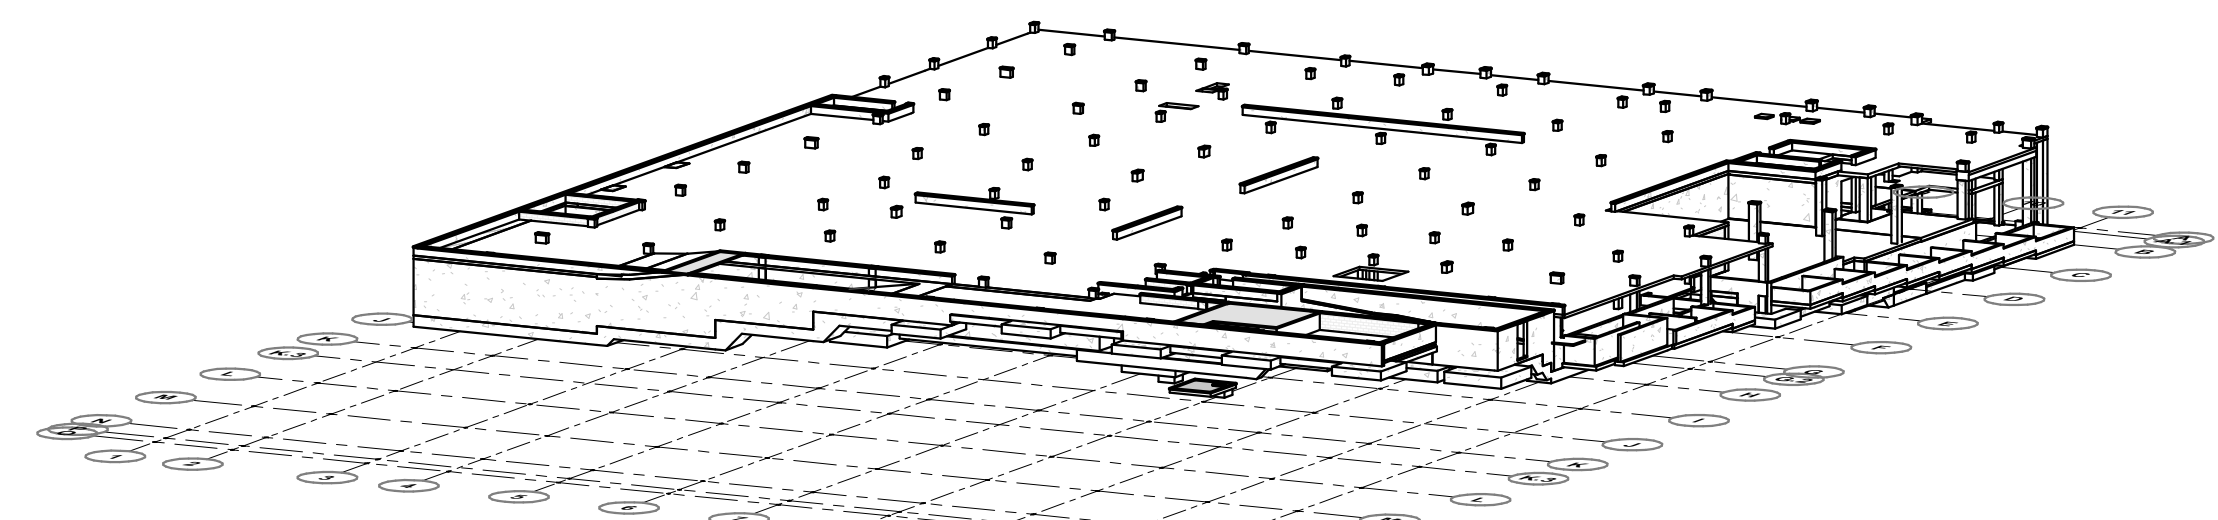


3D VIEW LEVEL-2

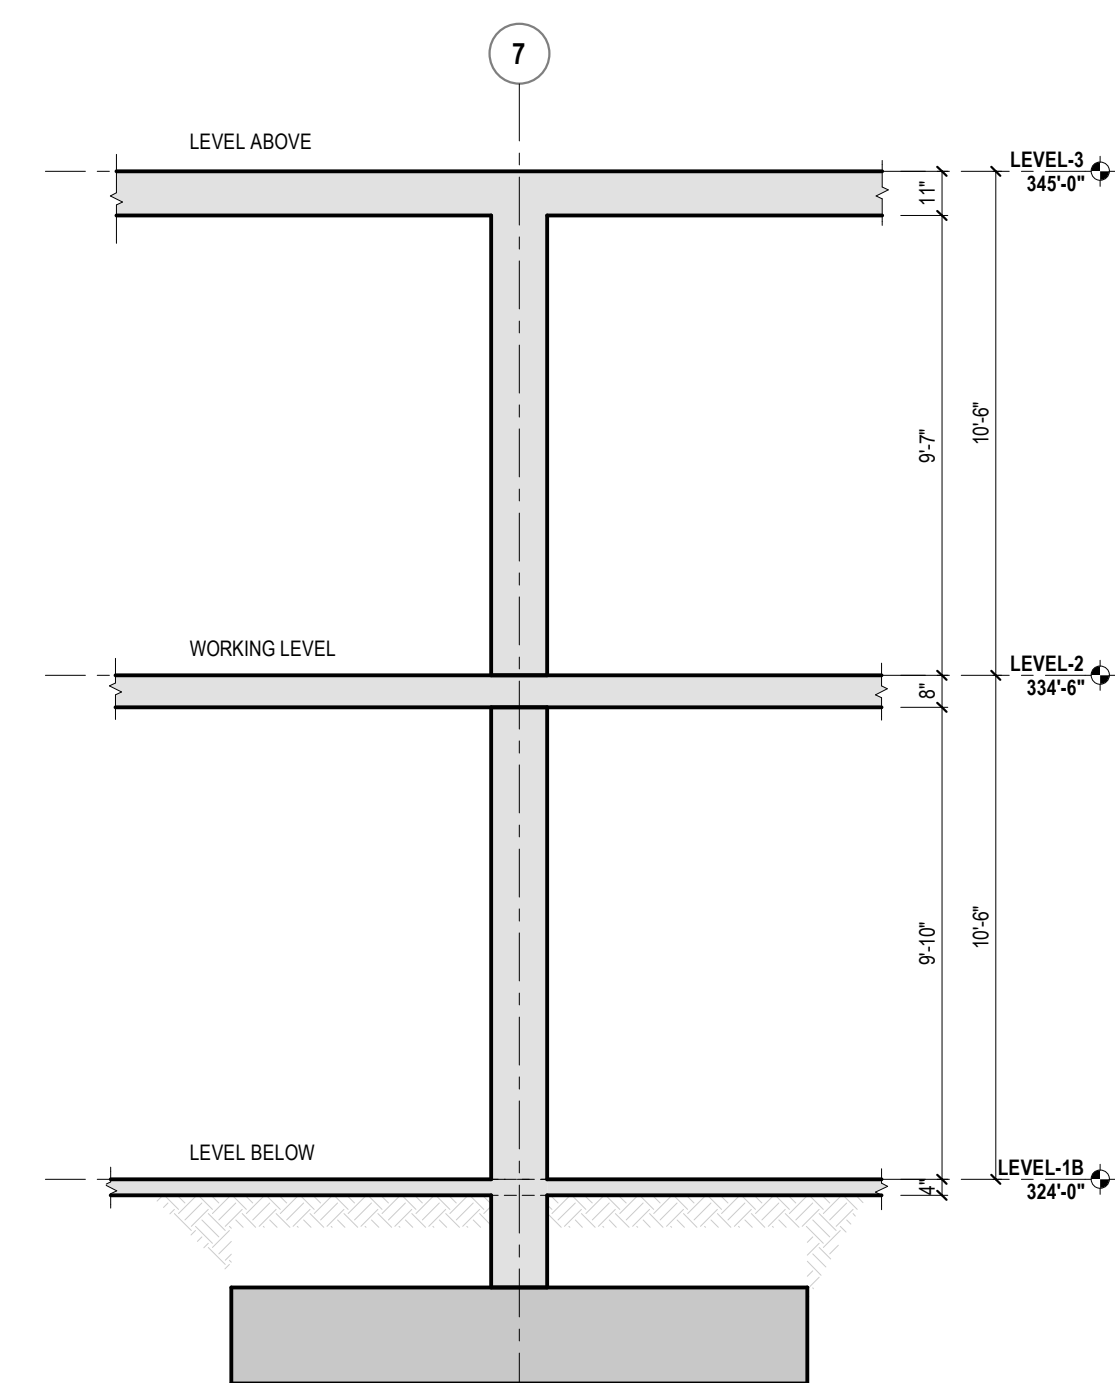

7 BUILDING SECTION LEVEL-2 NORTH

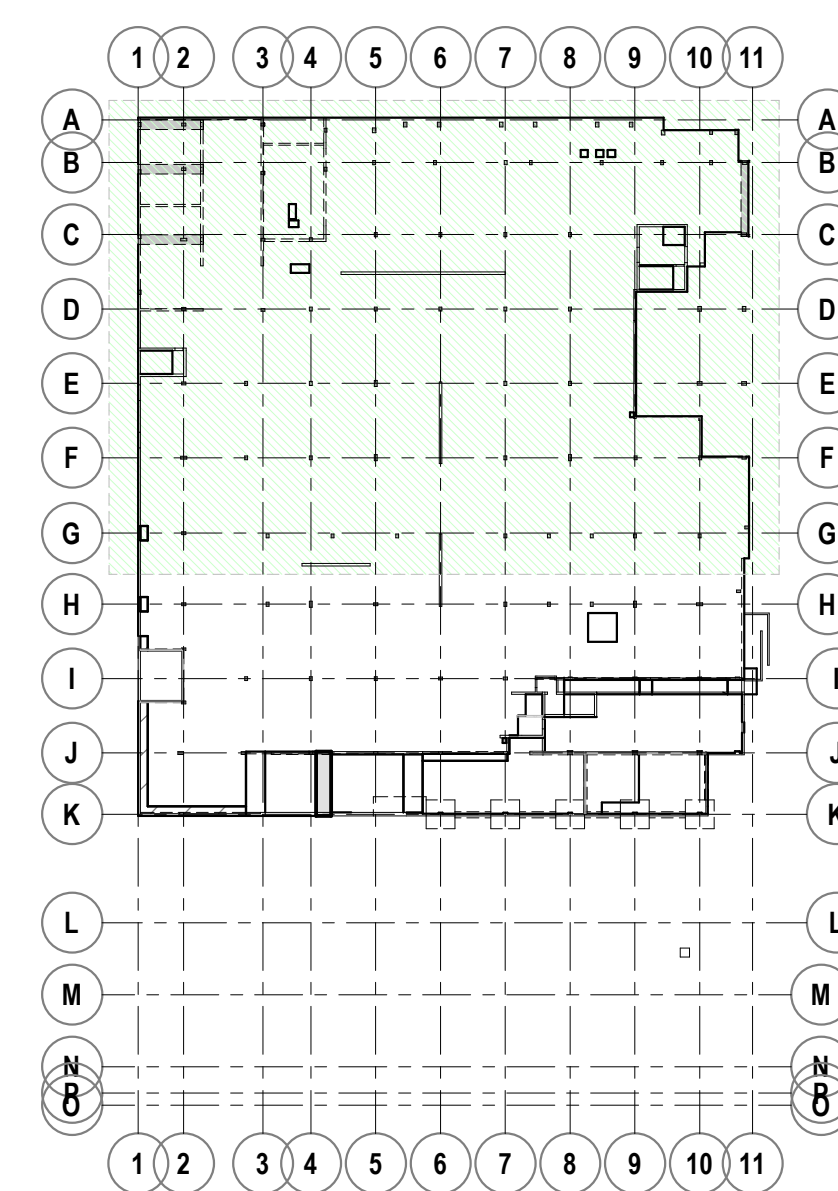

LEVEL-2 KEY PLAN NORTH

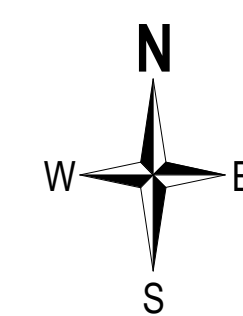

NOTES:

1. 3/4" CHAMFER ON ALL EXPOSED CONCRETE CORNERS TYP.
2. ALL COLUMNS ARE CENTERED ON GRID LINES U.N.O.
3. ALL BEAMS ARE CENTERED ON GRID LINES U.N.O.
4. SLAB THICKNESS IS 8" TYP. U.N.O.
5. LEVEL 2 ELEVATION = 334'-6"

LEGEND

SYMBOLS		SHADE DESIGNATIONS	
1-X (ROUND-ENDS) TOP OF CONCRETE ELEVATIONS		BEAM OR DROP CAP	
1-X (ROUND-ENDS) TOP OF CONCRETE ELEVATIONS		WALLS OR COLUMNS	
1-X BOTTOM OF CONCRETE ELEVATIONS		CURB WALLS	
1-X (PLAIN VIEWS) TOP SLAB & DEPTH OF CONC. MEMBER		DELAY STRIP OR CLOSURE POUR	
1-X (PLAIN VIEWS) TOP SLAB & DEPTH OF CONC. MEMBER		GRADE OR CURB	
1-X (SOFT FLOPPY) TOP & BOTTOM ELEVATIONS HEIGHT ABOVE REFERENCE LEVEL D: DEPTH OF CONC. MEMBER		Y" PT/MS/CP SLAB	
1-X (SOFT FLOPPY) TOP & BOTTOM ELEVATIONS HEIGHT ABOVE REFERENCE LEVEL D: DEPTH OF CONC. MEMBER		Z" PT/MS/CP SLAB	


SECTION VIEW

ELEVATION VIEW

LINE DESIGNATIONS


- --- INDICATES TOP OF SLAB CHANGE OR EDGE OF SLAB
- --- INDICATES SOFFIT CHANGE
- - C-J - - C-J - - INDICATES CONSTRUCTION JOINT
- --- INDICATES GRID LINE

THIS DRAWING IS FOR THE EXCLUSIVE USE OF MCCLONE CONSTRUCTION COMPANY. ON THE PROJECT ONLY. UTILIZATION OF THIS DRAWING BY OTHER PARTIES WITHOUT THE EXPRESSED WRITTEN CONSENT OF MCCLONE CONSTRUCTION COMPANY IS STRICTLY PROHIBITED.

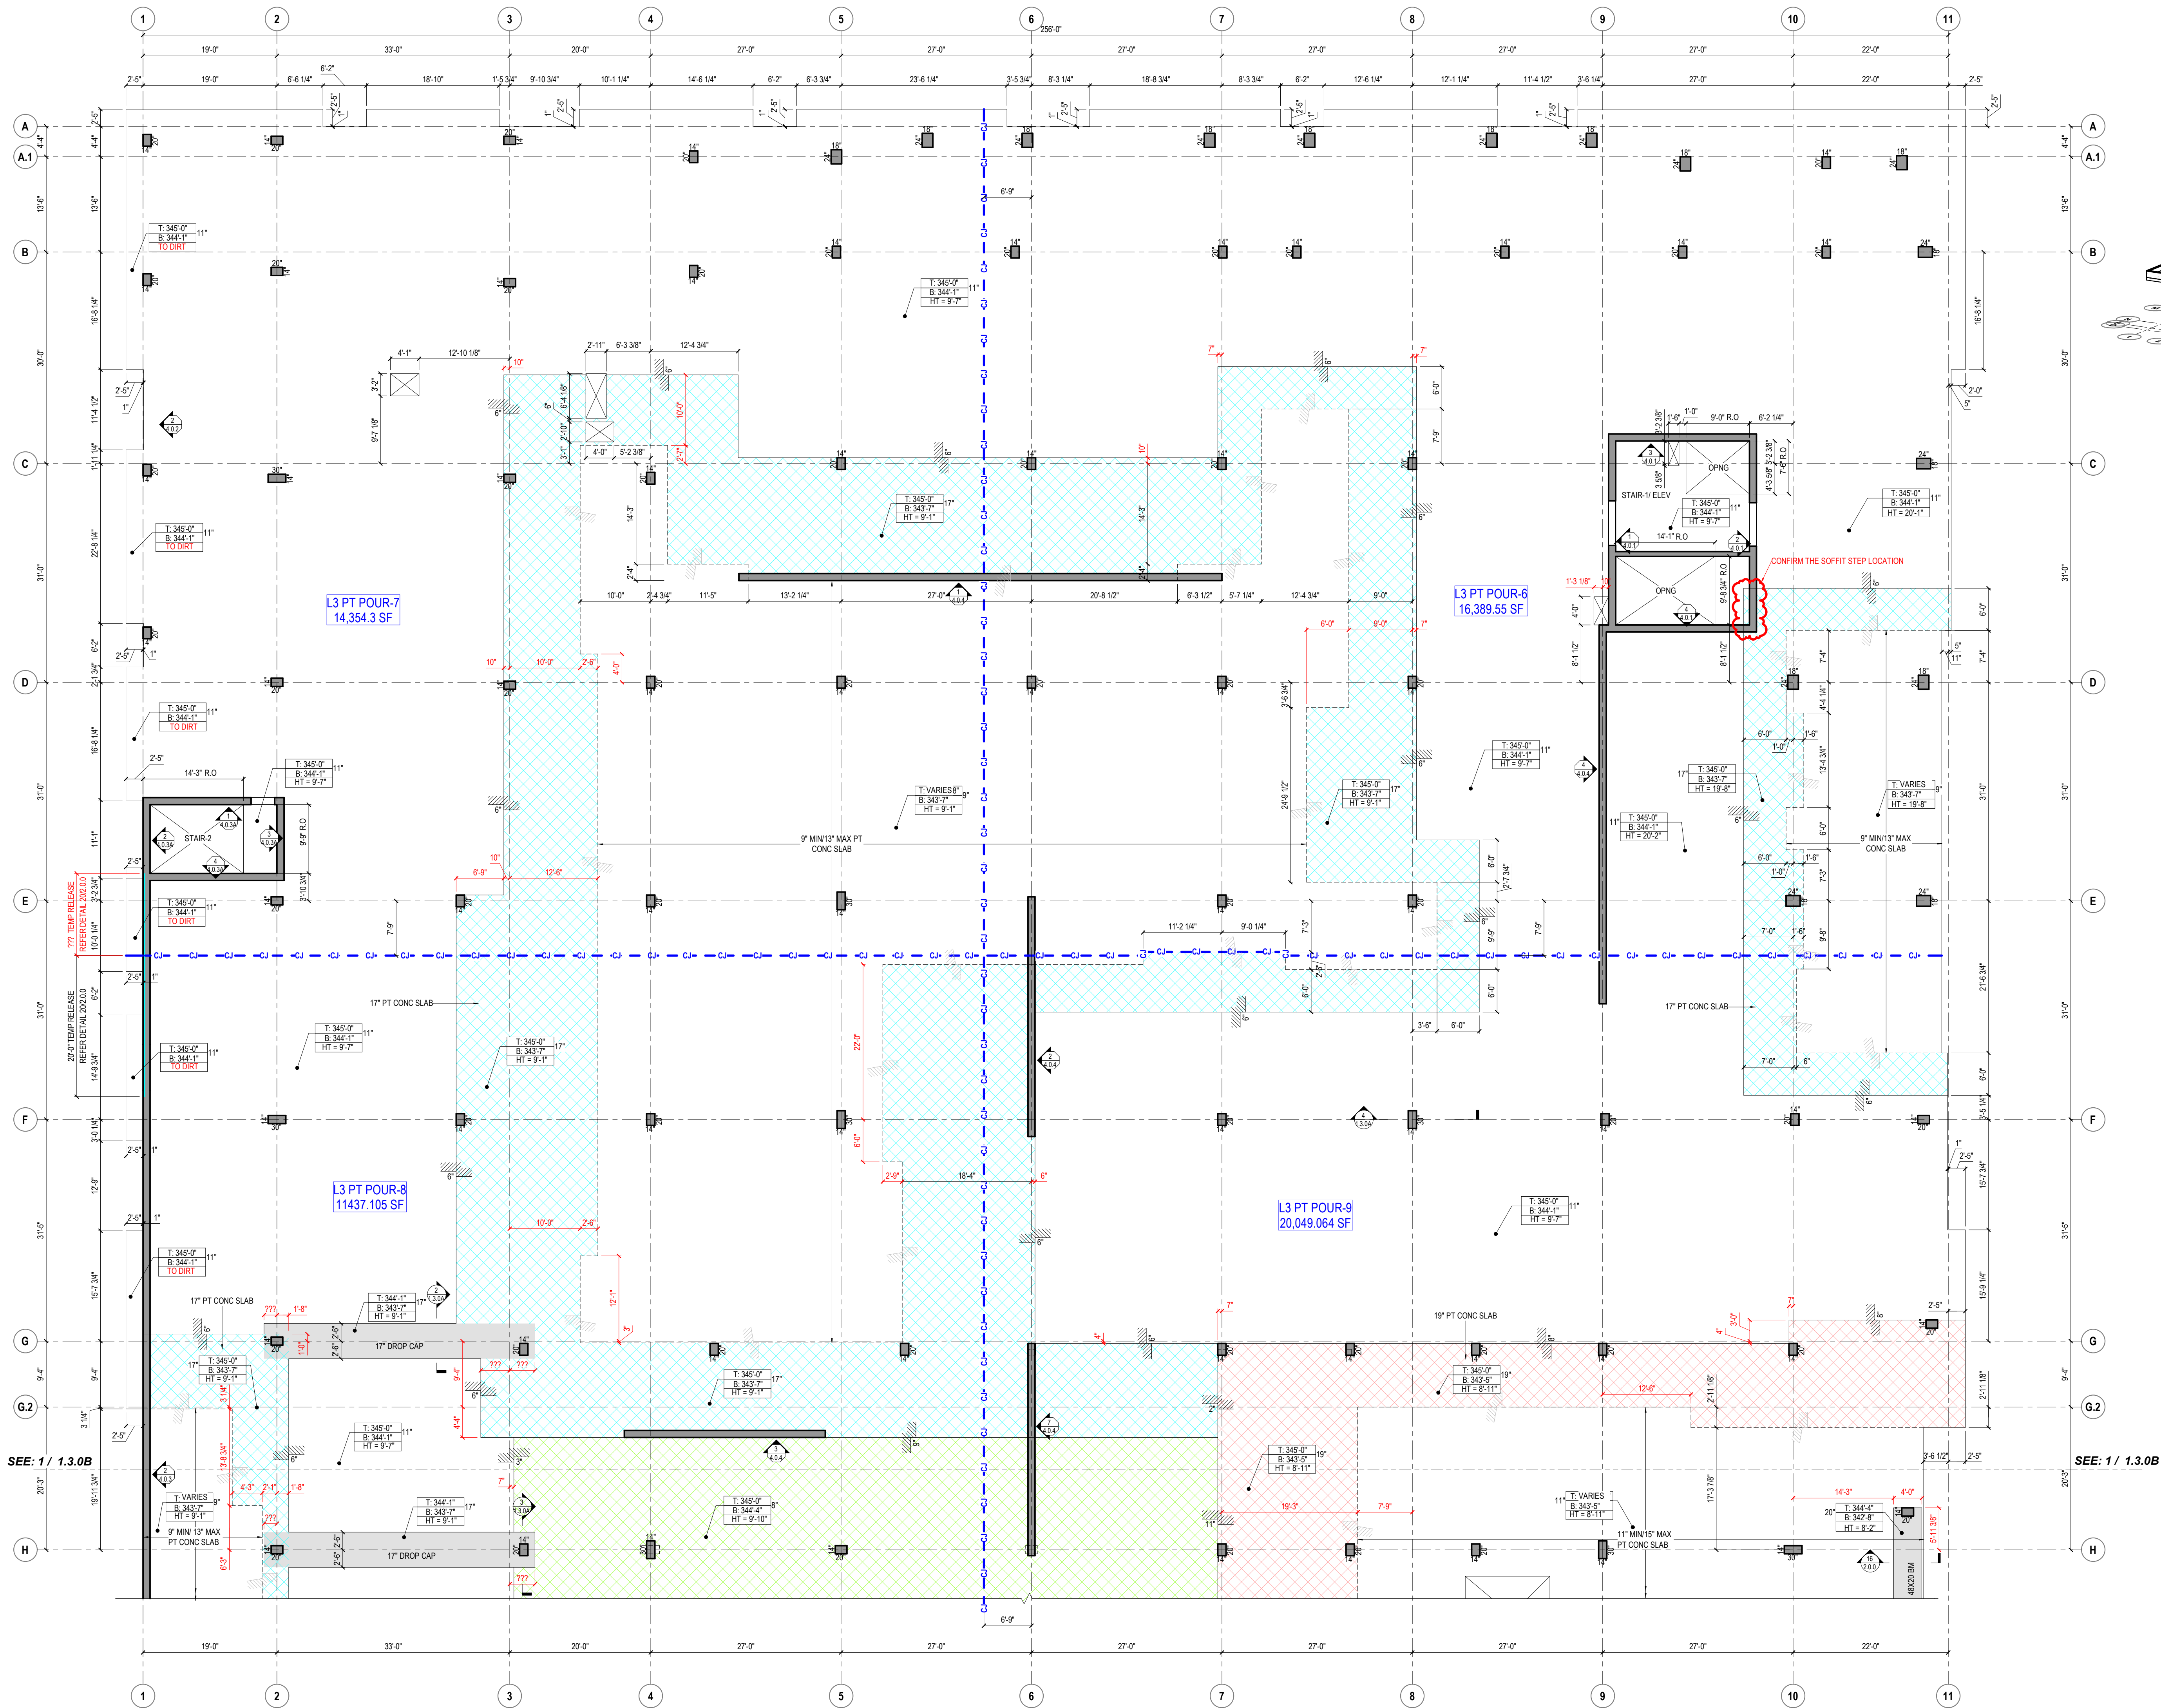


1 LEVEL-3 (SOFFIT PLAN) - NORTH
3/20' x 11/0'


PLEASE PROVIDE / VERIFY THE INFORMATION IN RED

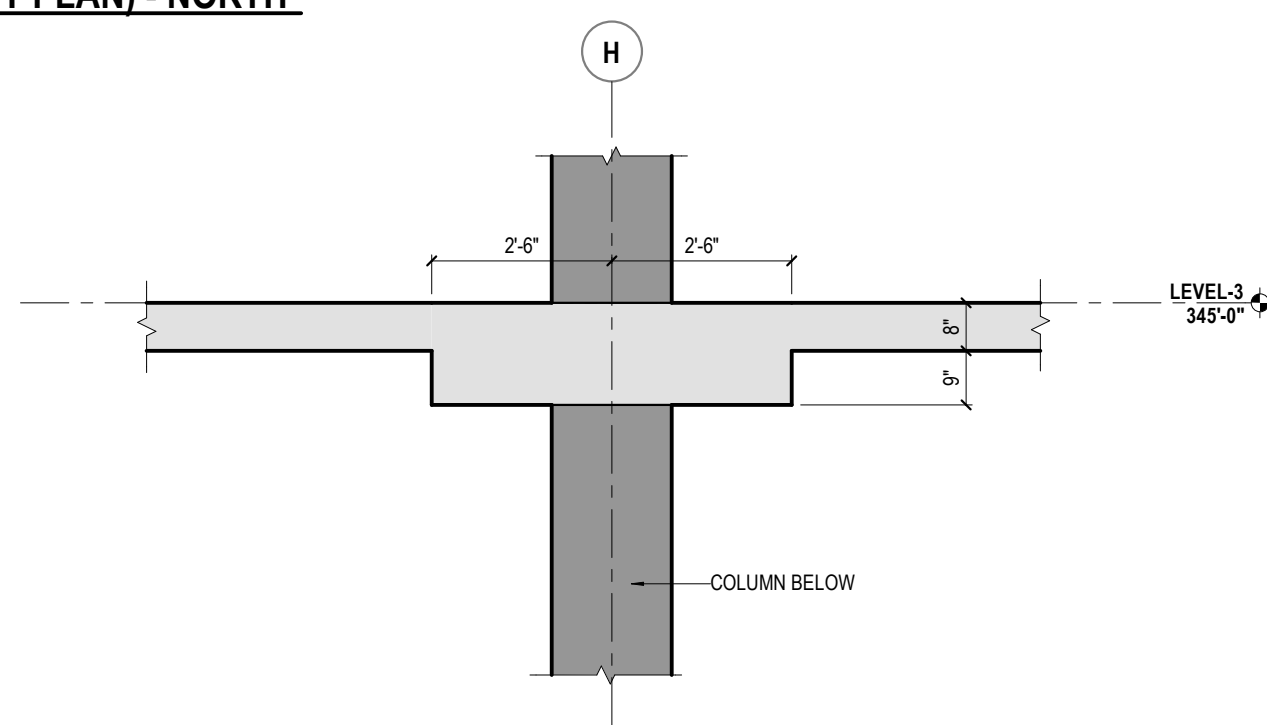


3 SECTION AT DROP CAP SOFFIT STEP
3/2' x 11/0'

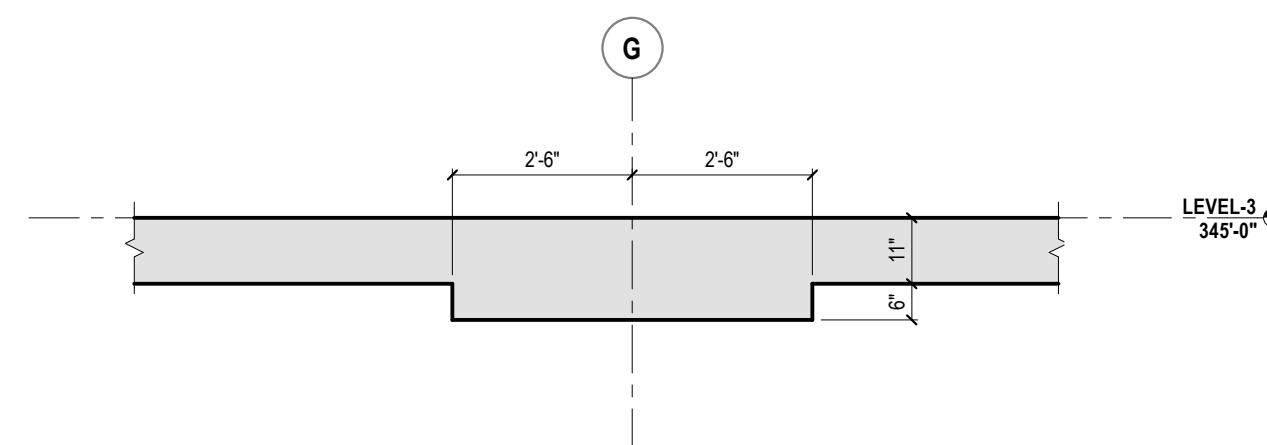


2 SECTION AT DROP CAP
3/2' x 11/0'

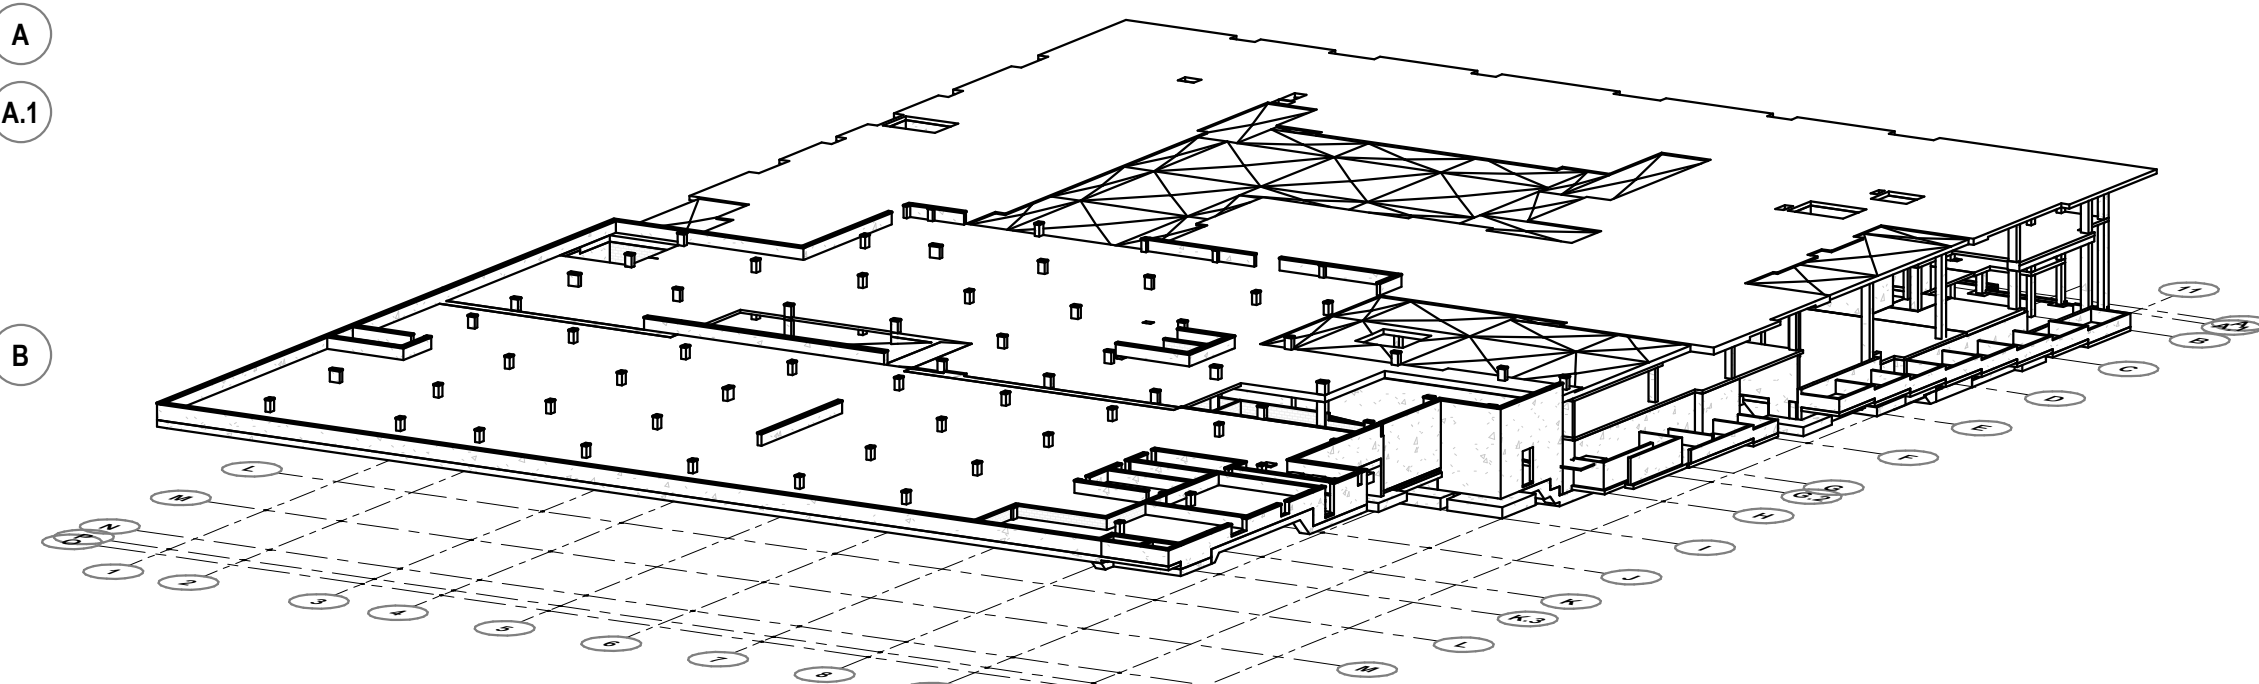


3D VIEW LEVEL-3

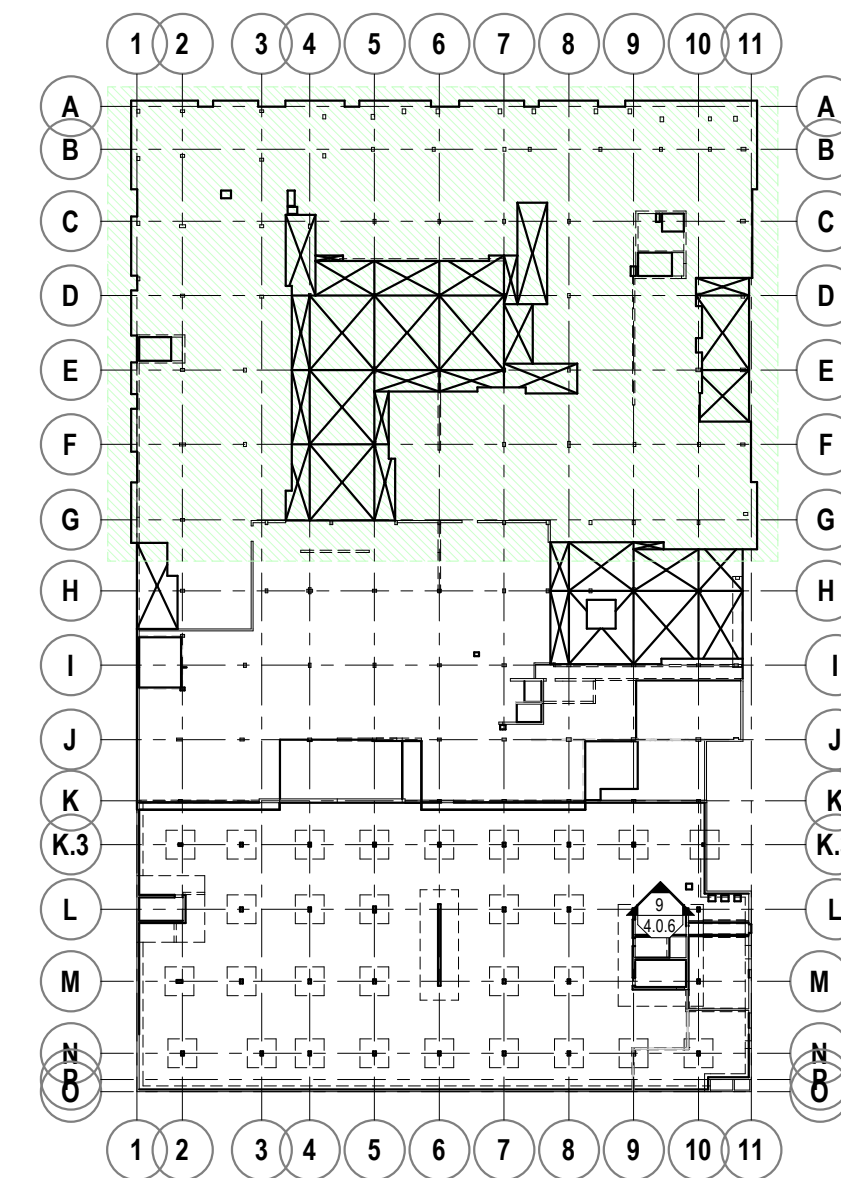

LEVEL-3 KEY PLAN NORTH

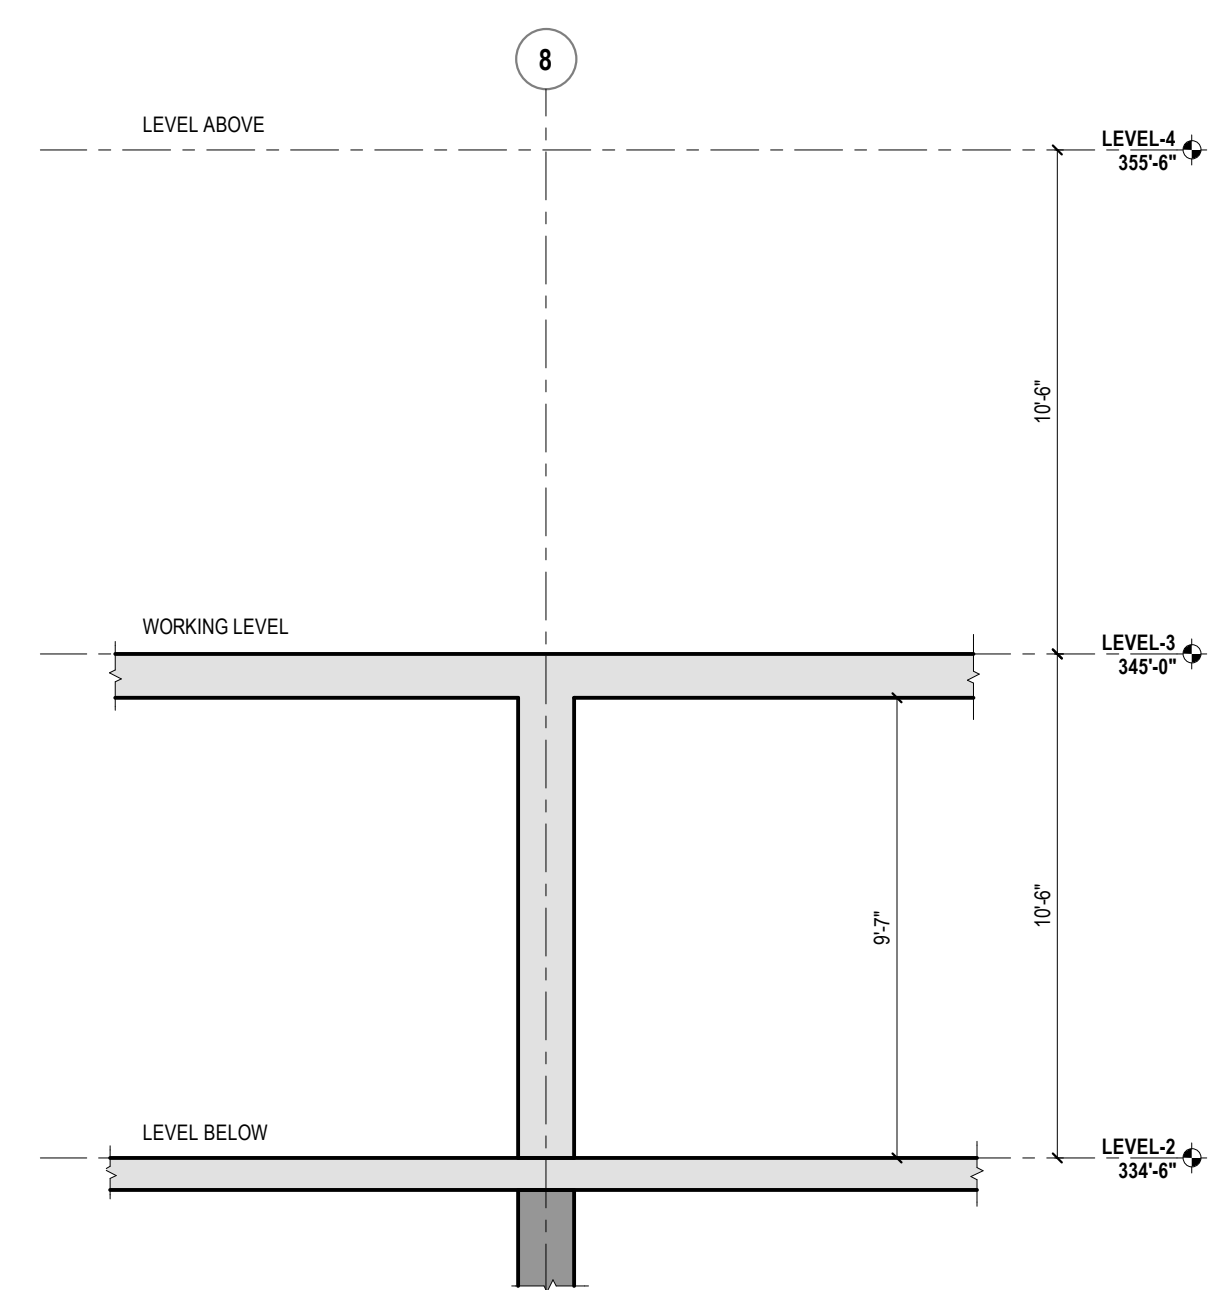

BUILDING SECTION LEVEL-3

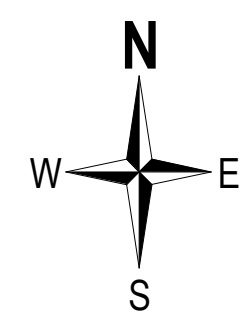

NOTES:

- 3/4" CHAMFER ON ALL EXPOSED CONCRETE CORNERS TYP.
- ALL COLUMNS ARE CENTERED ON GRID LINES U.N.O.
- ALL BEAMS ARE CENTERED ON GRID LINES U.N.O.
- SLAB THICKNESS IS 11" TYP. U.N.O.
- LEVEL 3 ELEVATION = 345'-0"


LEGEND

SYMBOLS		SHAPE DESIGNATIONS	
1-BOX (ROUND ENDS)	TOP OF CONCRETE ELEVATIONS	BEAM OR DROP CAP	
1-BOX	BOTTOM OF CONCRETE ELEVATIONS	WALLS OR COLUMNS	
2-BOX (PLAN VIEWS)	TOP & BOTTOM ELEVATIONS	CHU WALLS	
2-BOX (SOFFIT PLANS)	TOP & BOTTOM ELEVATIONS	DELAY STRIP OR CLOSURE POUR	
2-BOX (SOFFIT PLANS)	TOP & BOTTOM ELEVATIONS	GRADE OR SOIL	
2-BOX (SOFFIT PLANS)	TOP & BOTTOM ELEVATIONS	1" PTMS/CP SLAB	
2-BOX (SOFFIT PLANS)	TOP & BOTTOM ELEVATIONS	2" PTMS/CP SLAB	
2-BOX (SOFFIT PLANS)	TOP & BOTTOM ELEVATIONS	LINE DESIGNATIONS	
2-BOX (SOFFIT PLANS)	TOP & BOTTOM ELEVATIONS	INDICATES TOP OF SLAB CHANGE OR EDGE OF SLAB	
2-BOX (SOFFIT PLANS)	TOP & BOTTOM ELEVATIONS	INDICATES SOFFIT CHANGE	
2-BOX (SOFFIT PLANS)	TOP & BOTTOM ELEVATIONS	INDICATES CONSTRUCTION JOINT	
2-BOX (SOFFIT PLANS)	TOP & BOTTOM ELEVATIONS	INDICATES GRID LINE	


McCLONE
CONSTRUCTION
SINCE 1975
2850 MAPLE VALLEY BLVD. SUITE 200
MAPLE VALLEY, WA 98043-4250

LEVEL-3 (SOFFIT PLAN) - NORTH
KINETIC @ GRESHAM
1010 NW 12TH ST GRESHAM, OR 97030

DATE: 08/05/2026
DRAWN BY: YK
CHECKED BY: 1326
SHEET: 13.0A
TOTAL SHEETS: 13

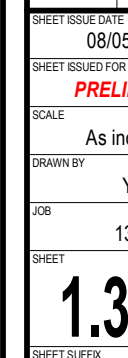


THIS DRAWING IS FOR THE EXCLUSIVE USE OF MCCLONE CONSTRUCTION COMPANY. ON THE PROJECT ONLY. UTILIZATION OF THIS DRAWING BY OTHER PARTIES AND/OR ON OTHER PROJECTS WITHOUT THE EXPRESSED WRITTEN CONSENT OF MCCLONE CONSTRUCTION COMPANY IS STRICTLY PROHIBITED.

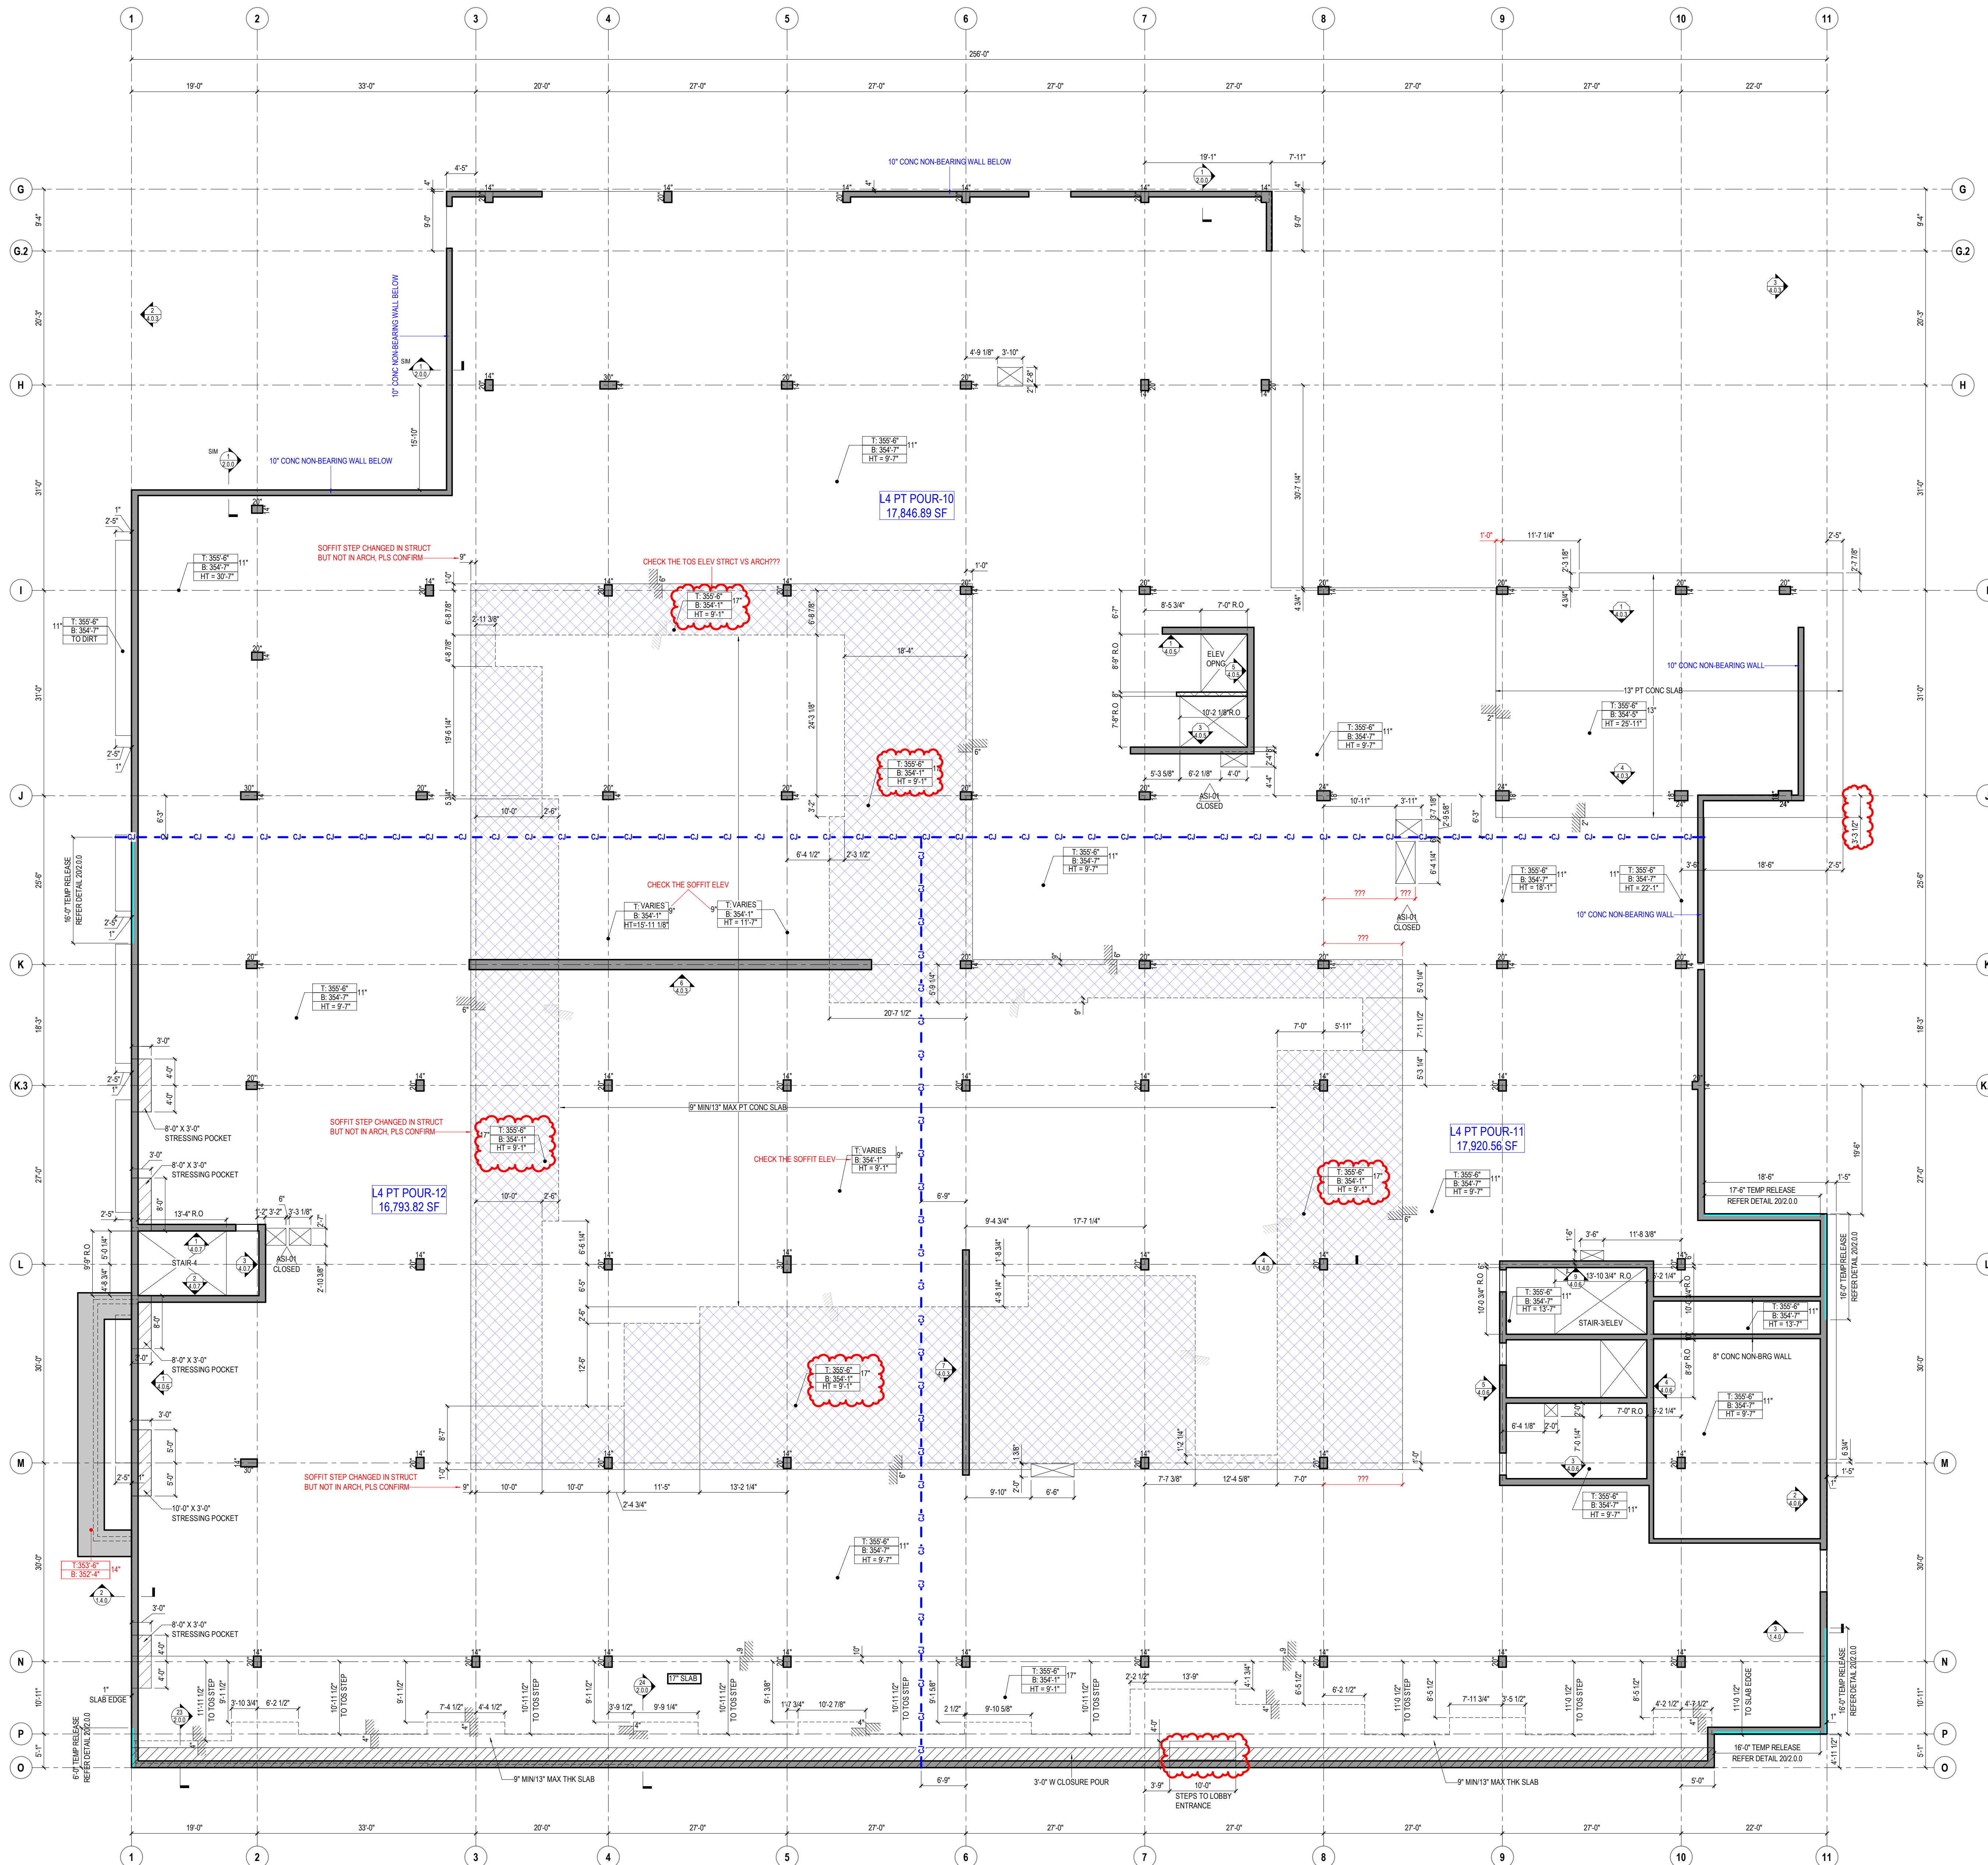


1 LEVEL-4 (SOFFIT PLAN) - SOUTH


PLEASE PROVIDE / VERIFY THE INFORMATION IN RED

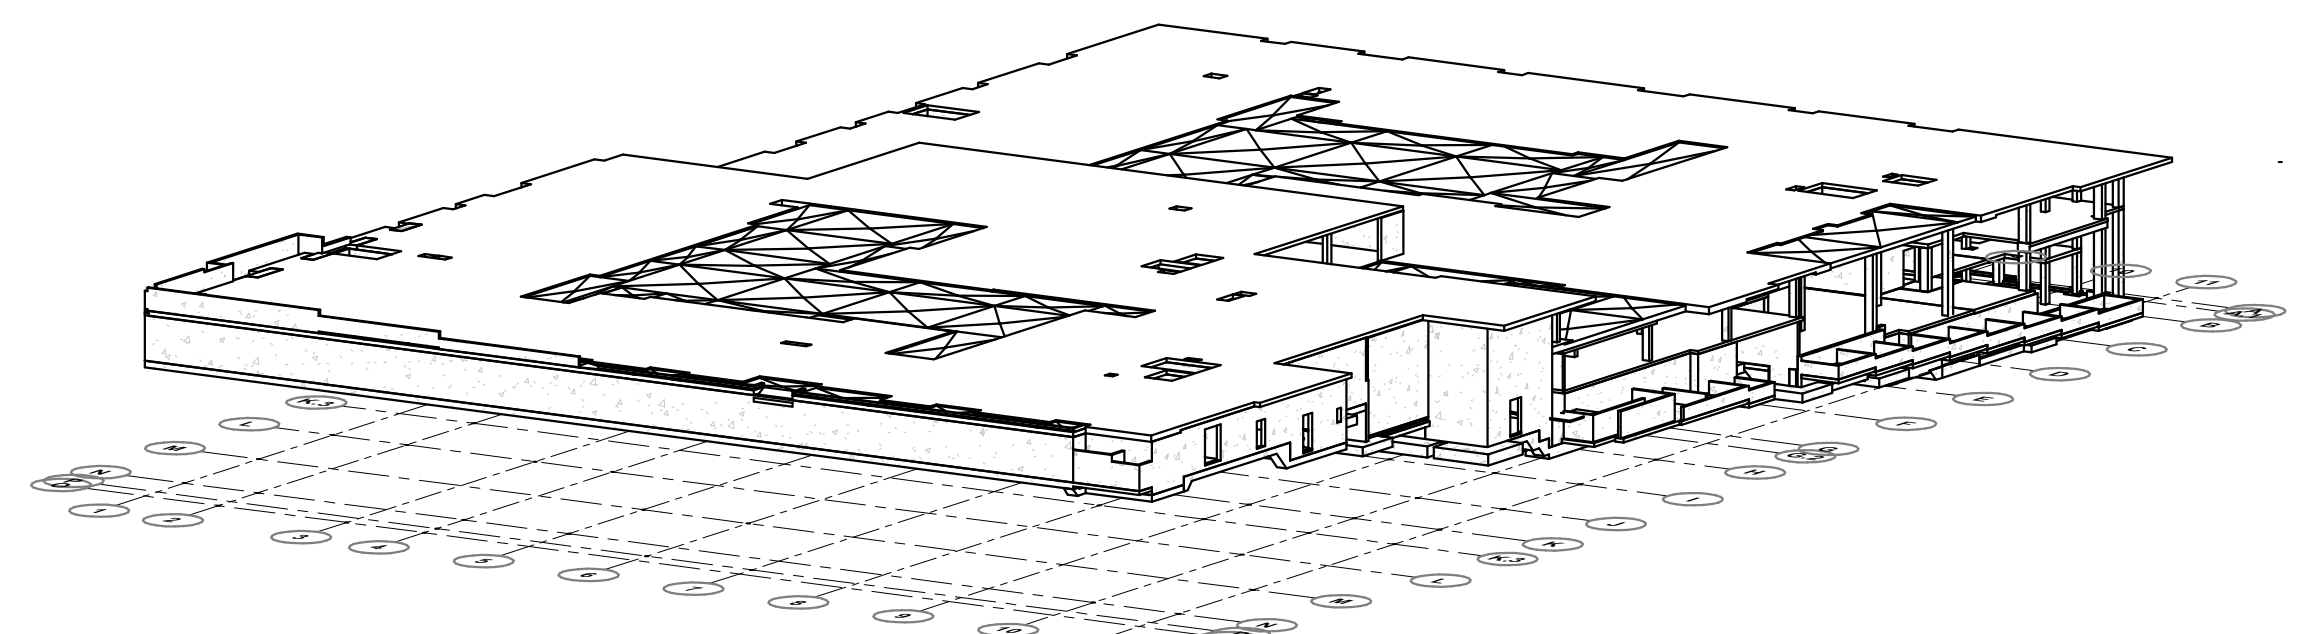


3D VIEW LEVEL-4

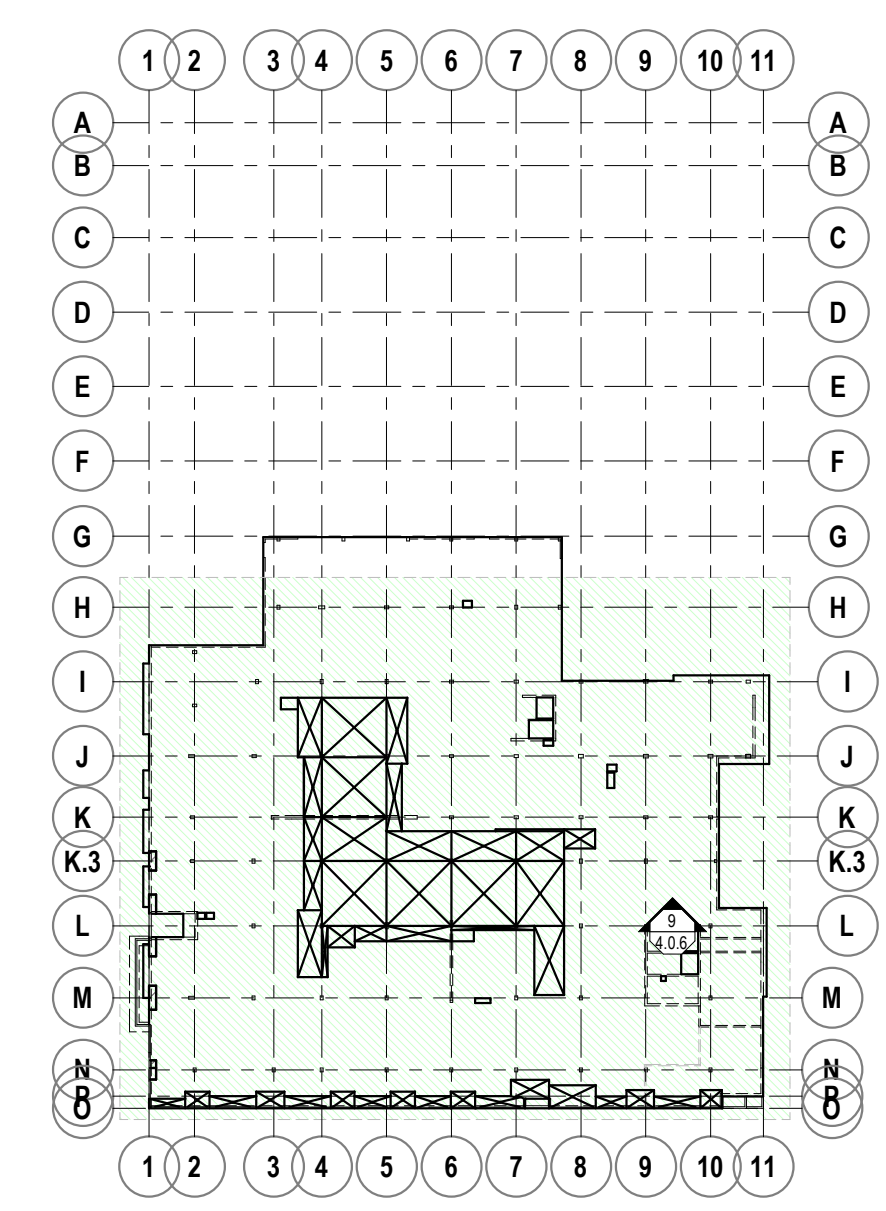

LEVEL-4 KEY PLAN SOUTH

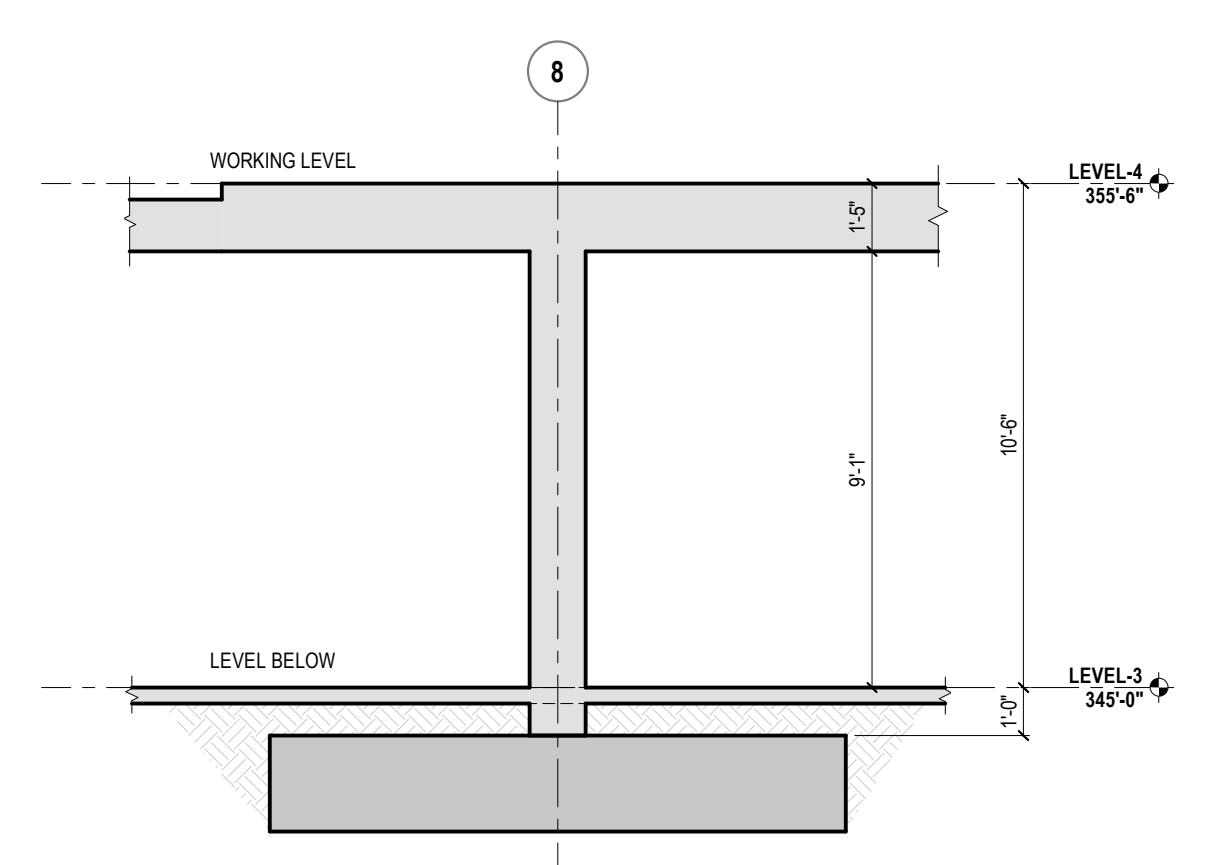

4 BUILDING SECTION LEVEL-4

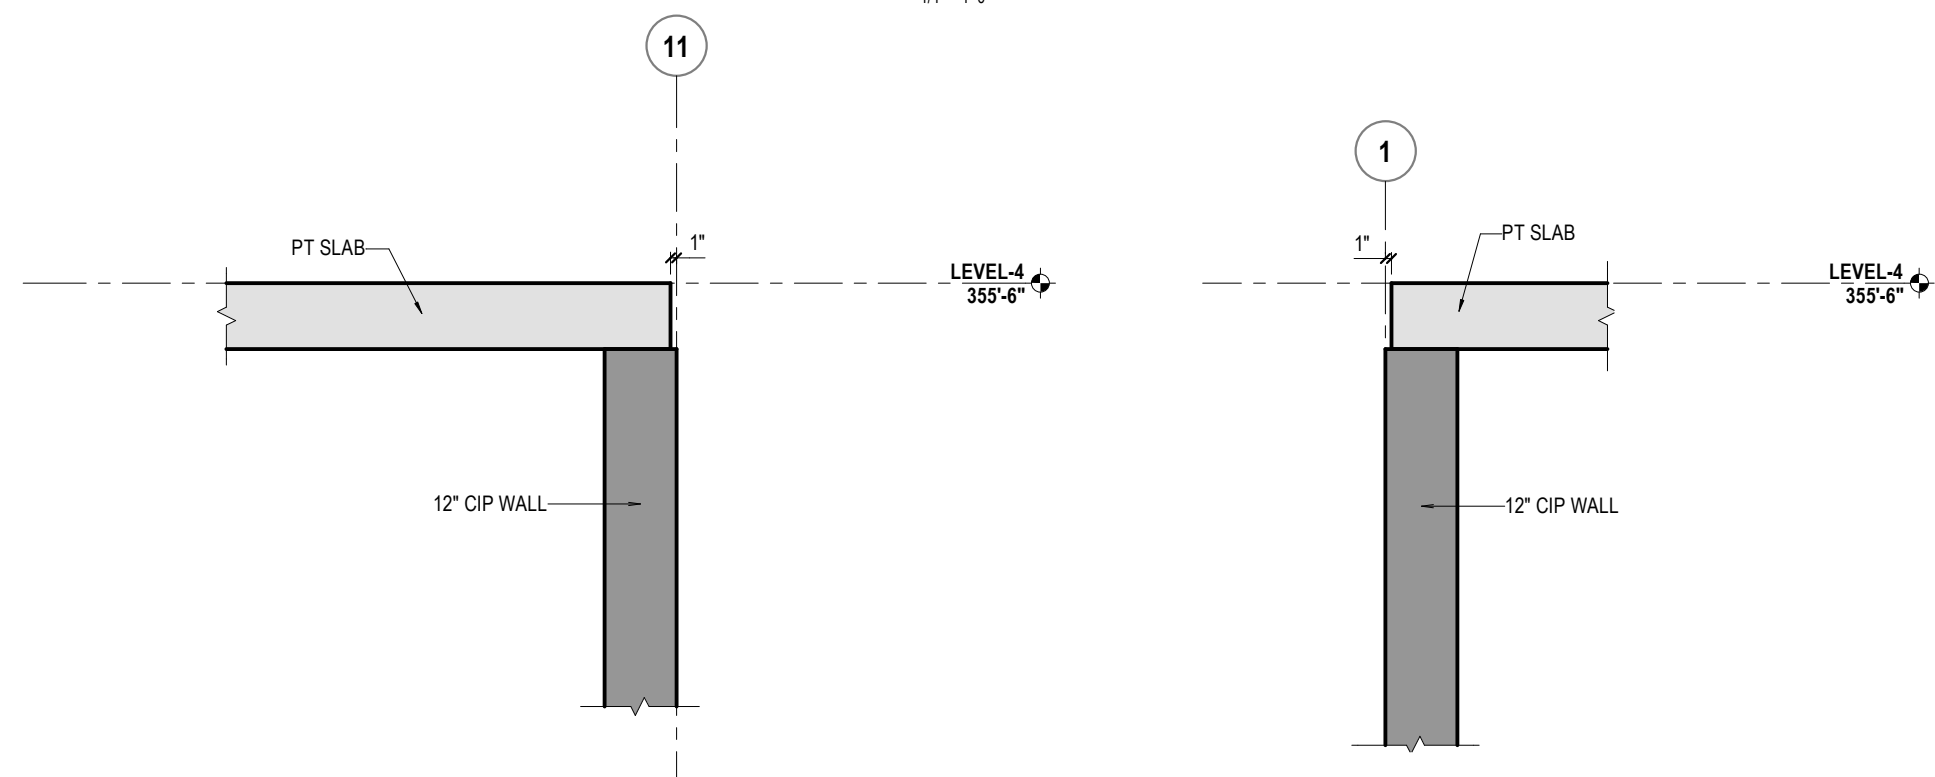

3 SLAB EDGE AT GL-11

2 SECTION AT SLAB EDGE

NOTES:

- 3/4\"/>
- ALL COLUMNS ARE CENTERED ON GRID LINES UNLESS NOTED OTHERWISE.
- ALL BEAMS ARE CENTERED ON GRID LINES UNLESS NOTED OTHERWISE.
- SLAB THICKNESS IS 11\"/>
- LEVEL 3 ELEVATION IS 355'-6\"/>

LEGEND

SYMBOLS	SHAPE DESIGNATIONS
1-BOX (ROUND ENDS) TOP OF CONCRETE ELEVATIONS	BEAM OR DROP CAP
1-BOX BOTTOM OF CONCRETE ELEVATIONS	WALLS OR COLUMNS
2-BOX (PLAN VIEWS) TOP & BOTTOM ELEVATIONS	CONCRETE WALLS
2-BOX (SOFFIT PLANS) TOP & BOTTOM ELEVATIONS	DELAY STRIP OR CLOSURE POUR
2-BOX (SOFFIT PLANS) TOP & BOTTOM ELEVATIONS	GRADE OR SOIL
2-BOX (SOFFIT PLANS) TOP & BOTTOM ELEVATIONS	1\"/>
2-BOX (SOFFIT PLANS) TOP & BOTTOM ELEVATIONS	2\"/>

LINE DESIGNATIONS
--- INDICATES TOP OF SLAB CHANGE OR EDGE OF SLAB
--- INDICATES SOFFIT CHANGE
--- C-J --- INDICATES CONSTRUCTION JOINT
--- INDICATES GRID LINE

McCLONE
CONSTRUCTION
SINCE 1975
2850 MAPLE VALLEY BLVD. SUITE 200
MAPLE VALLEY, WA 98043-4254

LEVEL-4 (SOFFIT PLAN) - SOUTH
KINETIC @ GRESHAM
1010 NW 12TH ST GRESHAM, OR 97030

DATE: 08/05/2025
DRAWN BY: YK
CHECKED BY: 1326
SCALE: 1/4\"/>