

[illegible]

KINECT @ GRESHAM

1010 NW 12TH ST
GRESHAM, OR 97030

DRAWN BY
 MH

CHECKED BY
 EP


DRAWING SET DATE
APRIL 10, 2026

BID ADDENDUM #4

SOUTHEAST CORNER OF SECTION 4,
TOWNSHIP 1 SOUTH, RANGE 3

STRUCTURAL LOADING PLANS

\$0.20

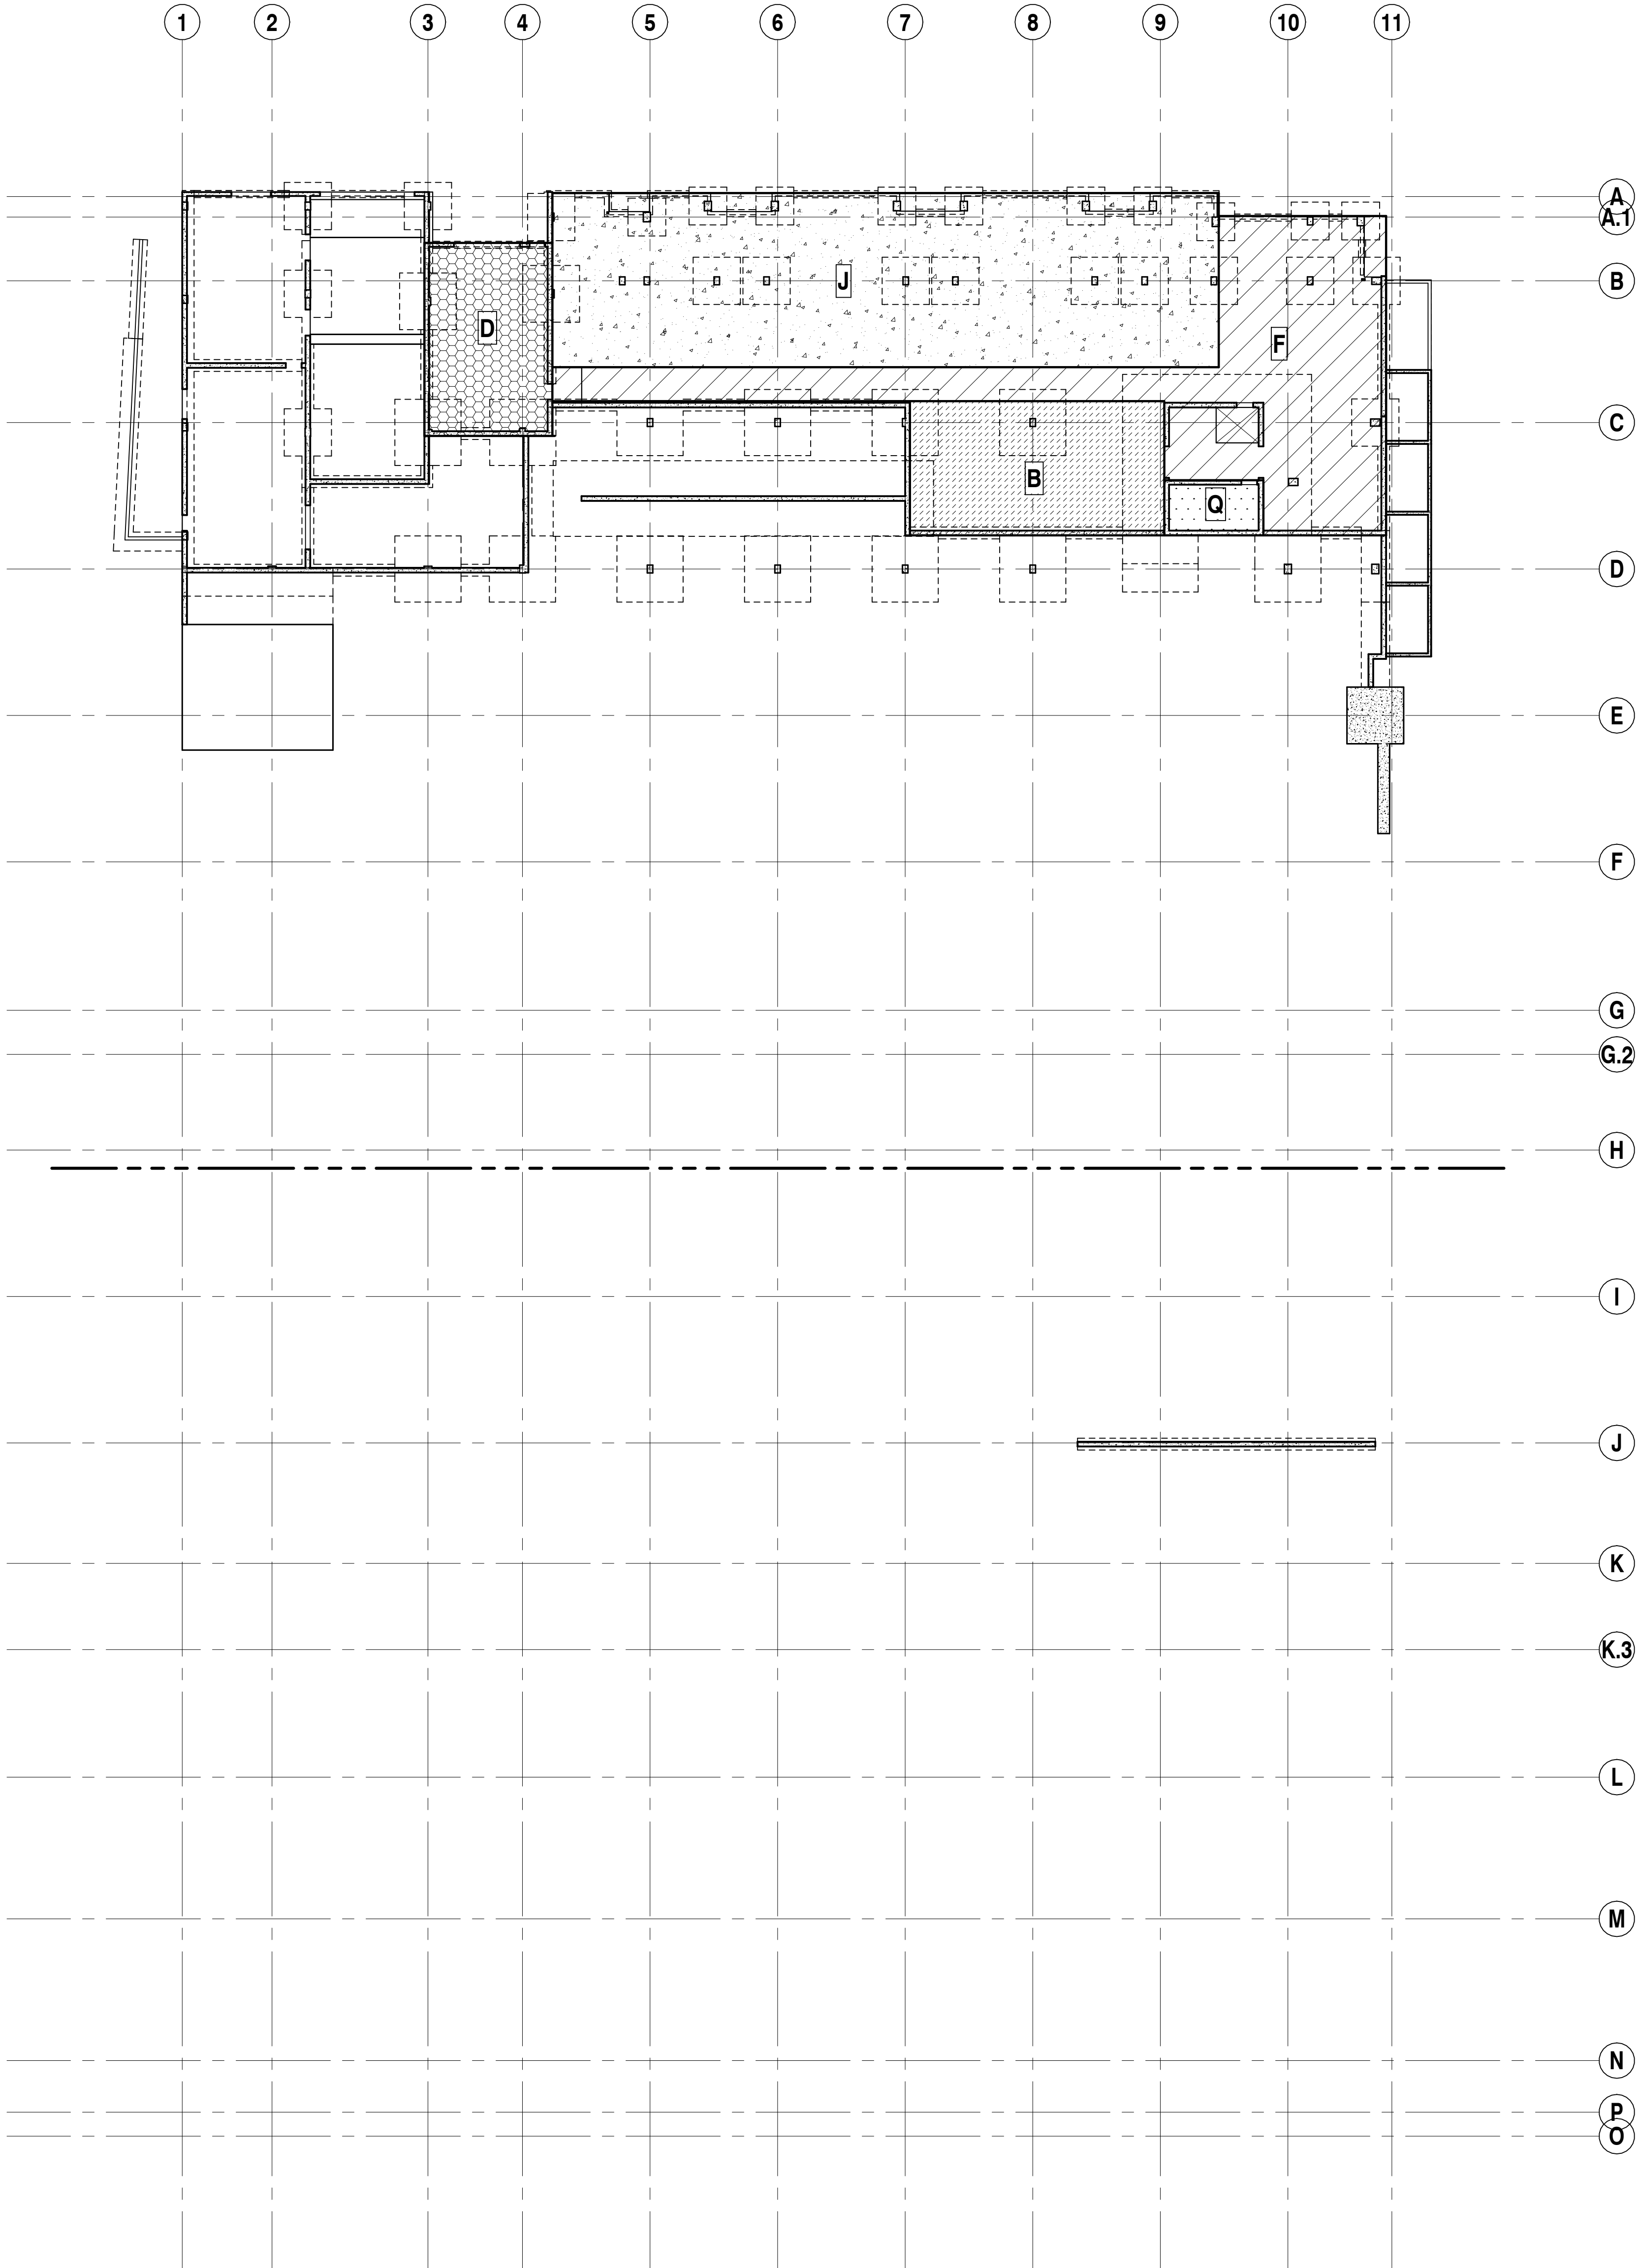


LOAD MAP LEGEND			
DESIGN LOAD LEGEND			
MARK / PATTERN	AREA	ADDED DEAD LOAD	LIVE LOAD
A 	PARKING	5 PSF	40 PSF
B 	MECHANICAL	40 PSF	40 PSF
C 	STORAGE	10 PSF	125 PSF
D 	TRASH ROOM	10 PSF	100 PSF
E 	GENERATOR/TRANSFORMER	150 PSF	20 PSF
F 	RETAIL/FITNESS/LOBBY	15 PSF	100 PSF
G 	LEVEL 3 AND 4 LANDSCAPE	150 PSF	100 PSF
H 	DETENTION VAULT	250 PSF	40 PSF
J 	RESIDENTIAL	CONC = 10 PSF WOOD = 23 PSF	40 PSF
K 	TERRACE	30 PSF	40 PSF
L 	ROOF	17 PSF	25 PSF
M 	ROOF MECHANICAL	35 PSF	25 PSF
Q 	STAIRS/CORRIDOR	15 PSF (STAIRS)	100 PSF

LEVEL 1A LOADING PLAN
SCALE: 1" = 20'-0"




ALL RIGHTS RESERVED. REPRODUCTION OR TRANSLATION OF ANY PART OF THIS WORK WITHOUT WRITTEN PERMISSION OF AMERICAN CAPITAL GROUP IS UNLAWFUL AND SUBJECT TO CRIMINAL PROSECUTION.

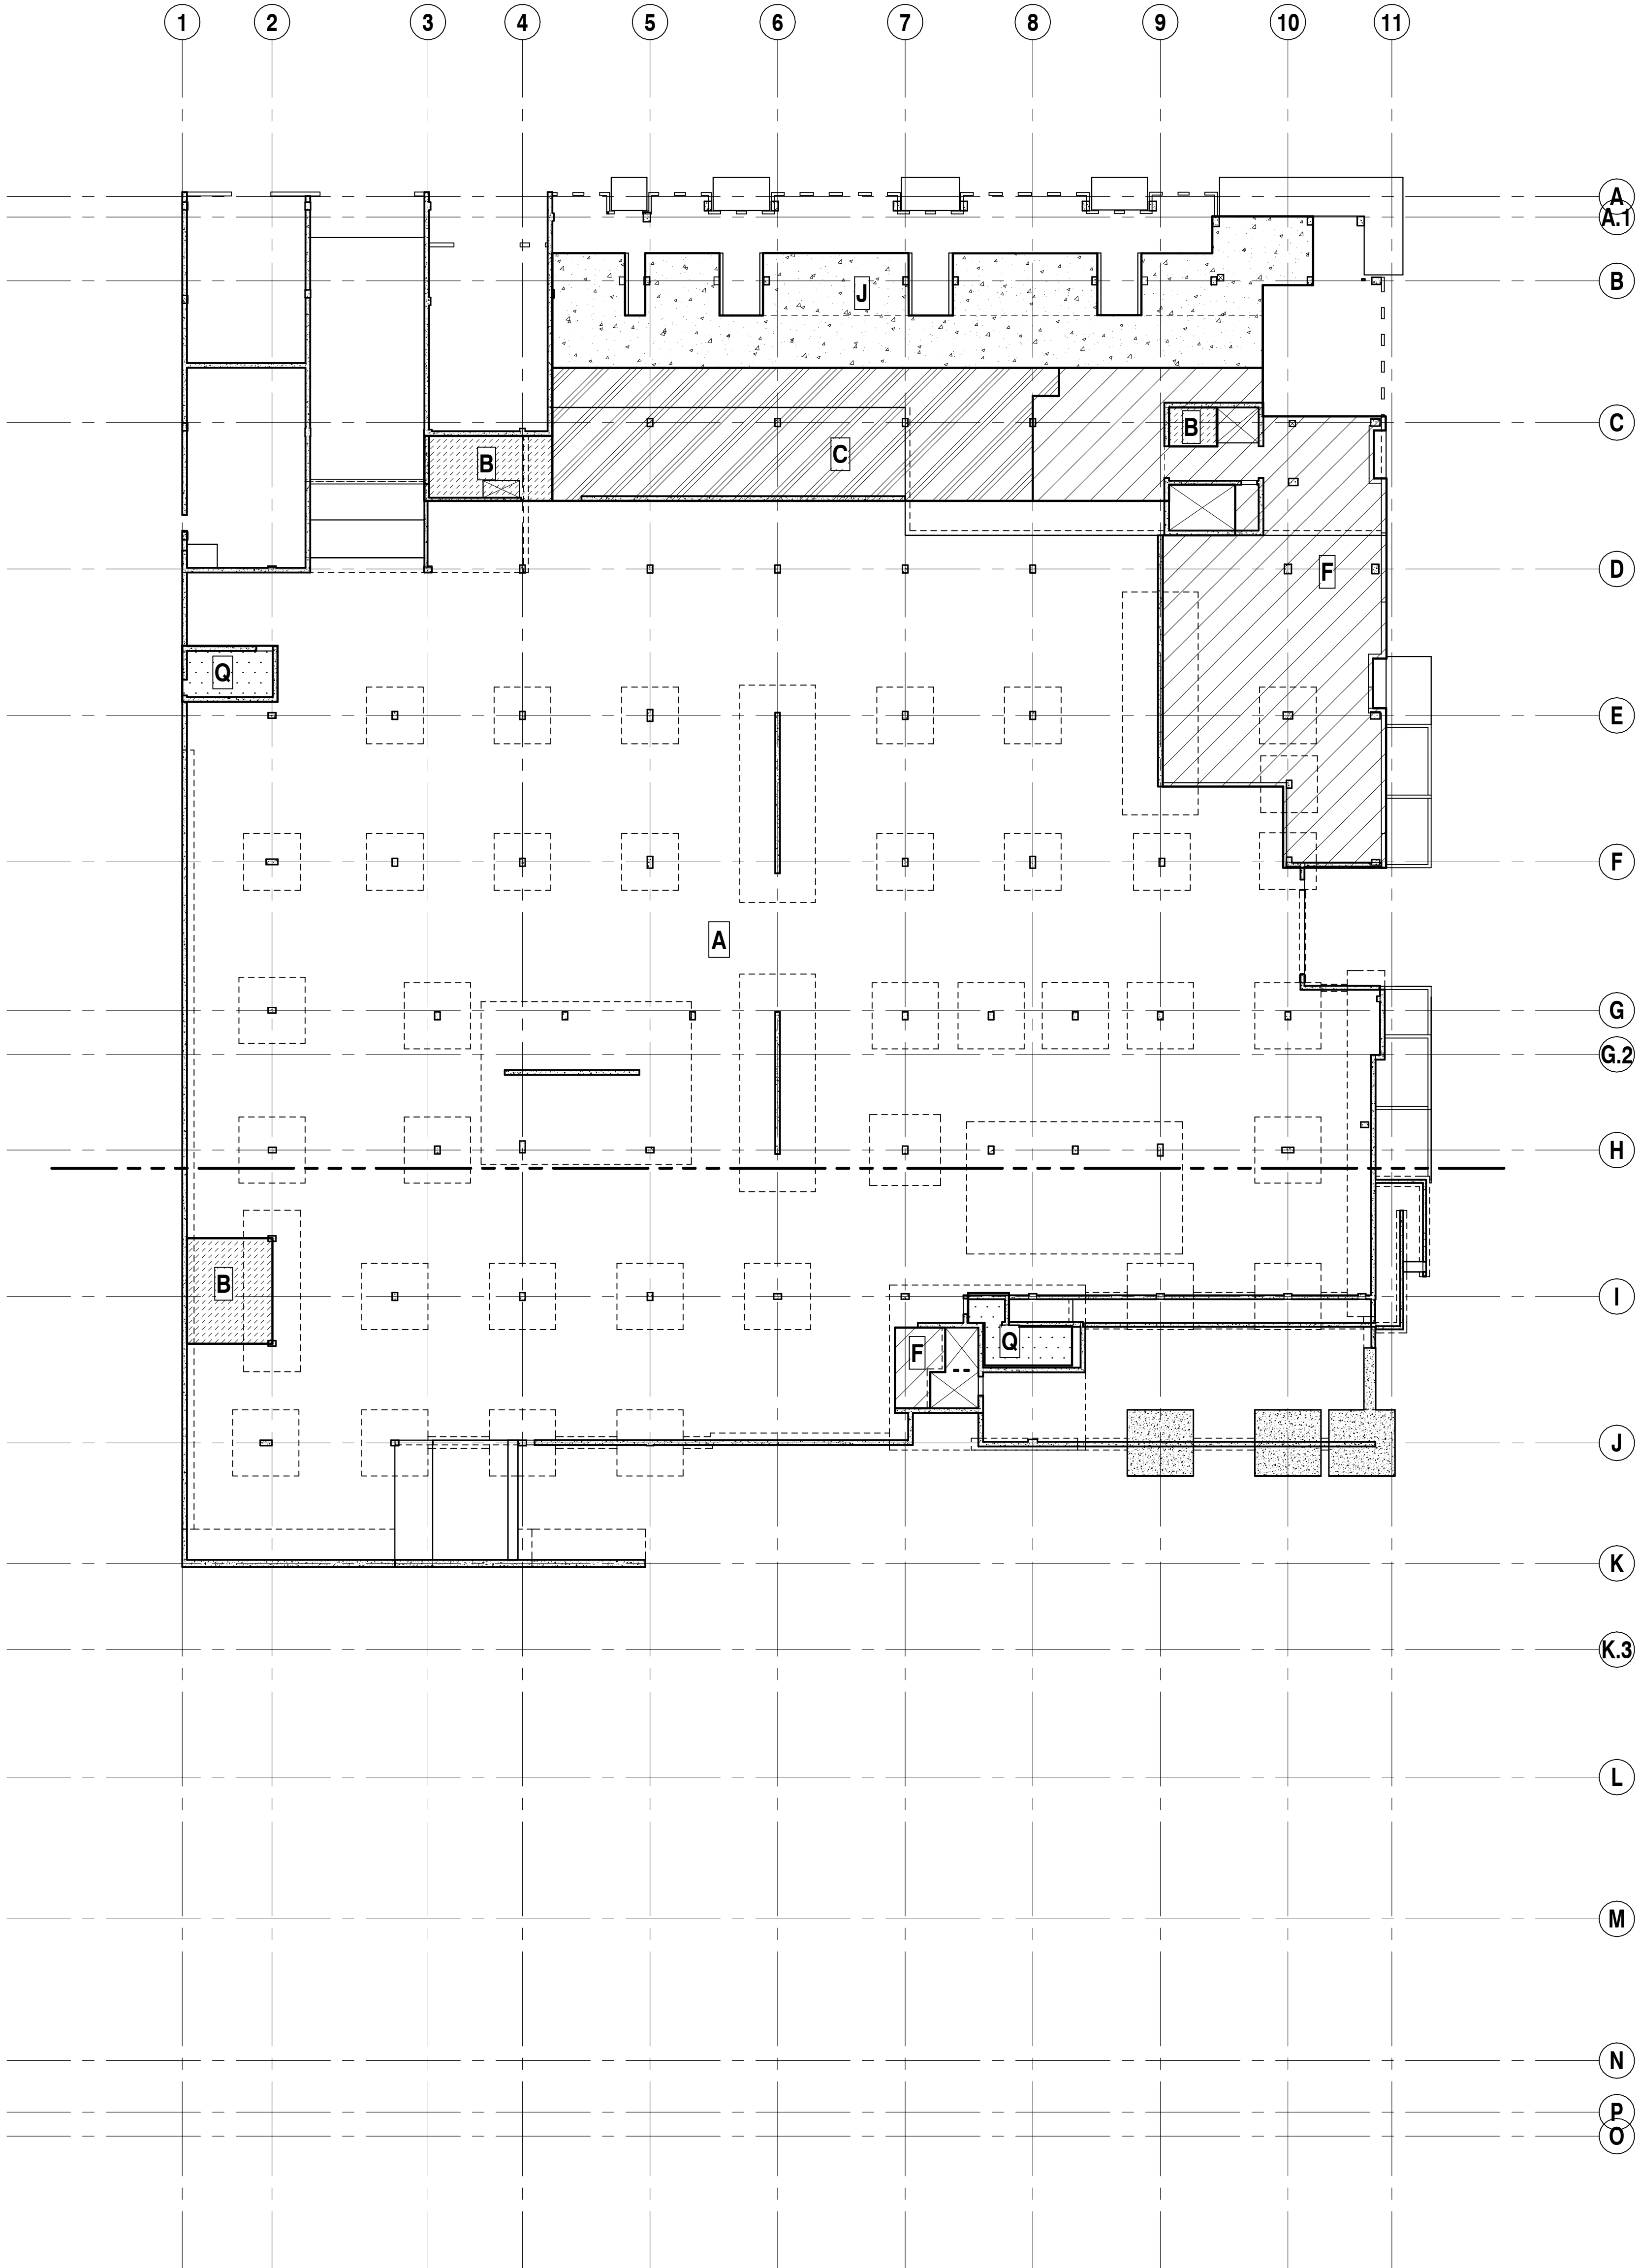

01601 LOAD MAP LEGEND			
DESIGN LOAD LEGEND			
MARK / PATTERN	AREA	ADDED DEAD LOAD	LIVE LOAD
A	PARKING	5 PSF	40 PSF
B	MECHANICAL	40 PSF	40 PSF
C	STORAGE	10 PSF	125 PSF
D	TRASH ROOM	10 PSF	100 PSF
E	GENERATOR/ TRANSFORMER	150 PSF	20 PSF
F	RETAIL/ FITNESS/LOBBY	15 PSF	100 PSF
G	LEVEL 3 AND 4 LANDSCAPE	150 PSF	100 PSF
H	DETENTION VAULT	250 PSF	40 PSF
J	RESIDENTIAL	CONC = 10 PSF WOOD = 23 PSF	40 PSF
K	TERRACE	30 PSF	40 PSF
L	ROOF	17 PSF	25 PSF
M	ROOF MECHANICAL	35 PSF	25 PSF
Q	STAIRS/ CORRIDOR	15 PSF (STAIRS)	100 PSF

LEVEL 1B LOADING PLAN

SCALE: 1" = 20'-0"

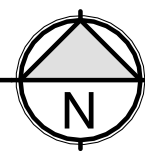

SUBMITTAL - REVISIONS		
NO.	DATE	DESCRIPTION
A1	11/29/2023	REVISION #1
B1	5/26/2024	REVISION #2
A2	5/26/2024	REVISION #3
A3	5/26/2024	REVISION #4
A4	5/26/2024	REVISION #5
A99	5/26/2024	REVISION #100

PROJECT
KINECT @ GRESHAM
1010 NW 12TH ST
GRESHAM, OR 97030

DRAWN BY
MH

CHECKED BY
EP

DRAWING SET DATE
APRIL 10, 2026

DRAWING SET TITLE
BID ADDENDUM #4

CITY OF GRESHAM PROJECT # 077031
SOUTHEAST CORNER OF SECTION 4,
TOWNSHIP 1 SOUTH, RANGE 3

TITLE
STRUCTURAL LOADING
PLANS

S0.21


ALL RIGHTS RESERVED. REPRODUCTION OR TRANSLATION OF ANY PART OF THIS WORK WITHOUT WRITTEN PERMISSION OF AMERICAN CAPITAL GROUP IS UNLAWFUL AND SUBJECT TO CRIMINAL PROSECUTION.



01601 LOAD MAP LEGEND			
DESIGN LOAD LEGEND			
MARK / PATTERN	AREA	ADDED DEAD LOAD	LIVE LOAD
A	PARKING	5 PSF	40 PSF
B	MECHANICAL	40 PSF	40 PSF
C	STORAGE	10 PSF	125 PSF
D	TRASH ROOM	10 PSF	100 PSF
E	GENERATOR/ TRANSFORMER	150 PSF	20 PSF
F	RETAIL/ FITNESS/LOBBY	15 PSF	100 PSF
G	LEVEL 3 AND 4 LANDSCAPE	150 PSF	100 PSF
H	DETENTION VAULT	250 PSF	40 PSF
J	RESIDENTIAL	CONC = 10 PSF WOOD = 23 PSF	40 PSF
K	TERRACE	30 PSF	40 PSF
L	ROOF	17 PSF	25 PSF
M	ROOF MECHANICAL	35 PSF	25 PSF
Q	STAIRS/ CORRIDOR	15 PSF (STAIRS)	100 PSF

LEVEL 2 LOADING PLAN

SCALE: 1" = 20'-0"

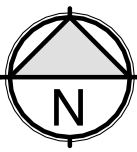

SUBMITTAL - REVISIONS		
NO.	DATE	DESCRIPTION
A1	11/29/2023	REVISION #1
B1	5/26/2024	REVISION #2
A2	5/26/2024	REVISION #3
A3	5/26/2024	REVISION #4
A4	5/26/2024	REVISION #5
A99	5/26/2024	REVISION #100

PROJECT
KINECT @ GRESHAM
1010 NW 12TH ST
GRESHAM, OR 97030

DRAWN BY: MH
CHECKED BY: EP
DRAWING SET DATE: APRIL 10, 2026
DRAWING SET TITLE: BID ADDENDUM #4
CITY OF GRESHAM PROJECT # 077031
SOUTHEAST CORNER OF SECTION 4, TOWNSHIP 1 SOUTH, RANGE 3

TITLE
STRUCTURAL LOADING PLANS
S0.22

FOR PERMIT
The Contractor shall not use these drawings for construction until Contractor receives written approval for use in construction by the authority having jurisdiction and EDCI Engineers.

NO.	DATE	DESCRIPTION
A1	7/18/2025	ADDENDUM #1
B1	9/28/2025	RDC COMMENTS

DRAWING SET DATE
APRIL 10, 2026

BID ADDENDUM #4

TY OF GRESHAM PROJECT # 077531

SOUTHEAST CORNER OF SECTION 4,
TOWNSHIP 1 SOUTH, RANGE 3

S P I

50.23



01601	LOAD MAP LEGEND
-------	------------------------


SCALE: 1" = 20'-0"



KINECT @ GRESHAM


1010 NW 12TH ST
GRESHAM, OR 97030

STRUCTURAL LOADING PLANS

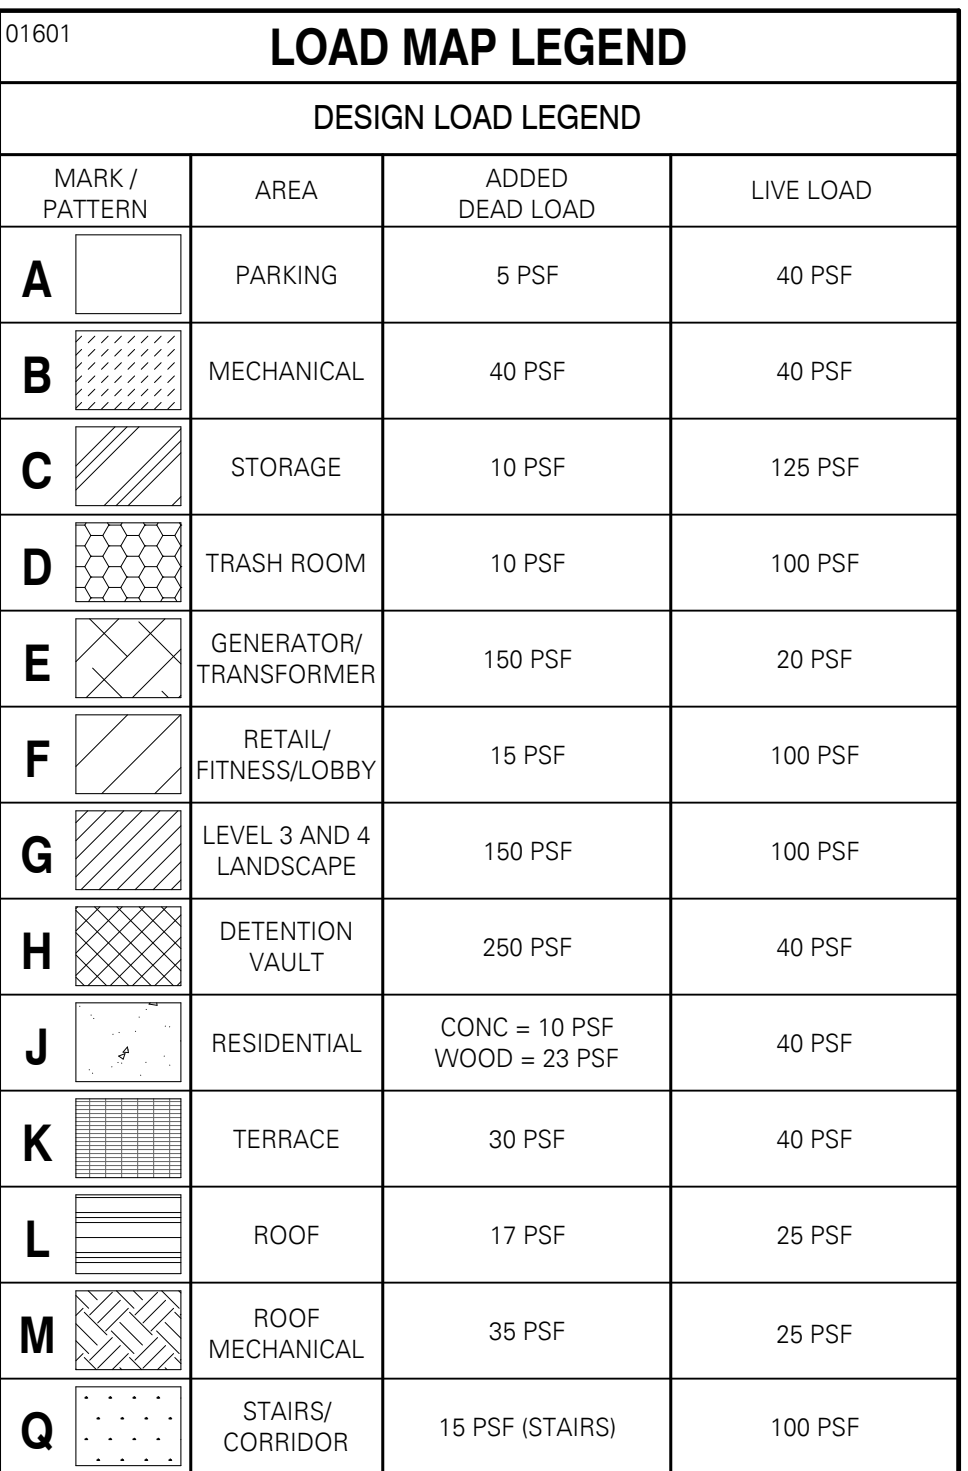


LEVEL 4 LOADING PLAN
SCALE: 1" = 20'-0"




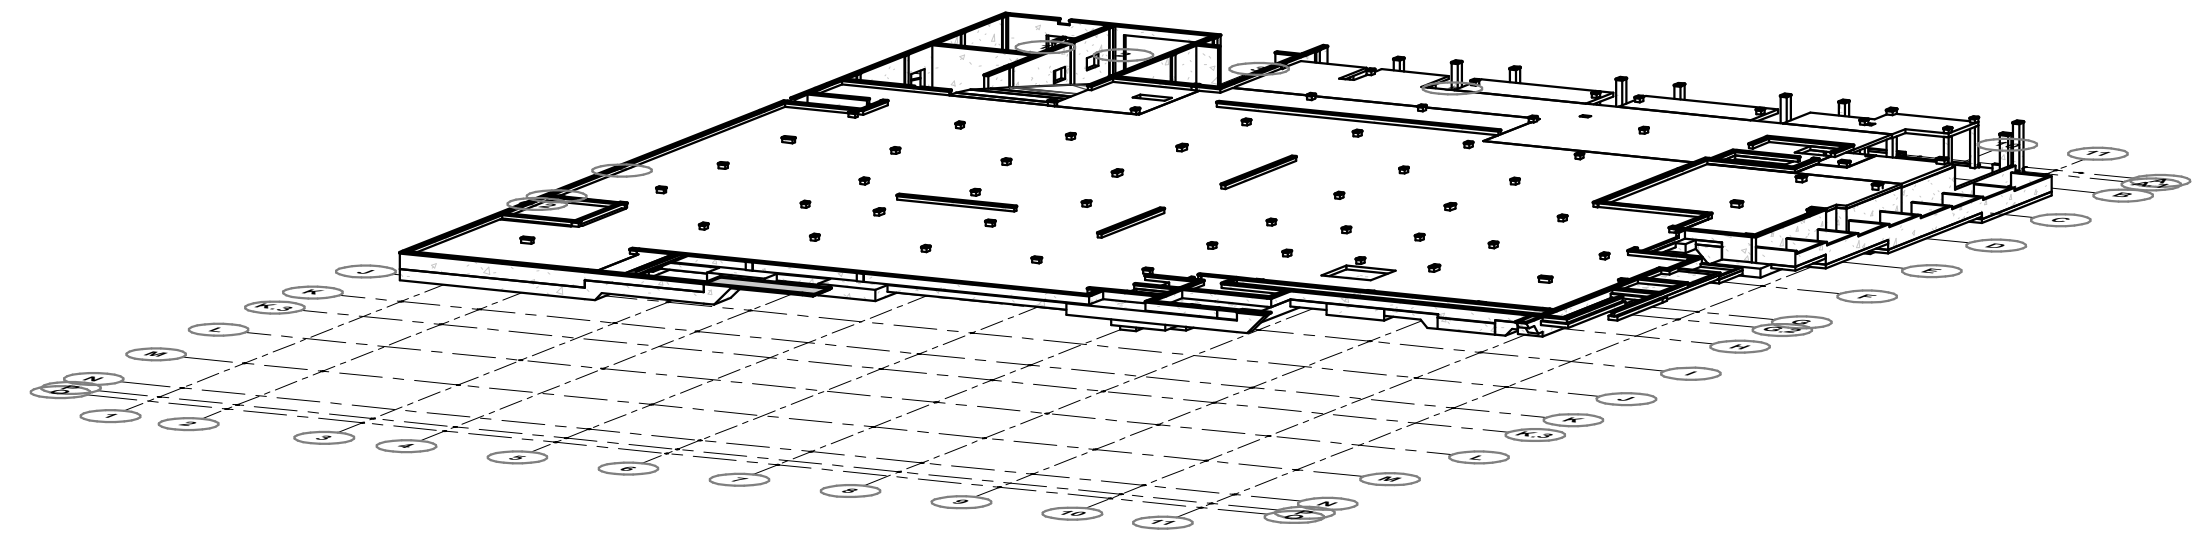


3D VIEW-LEVEL-1B

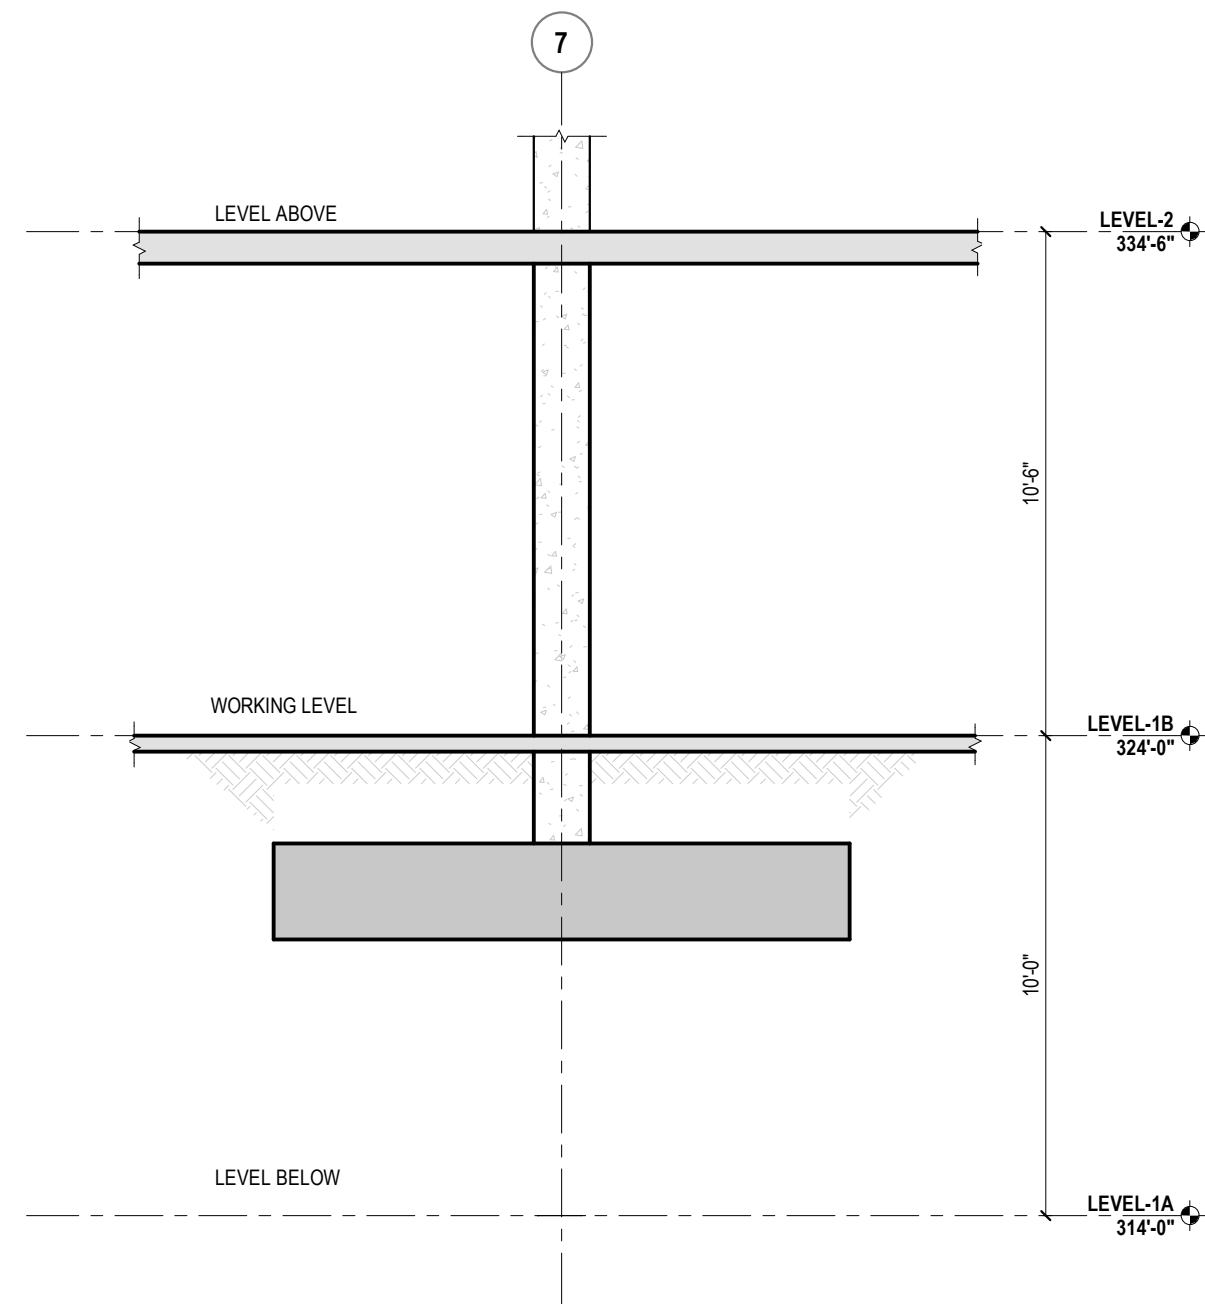

2 BUILDING SECTION LEVEL-1B

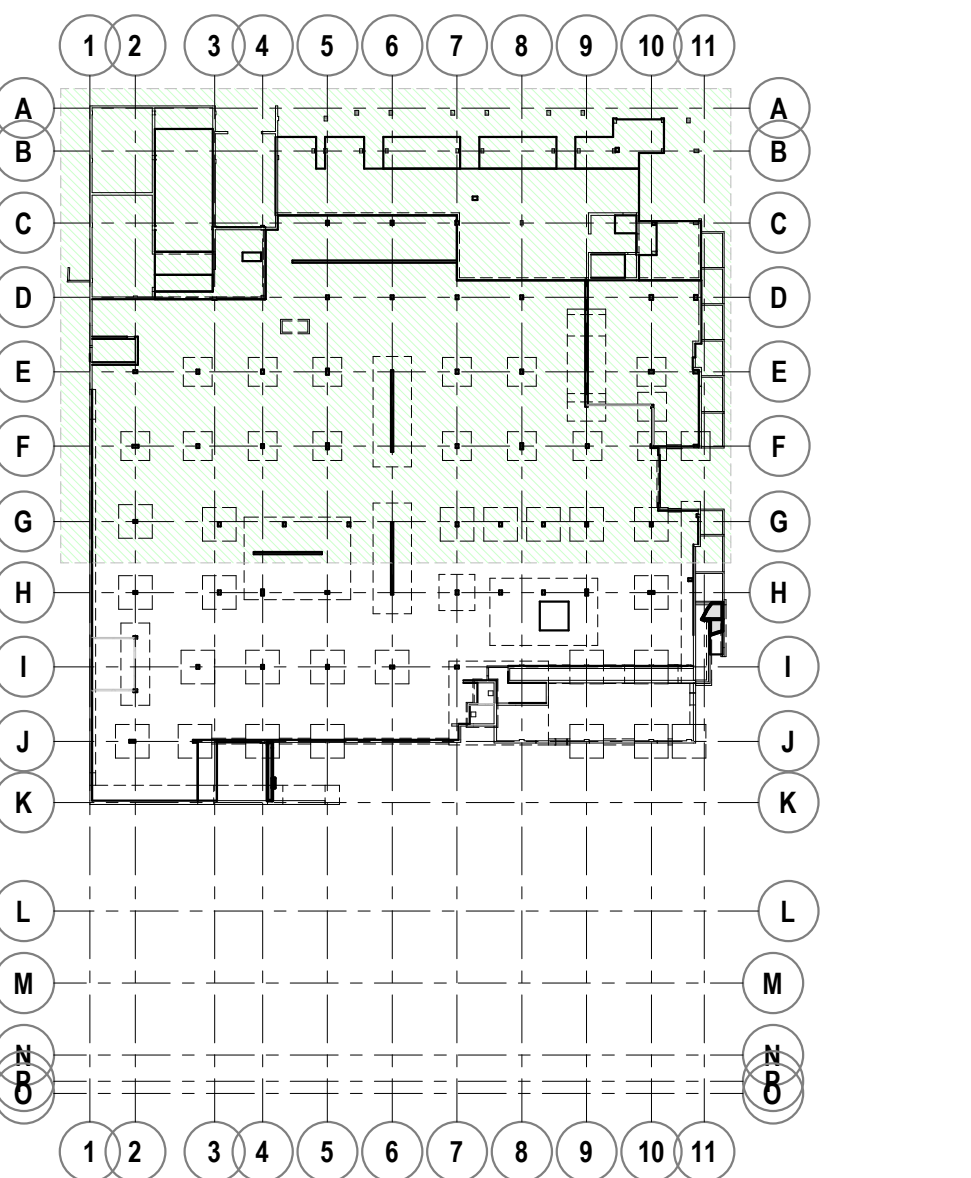

LEVEL-1B KEYPLAN NORTH

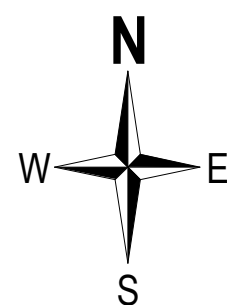


NOTES:


1. 3/4" CHAMFER ON ALL EXPOSED CONCRETE CORNERS TYP.
2. ALL COLUMNS ARE CENTERED ON GRID LINES U.N.O.
3. ALL BEAMS ARE CENTERED ON GRID LINES U.N.O.
4. SLAB ON GRADE THICKNESS IS 4" TYP. U.N.O.
5. LEVEL 1B ELEVATION = 324'-0"

LEGEND


SHADE DESIGNATIONS

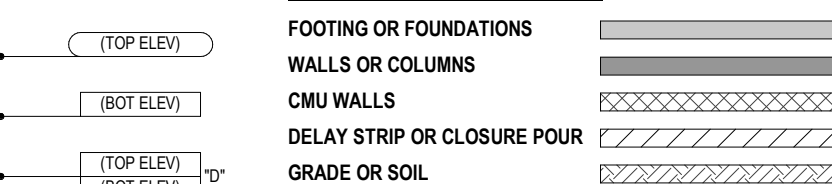


LINE DESIGNATIONS

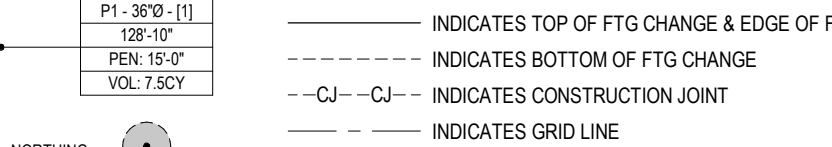


1-BOX (ROUND-
TOP OF CONCRETE

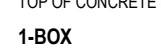


2-BOX (PLAN VI)

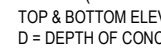


3-BOX (FLOOR & TOP & BOTTOM ELEVATIONS)

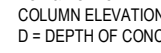

CAISSON TAG ()
CAISSON TYPE - DIA

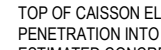

ESTIMATED CONCENTRATIONS OF SELECTED METALS IN THE HUMAN BODY (continued)

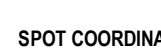

SHEET NUMBER —




SHEET NUMBER —




1 LEVEL-1B (FLOOR PLAN) - NORTH


****PLEASE PROVIDE / VERIFY THE INFORMATION IN RED****

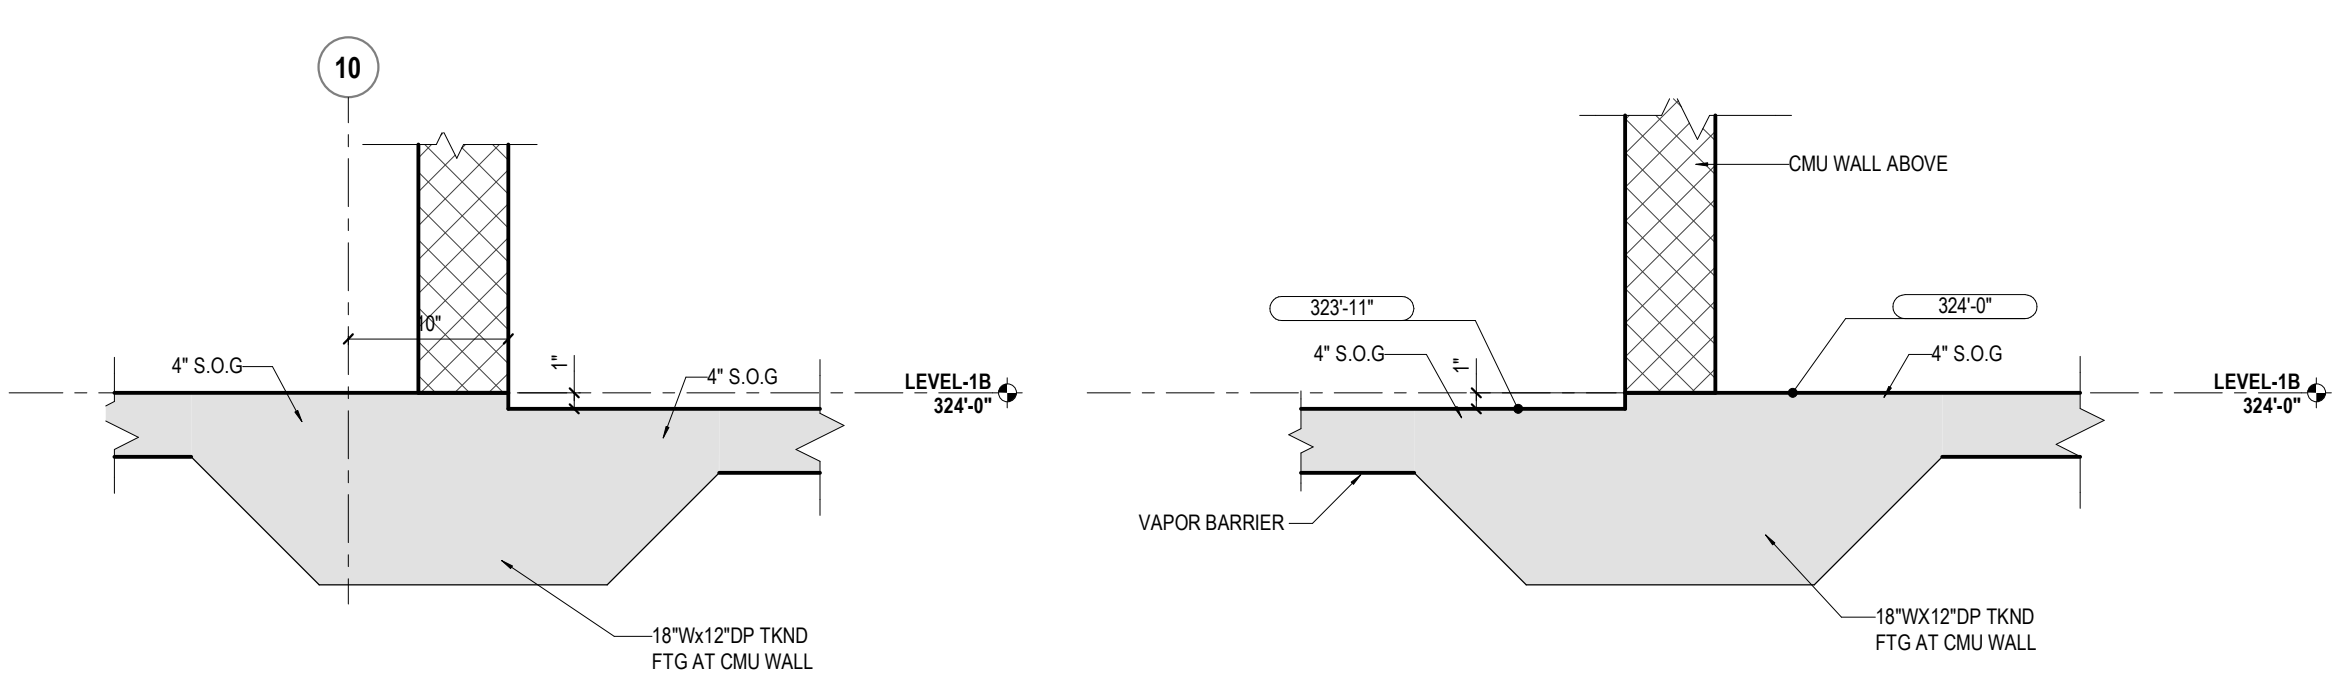

INTERIOR THICKENED SLAB @ CMU

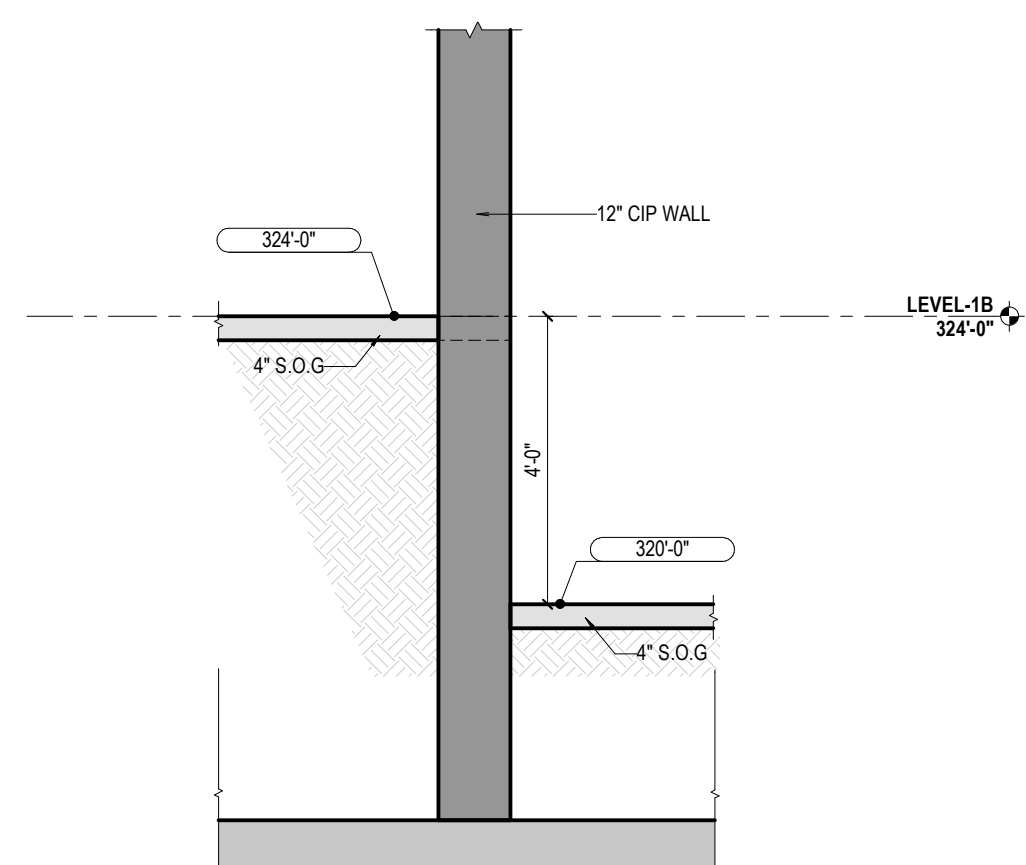

6 SLAB TRANSITION AT STAIR-2

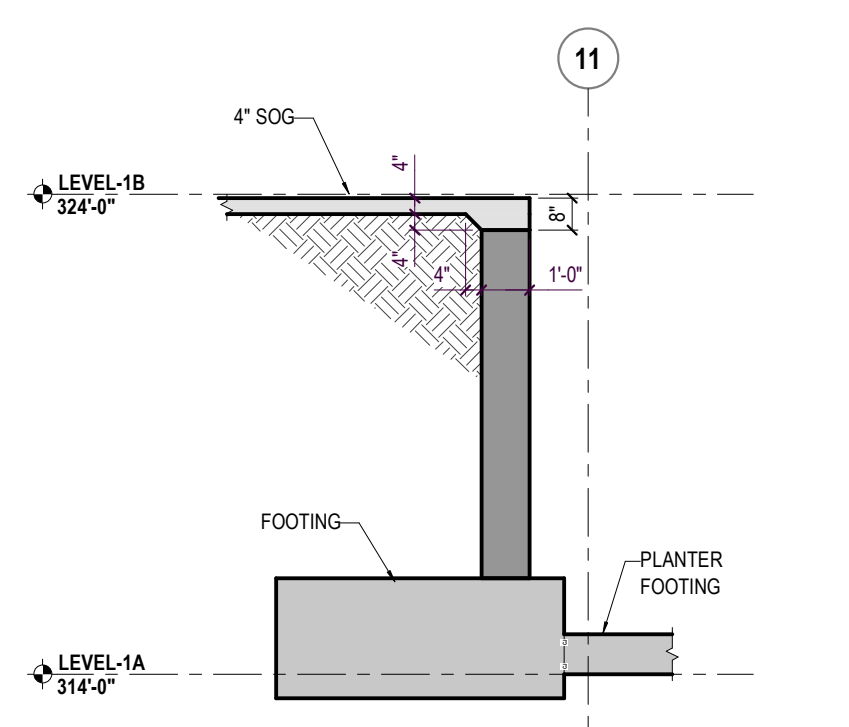

THICKEN SOG AT WALL

[illegible]

KINECT @ GRESHAM

1010 NW 12TH ST
GRESHAM, OR 97030

DRAWN BY
 MH

CHECKED BY
 EP


DRAWING SET DATE
APRIL 10, 2026

BID ADDENDUM #4

SOUTHEAST CORNER OF SECTION 4,
TOWNSHIP 1 SOUTH, RANGE 3

STRUCTURAL LOADING PLANS

\$0.20

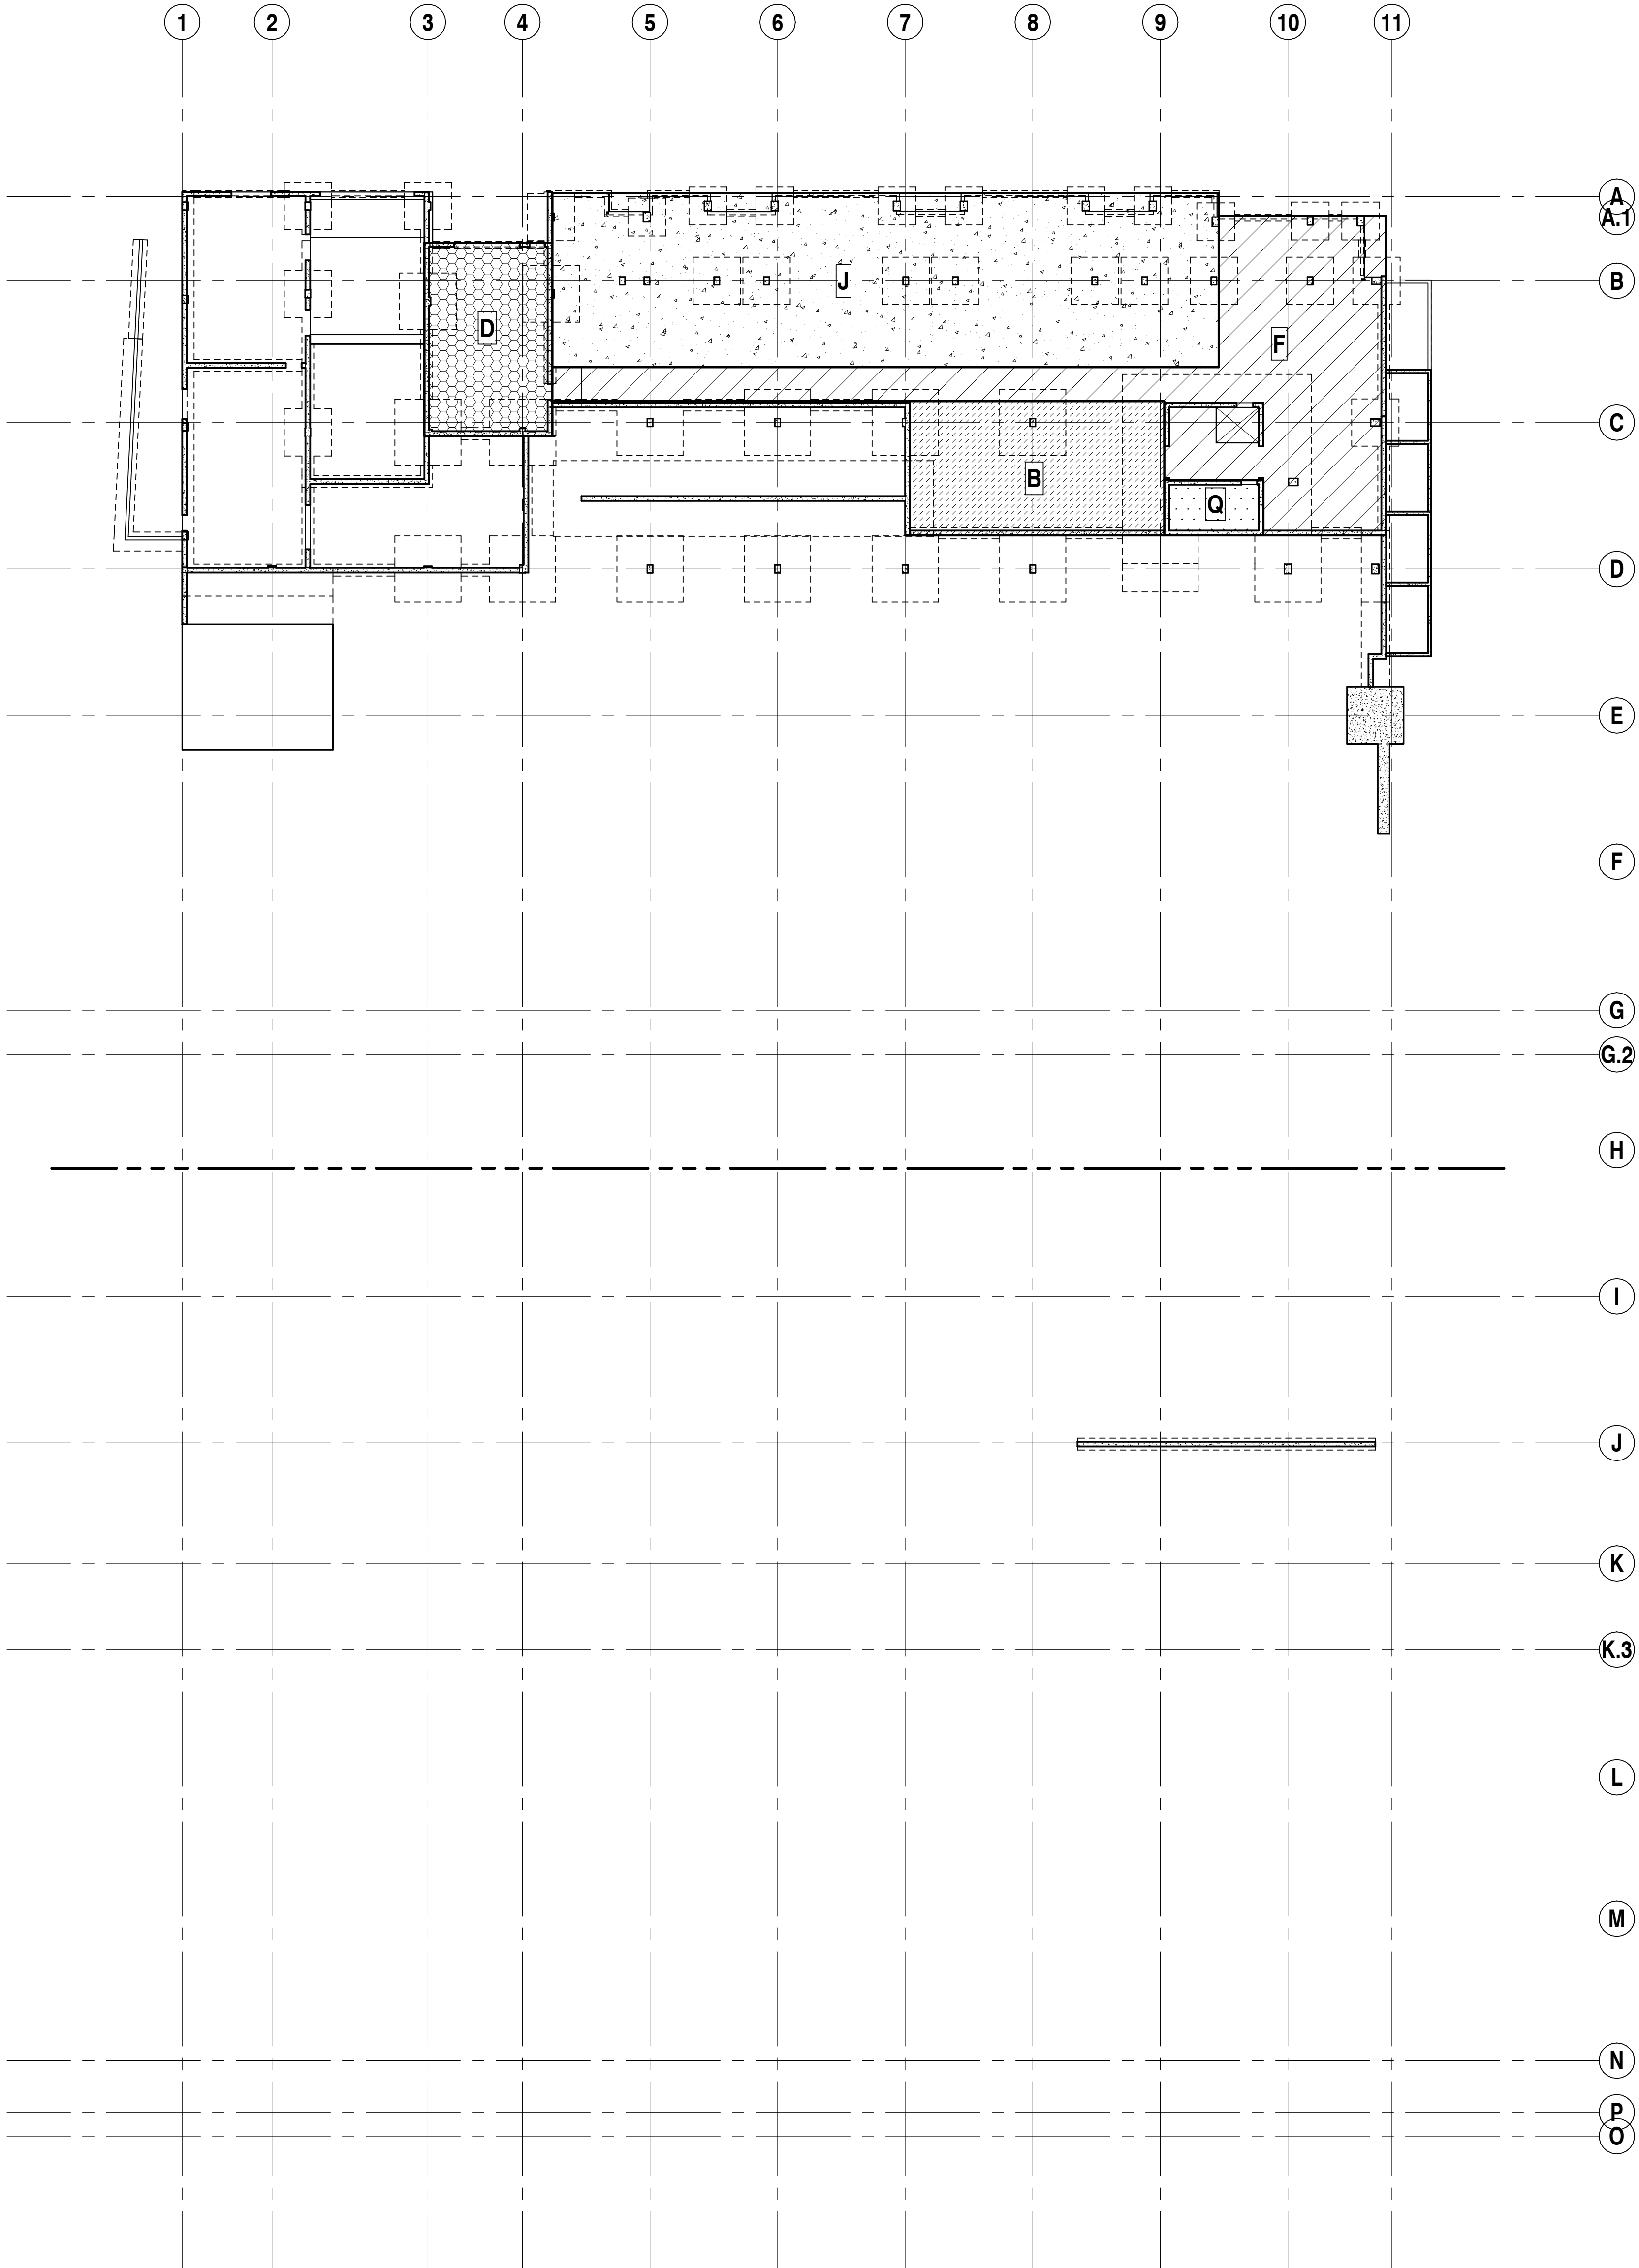


LOAD MAP LEGEND				
DESIGN LOAD LEGEND				
MARK / PATTERN	AREA	ADDED DEAD LOAD	LIVE LOAD	
A 	PARKING	5 PSF	40 PSF	
B 	MECHANICAL	40 PSF	40 PSF	
C 	STORAGE	10 PSF	125 PSF	
D 	TRASH ROOM	10 PSF	100 PSF	
E 	GENERATOR/ TRANSFORMER	150 PSF	20 PSF	
F 	RETAIL/ FITNESS/LOBBY	15 PSF	100 PSF	
G 	LEVEL 3 AND 4 LANDSCAPE	150 PSF	100 PSF	
H 	DETENTION VAULT	250 PSF	40 PSF	
J 	RESIDENTIAL	CONC = 10 PSF WOOD = 23 PSF	40 PSF	
K 	TERRACE	30 PSF	40 PSF	
L 	ROOF	17 PSF	25 PSF	
M 	MECHANICAL	35 PSF	25 PSF	
Q 	STAIRS/ CORRIDOR	15 PSF (STAIRS)	100 PSF	

LEVEL 1A LOADING PLAN
SCALE: 1" = 20'-0"




THIS DRAWING IS FOR THE EXCLUSIVE USE OF MCCLONE CONSTRUCTION COMPANY, ON THE PROJECT ONLY. UTILIZATION OF THIS DRAWING BY OTHER PARTIES WITHOUT THE EXPRESSED WRITTEN CONSENT OF MCCLONE CONSTRUCTION COMPANY IS STRICTLY PROHIBITED.

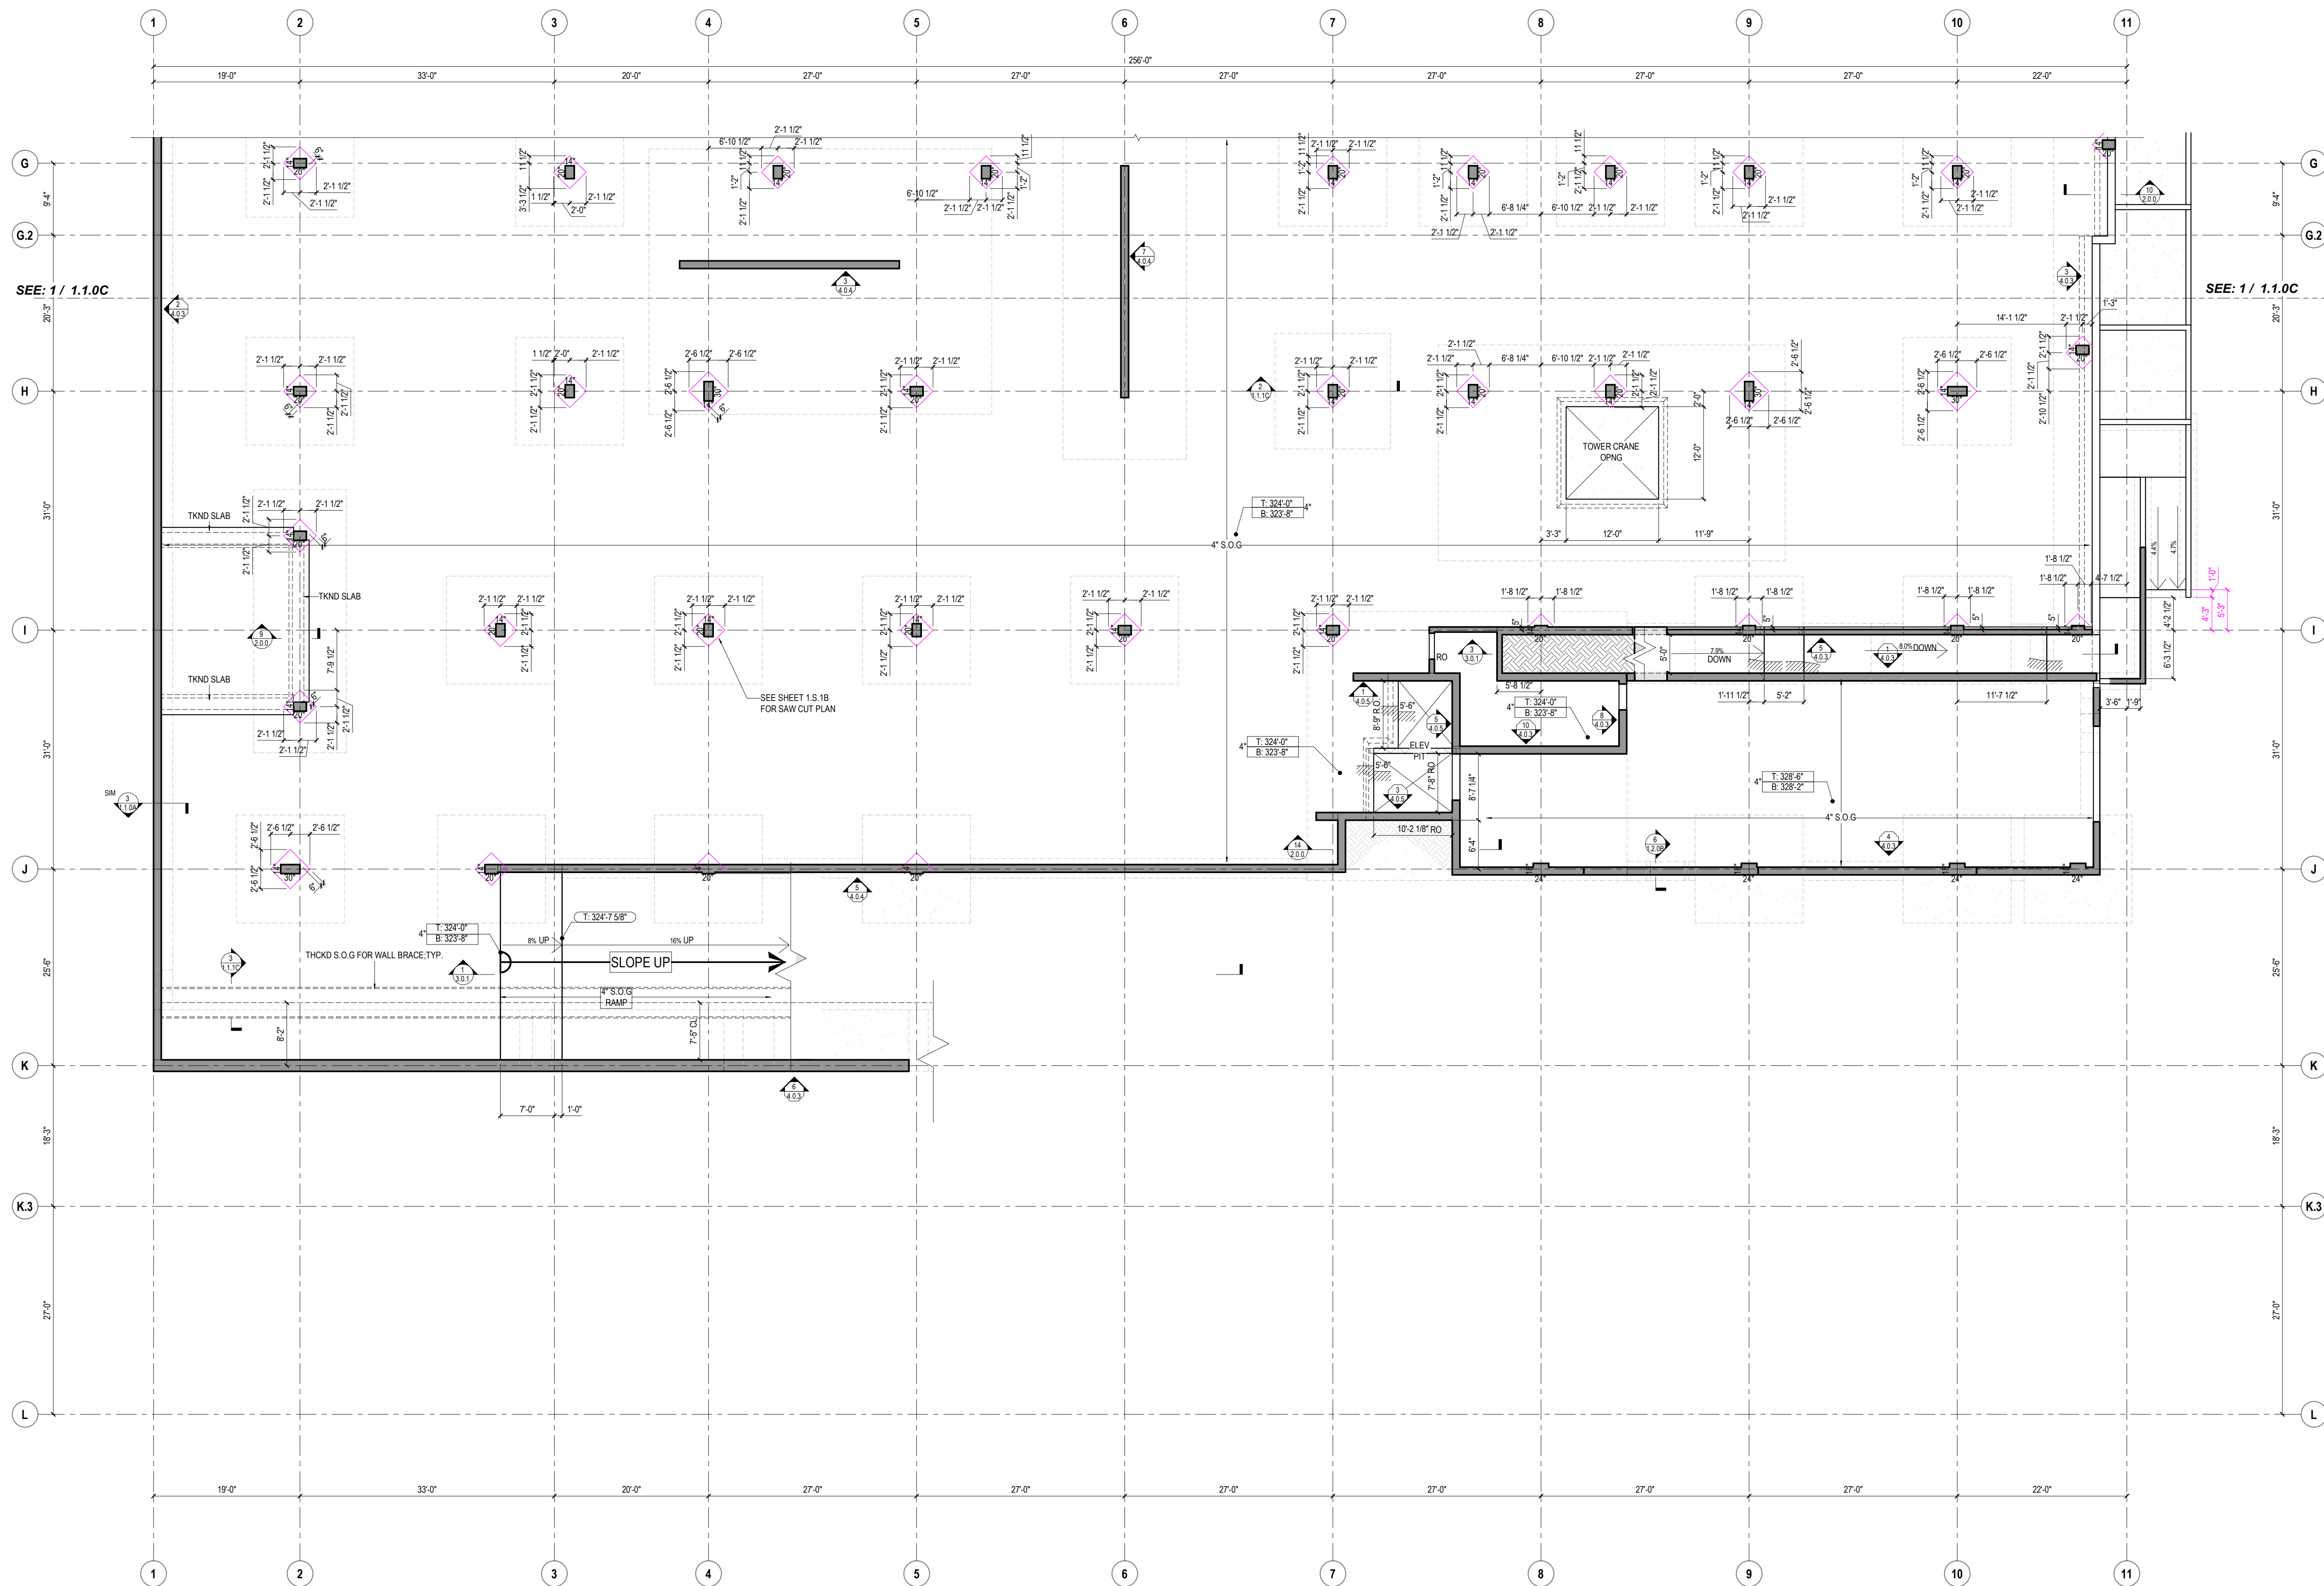


1 LEVEL-1B S.O.G FLOOR PLAN - SOUTH


PLEASE PROVIDE / VERIFY THE INFORMATION IN MAGENTA

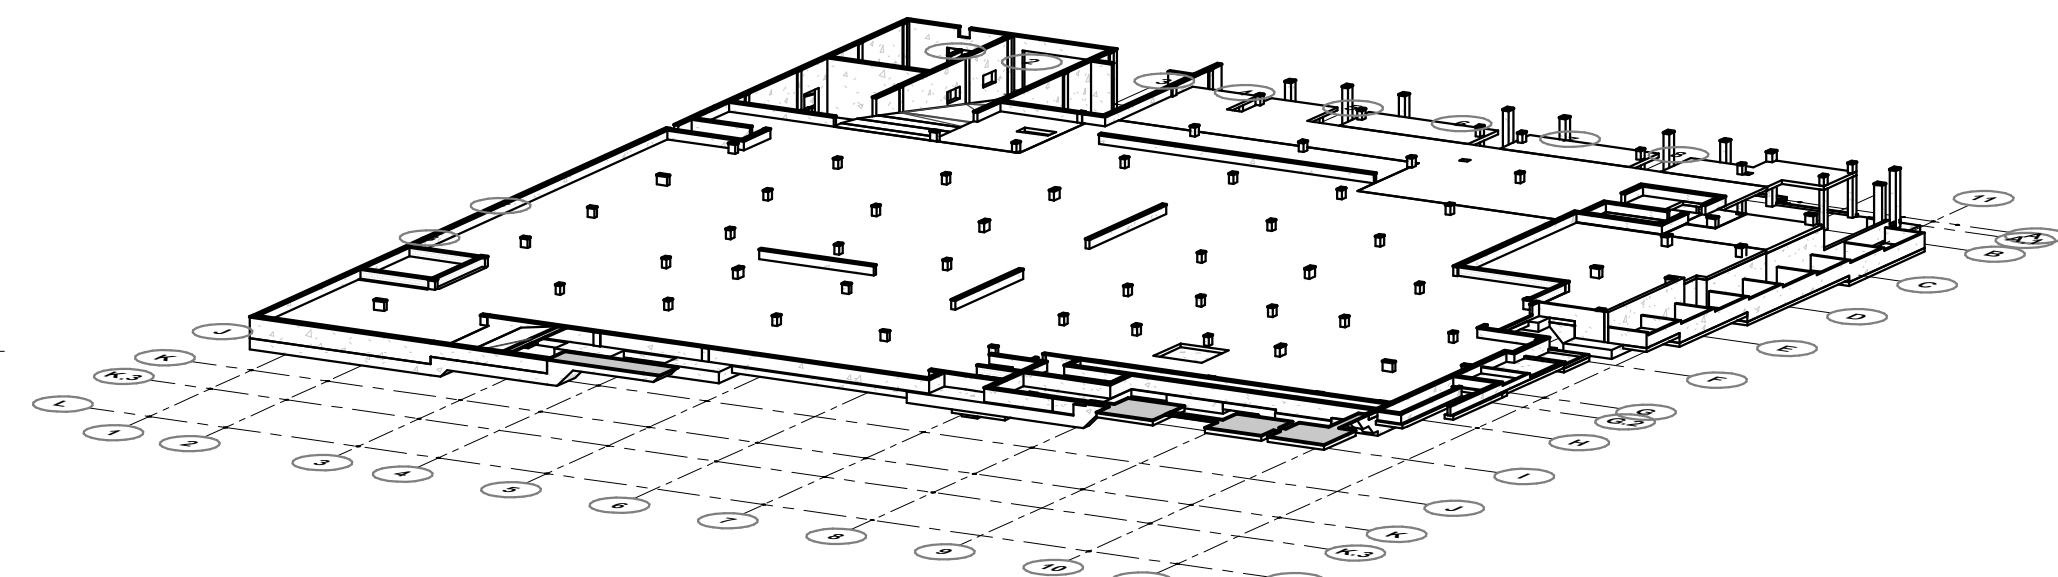


3D VIEW - LEVEL 1B SOUTH

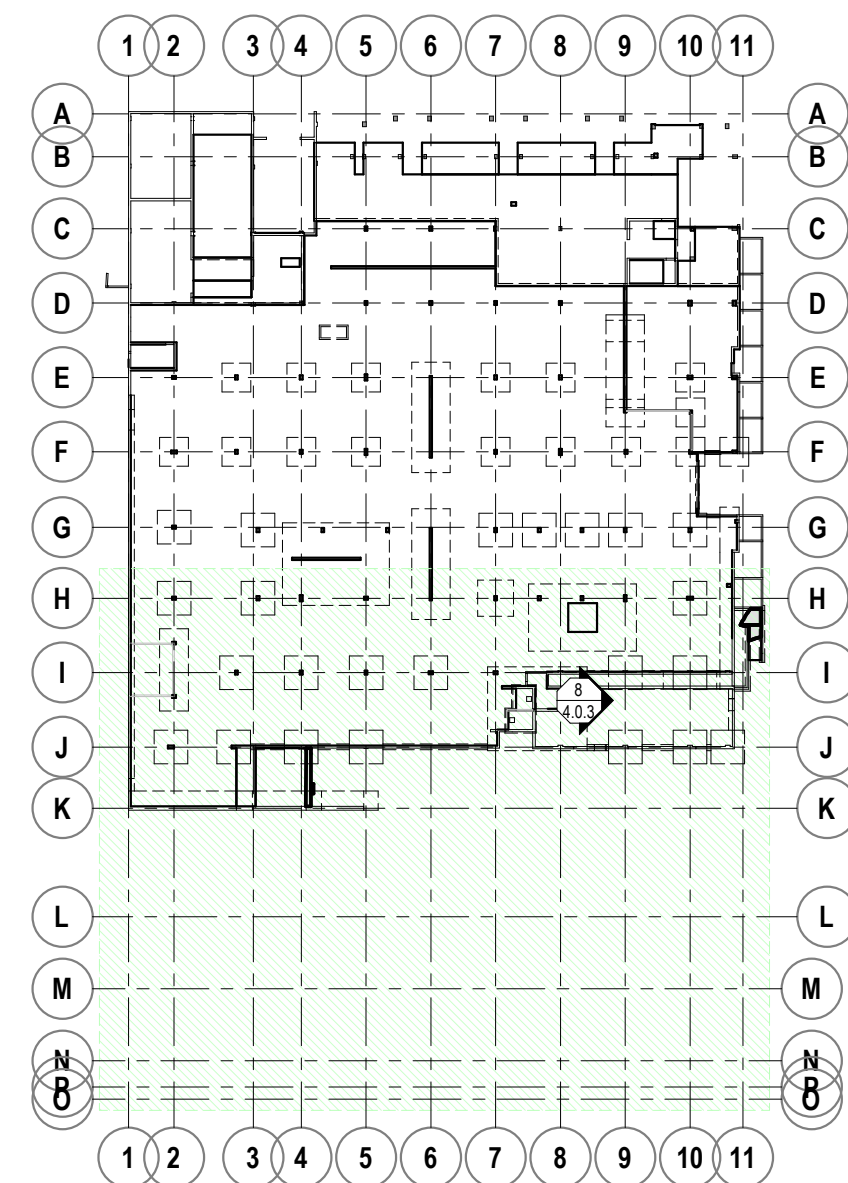

LEVEL-1B KEY PLAN SOUTH

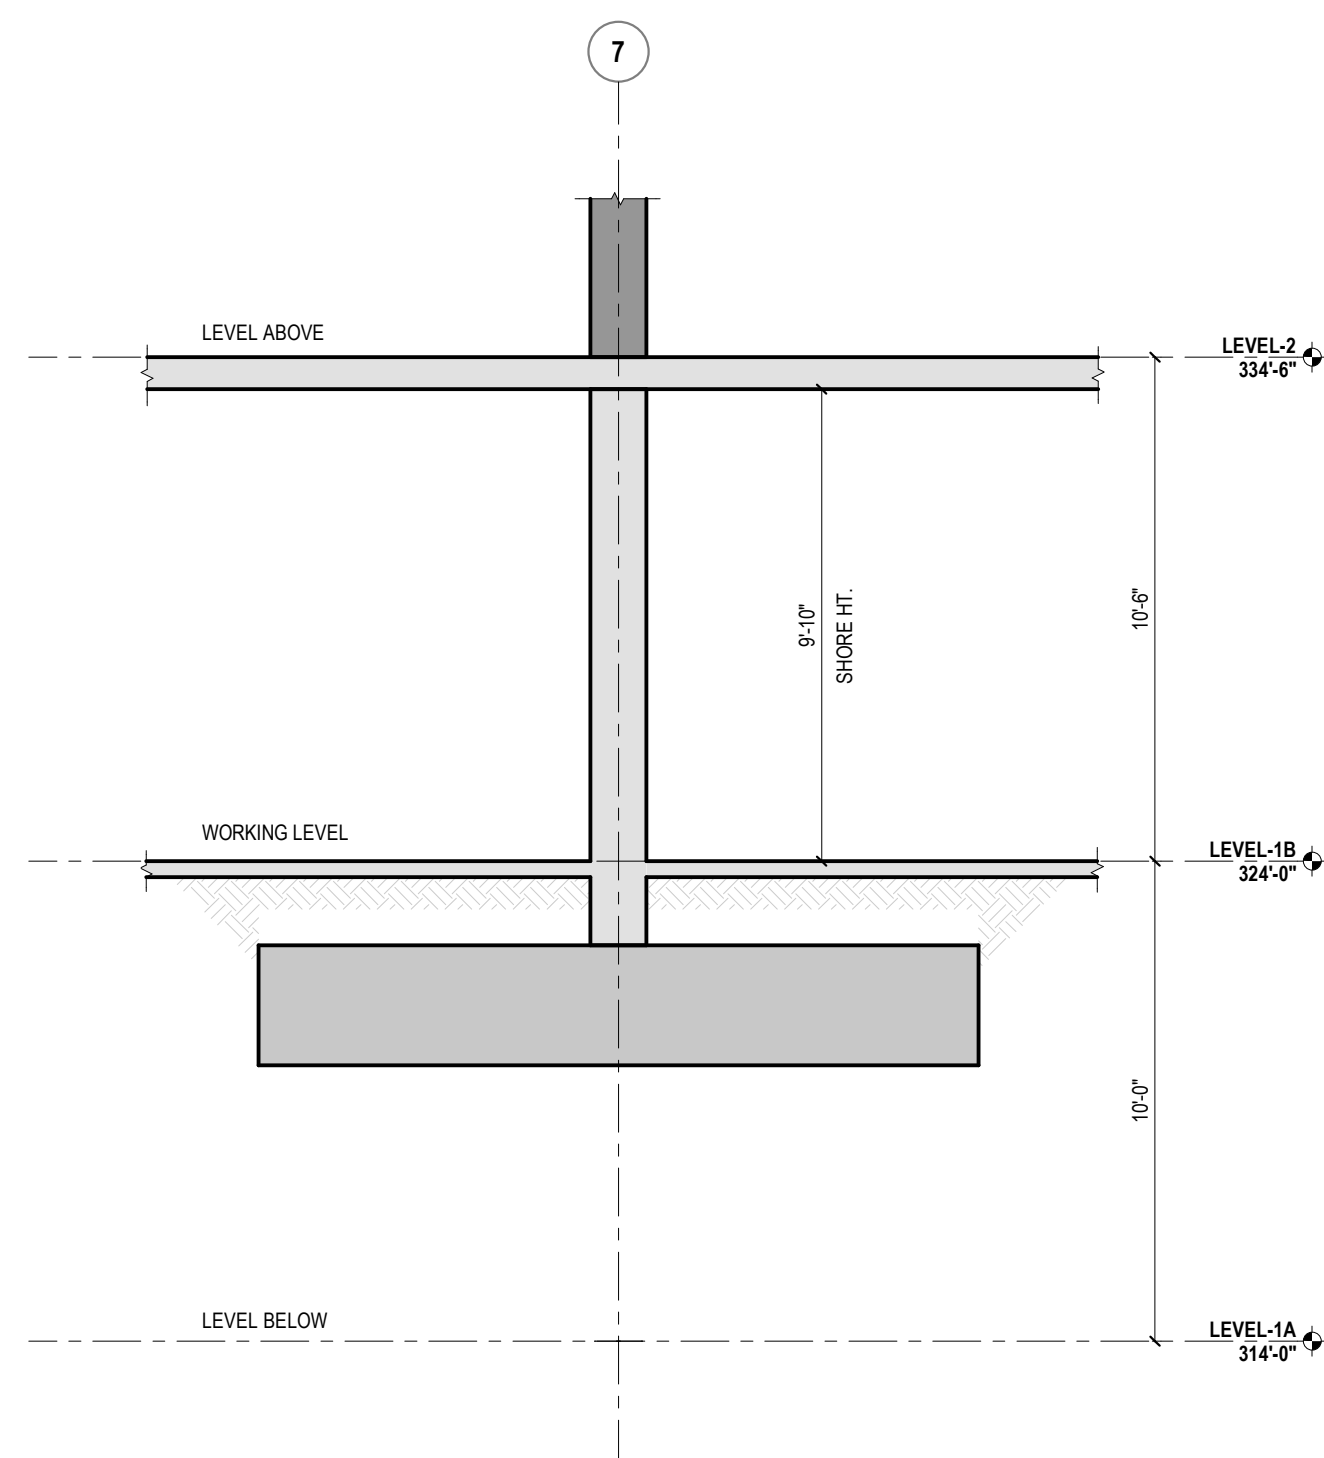

2 BUILDING SECTION LEVEL-1B

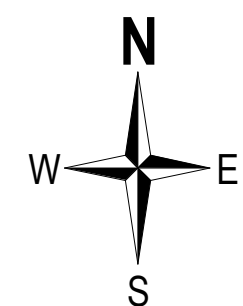


NOTES:


- 3/4" CHAMFER ON ALL EXPOSED CONCRETE CORNERS TYP.
- ALL COLUMNS ARE CENTERED ON GRID LINES U.N.O.
- ALL BEAMS ARE CENTERED ON GRID LINES U.N.O.
- SLAB ON GRADE THICKNESS IS 4" TYP. U.N.O.
- LEVEL 1B ELEVATION = 324'-0"

LEGEND

SYMBOLS		SHADE DESIGNATIONS	
1-BOX (ROUND-ENDS)	TOP OF CONCRETE ELEVATIONS	BEAM OR DROP CAP	
1-BOX	BOTTOM OF CONCRETE ELEVATIONS	WALLS OR COLUMNS	
2-BOX (PLAN VIEWS)	TOP & BOTTOM ELEVATIONS	CMU WALLS	
3-BOX (FLOOR PLANS)	TOP & BOTTOM ELEVATIONS	DELAY STRIP OR CLOSURE POUR	
4-BOX (FLOOR PLANS)	TOP & BOTTOM ELEVATIONS	GRADE OR SOIL	
5-BOX (FLOOR PLANS)	TOP & BOTTOM ELEVATIONS	Y' PYLON-SLAB	
6-BOX (FLOOR PLANS)	TOP & BOTTOM ELEVATIONS	Z' PYLON-SLAB	
7-BOX (FLOOR PLANS)	TOP & BOTTOM ELEVATIONS		
8-BOX (FLOOR PLANS)	TOP & BOTTOM ELEVATIONS		
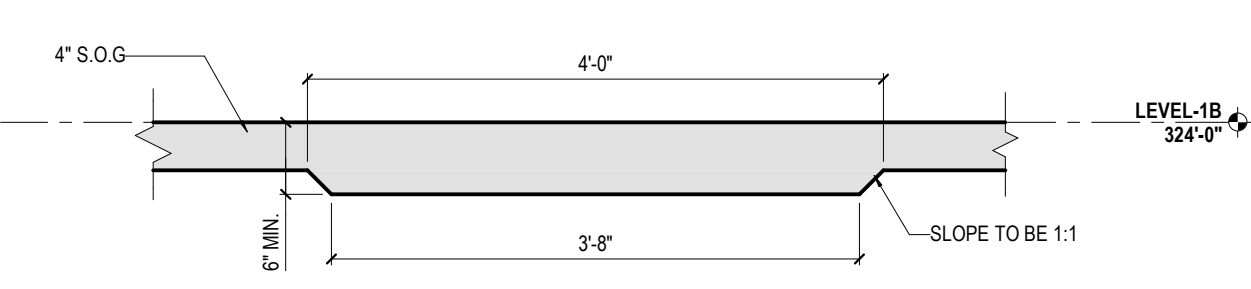


3 THICKENED S.O.G FOR WALL BRACE

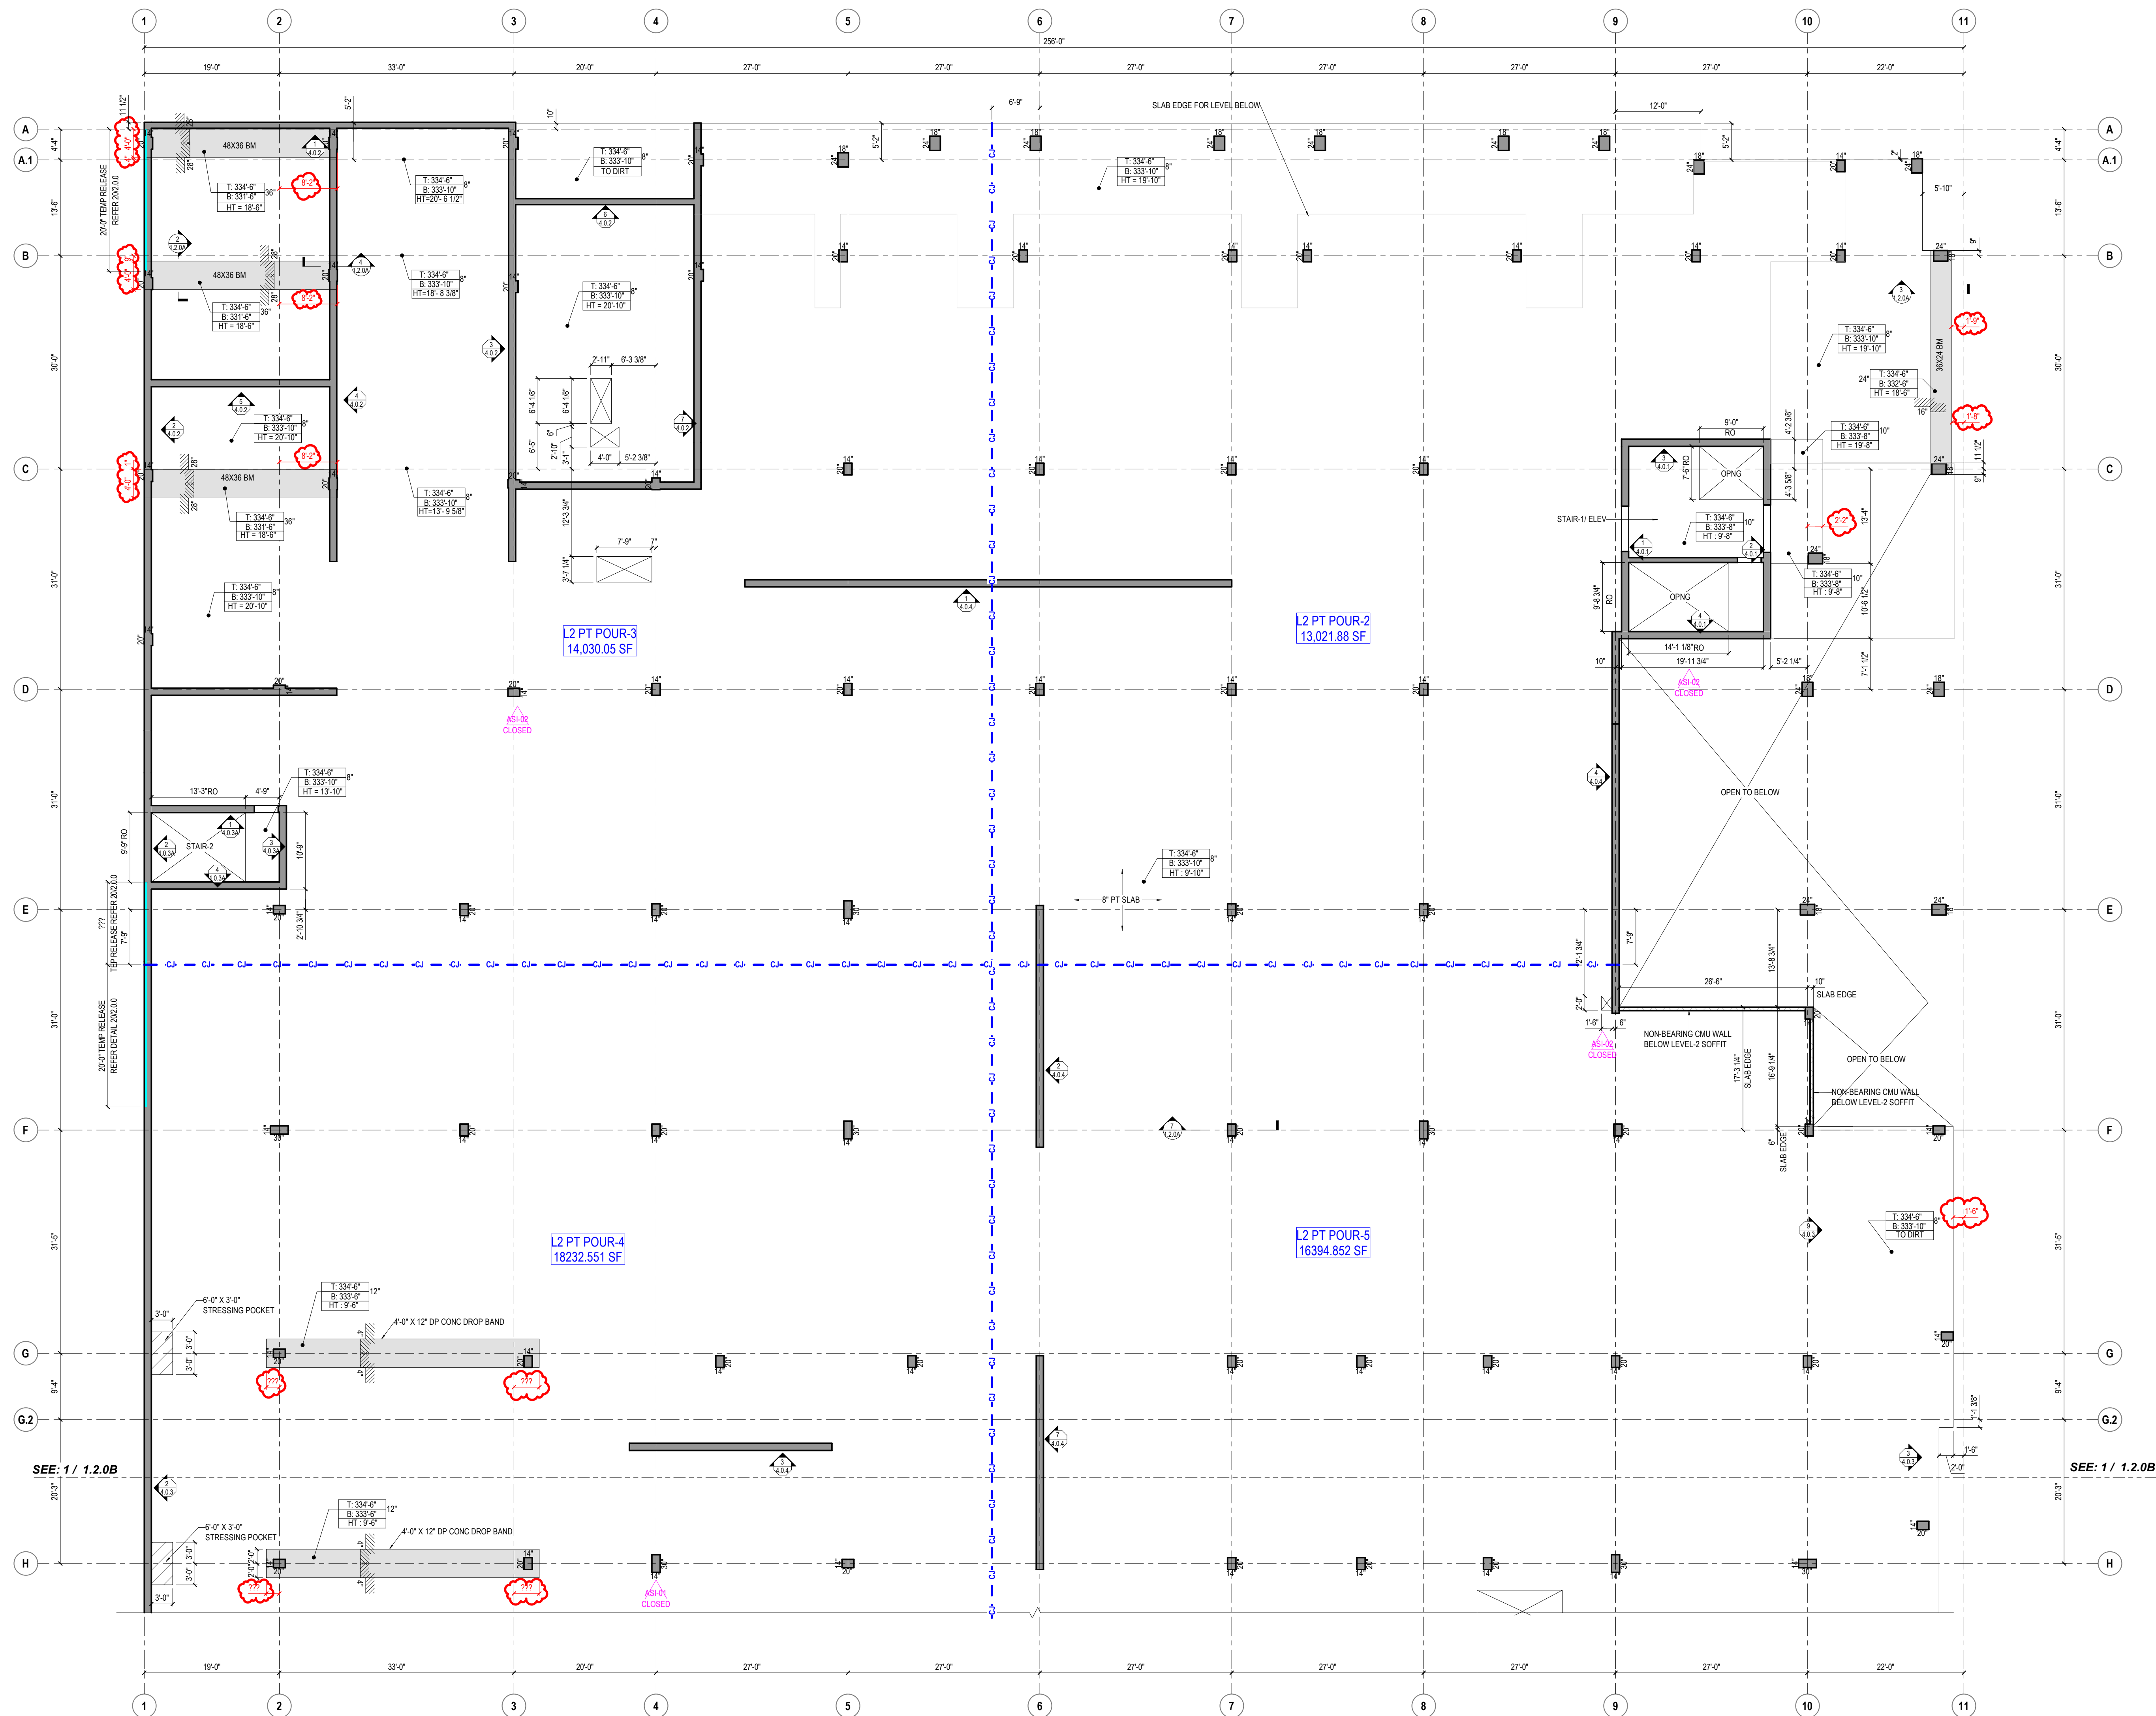


1 LEVEL-2 (SOFFIT PLAN) - NORTH


****PLEASE PROVIDE / VERIFY THE INFORMATION IN RED****

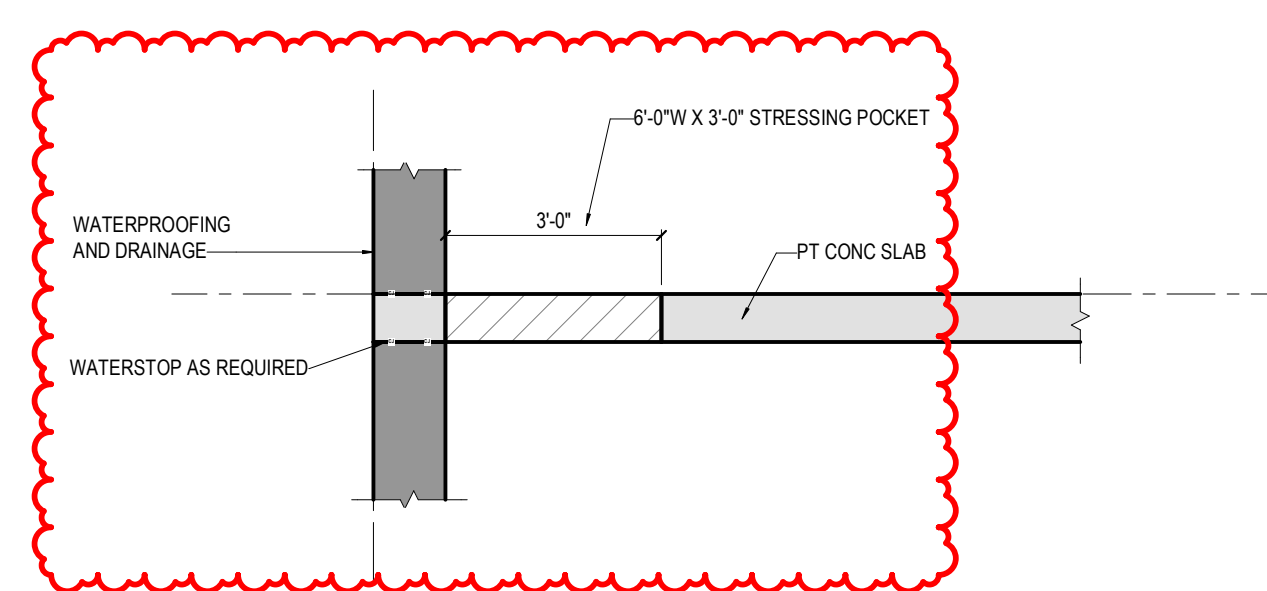


5 TYPICAL STRSSING POCKET

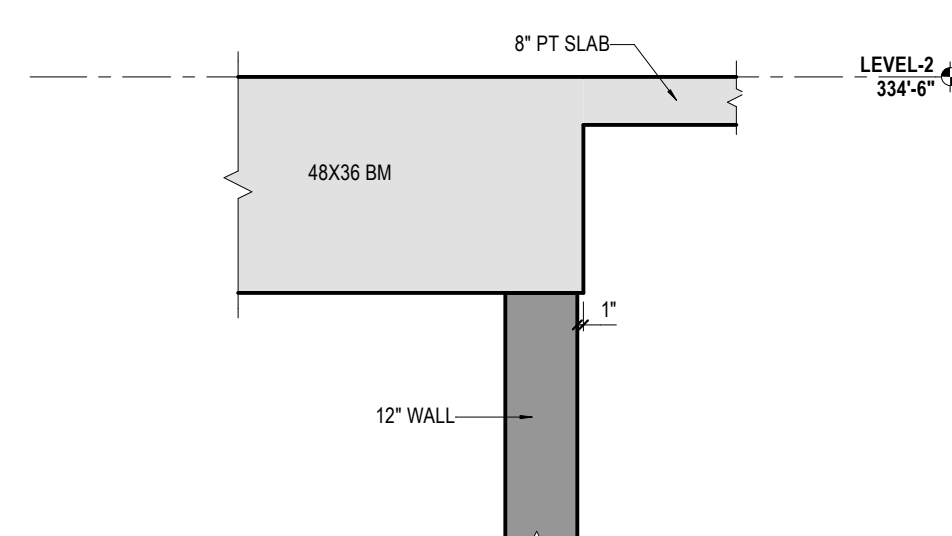


4 BEAM AT THE WALL LOCATION

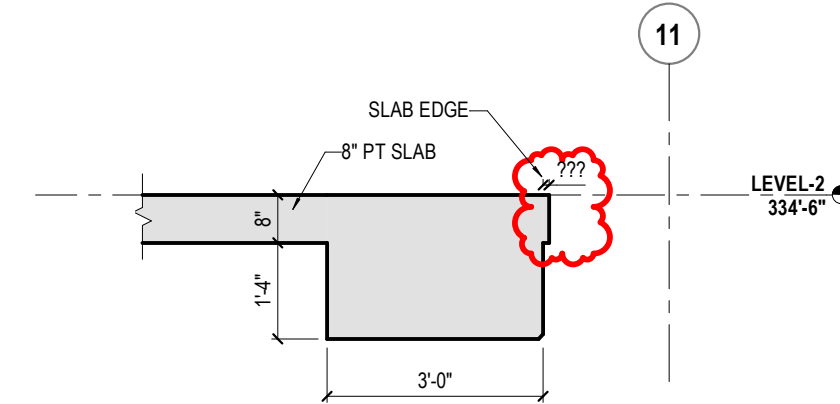


3 TYP EXTERIOR BEAM

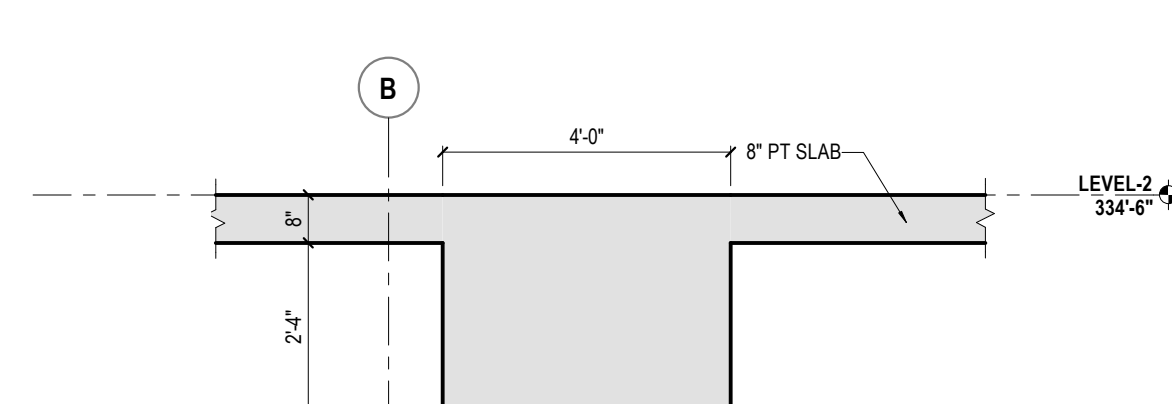


2 TYP INTERIOR BEAM

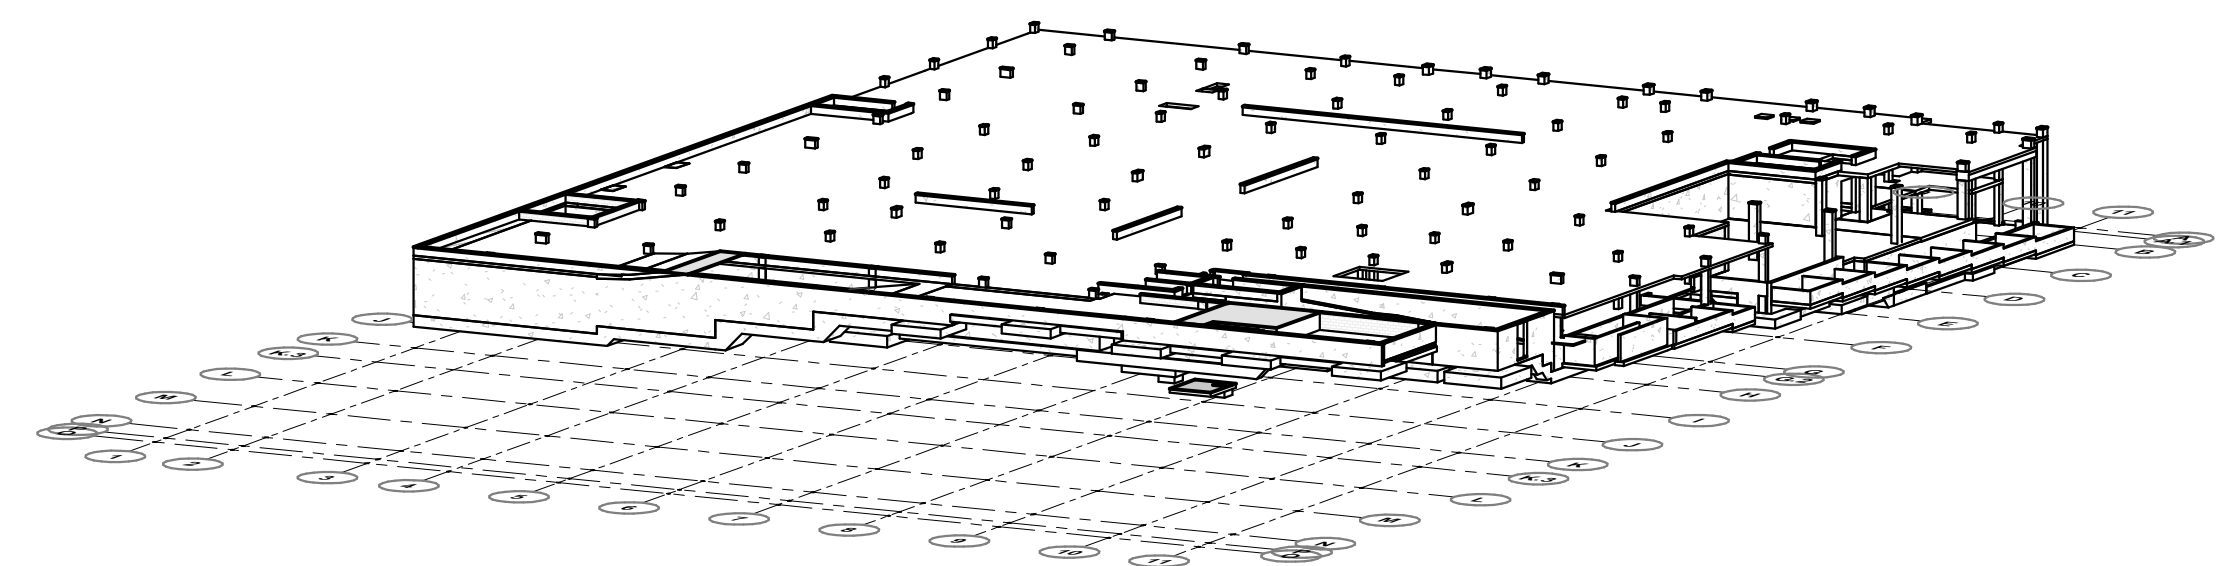


3D VIEW LEVEL-2

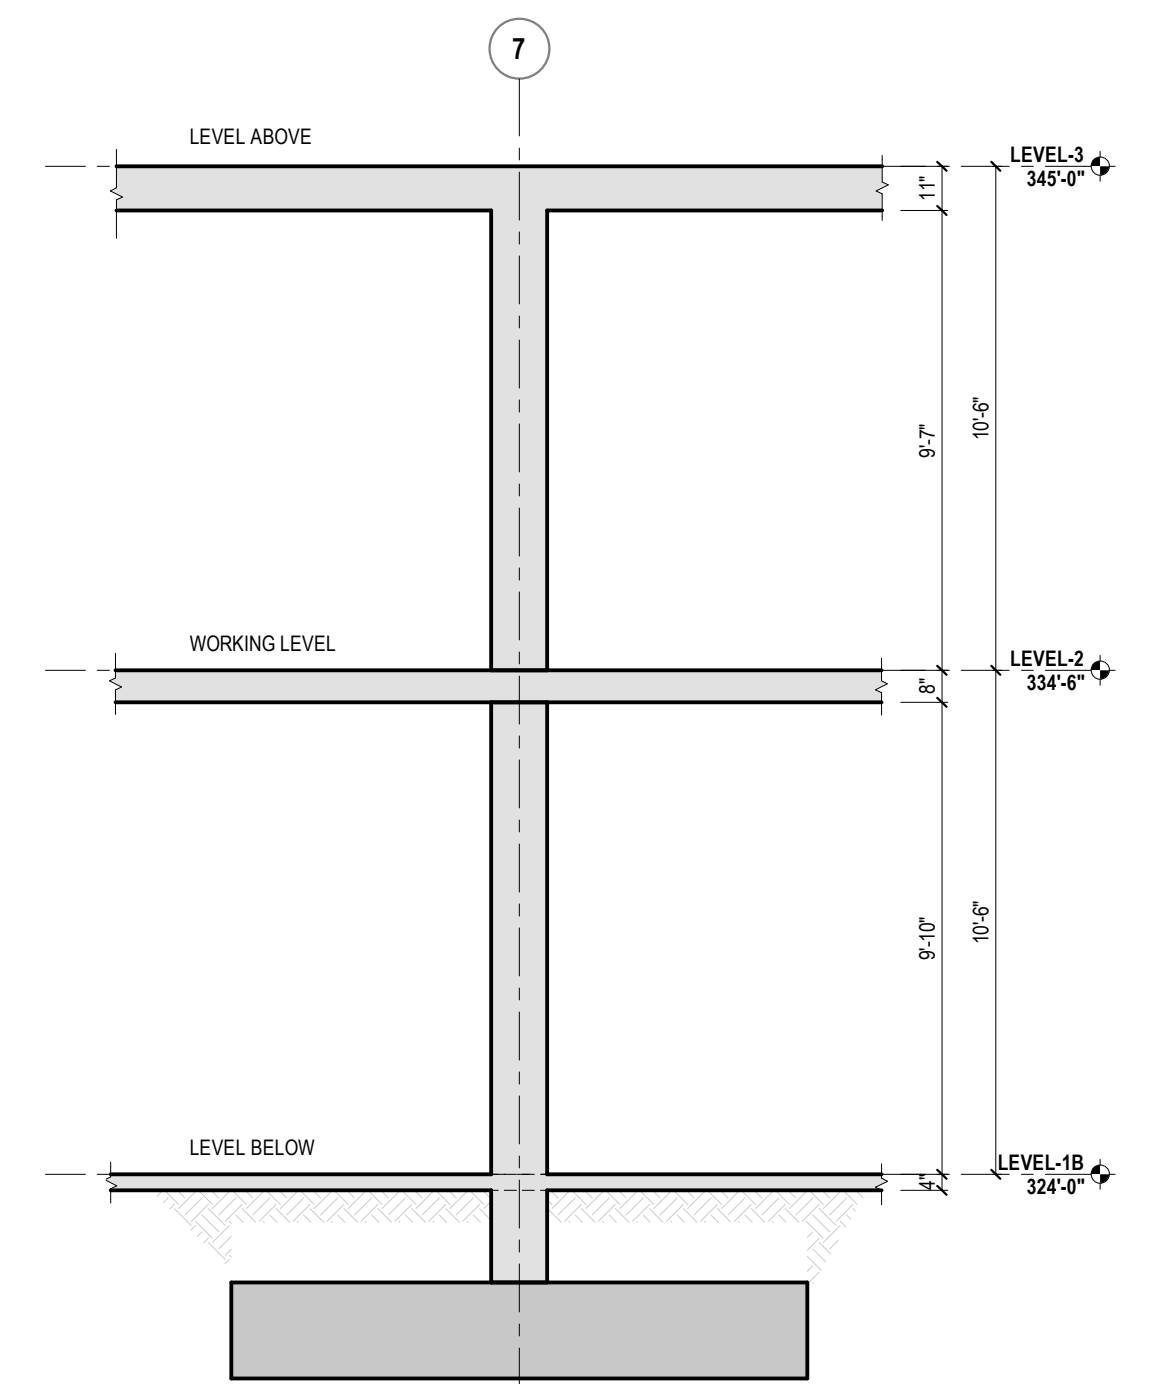

7 BUILDING SECTION LEVEL-2 NORTH

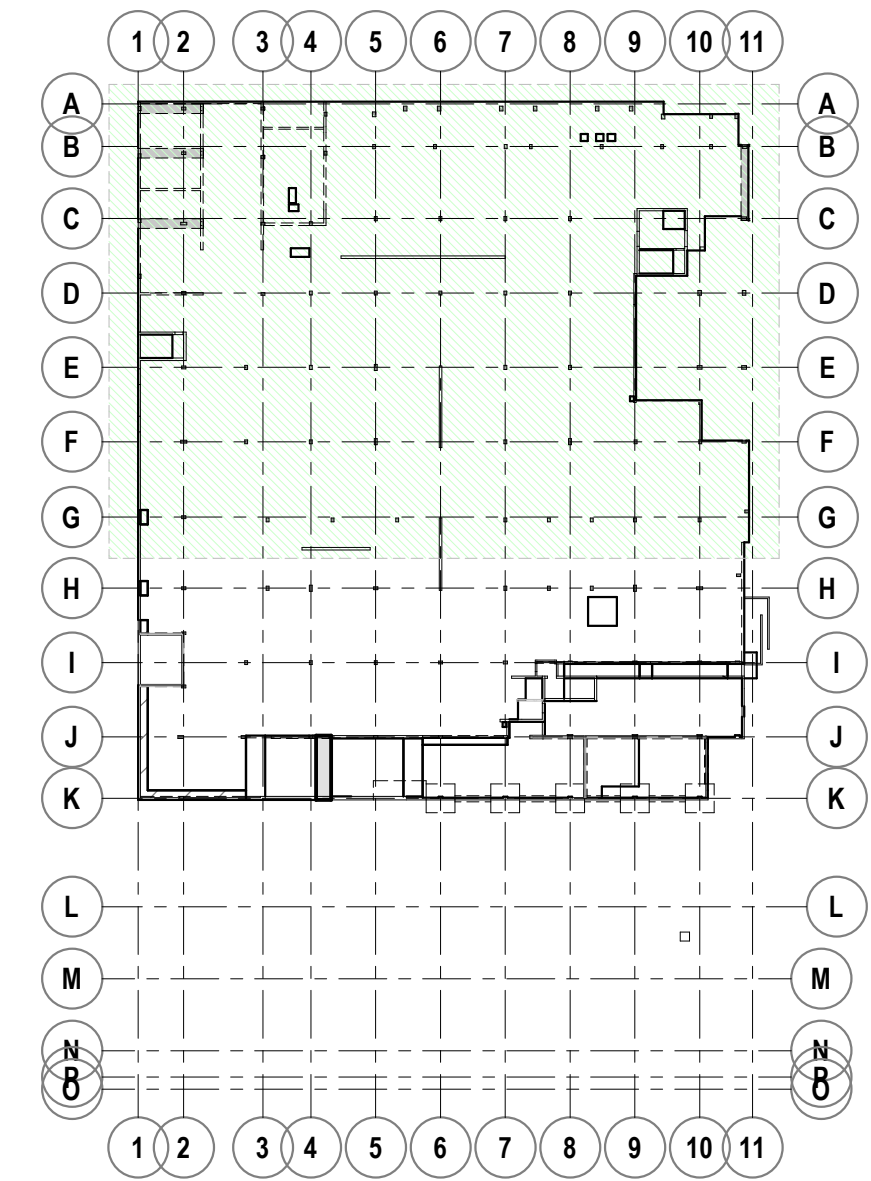

LEVEL-2 KEY PLAN NORTH

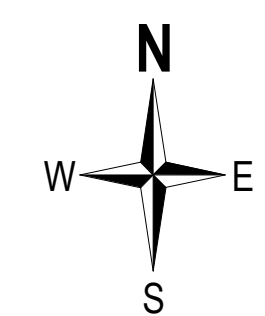

NOTES:

1. 3/4" CHAMFER ON ALL EXPOSED CONCRETE CORNERS TYP.
2. ALL COLUMNS ARE CENTERED ON GRID LINES U.N.O.
3. ALL BEAMS ARE CENTERED ON GRID LINES U.N.O.
4. SLAB THICKNESS IS 8" TYP. U.N.O.
5. LEVEL 2 ELEVATION = 334'-6"

LEGEND

SYMBOLS

1-BOX (ROUND ENDS)
TOP OF CONCRETE ELEVATIONS

1-BOX
BOTTOM OF CONCRETE ELEVATIONS

2-BOX (PLAN VIEWS)
TOP 1.& BOTTOM ELEVATIONS
= DEPTH OF CONC. MEMBER

2-BOX (SPOTT PLANS)
TOP 1.& BOTTOM ELEVATIONS
HEIGHT ABOVE FINISHED LEVEL
= DEPTH OF CONC. MEMBER

SHADE DESIGNATIONS

BEAM OR DROP CAP

CWU OR COLUMNS

CML WALLS

DELAIR STAIR OR COUSURE POR

GRADE OR SOIL

Y" PT/INSP. SLAB

Z" PT/INSP. SLAB



LINE DESIGNATIONS

----- INDICATES TOP OF SLAB CHANGE OR EDGE OF SLAB
 ----- INDICATES SOFFIT CHANGE
 -CJ- -CJ- INDICATES CONSTRUCTION JOINT
 --- --- INDICATES GRID LINE


SECTION VIEW
 SHEET NUMBER: 1
 REF: 1
 DETAIL NUMBER: 1
 0.0

ELEVATION VIEW
 SHEET NUMBER: 1
 DETAIL NUMBER: 1
 0.0

THIS DRAWING IS FOR THE EXCLUSIVE USE OF MCCLONE CONSTRUCTION COMPANY. ON THE PROJECT ONLY. UTILIZATION OF THIS DRAWING BY OTHER PARTIES WITHOUT THE WRITTEN CONSENT OF MCCLONE CONSTRUCTION COMPANY IS STRICTLY PROHIBITED.

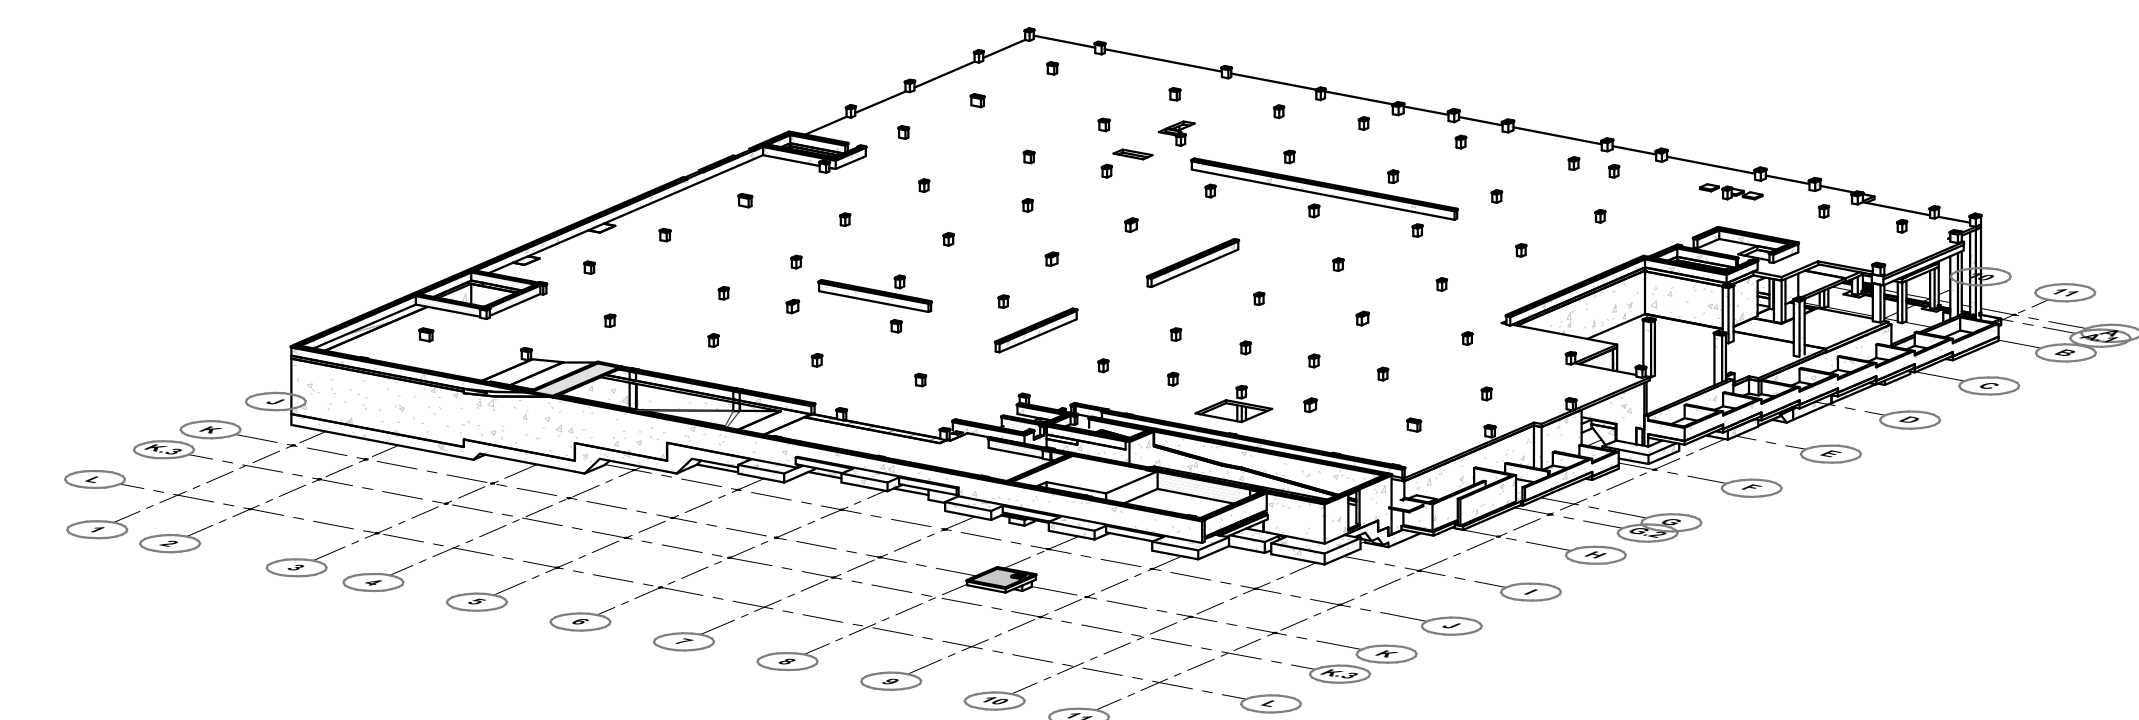
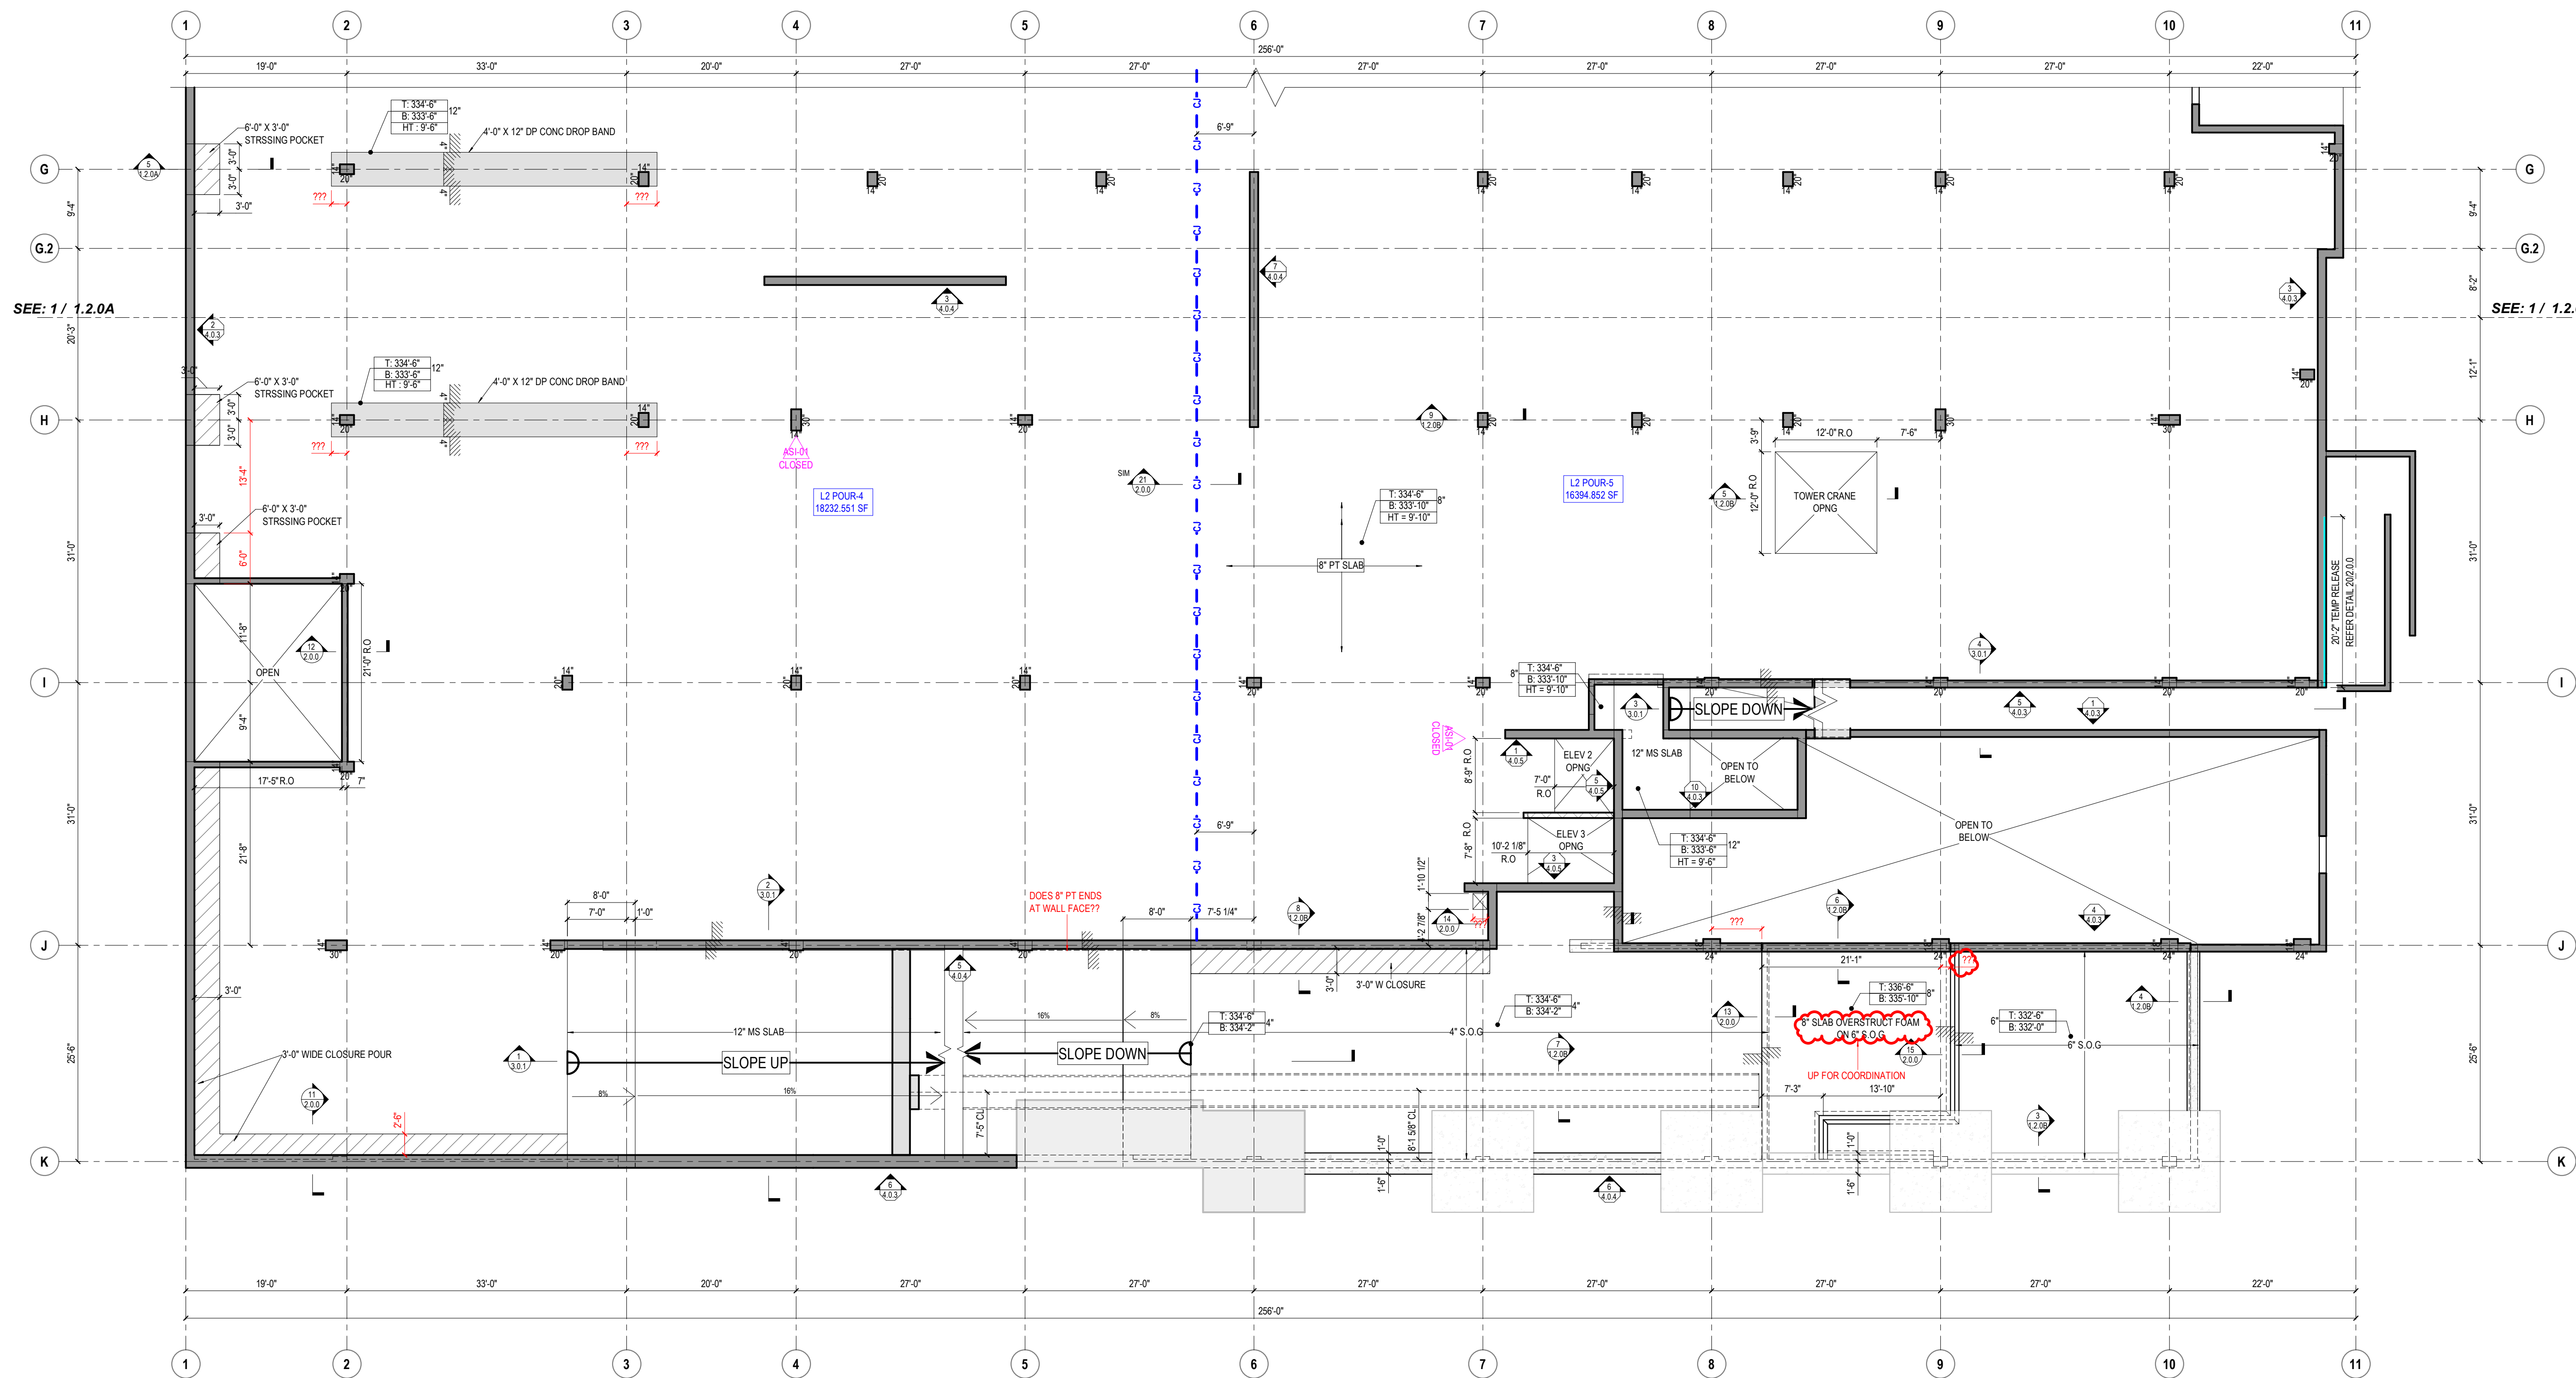


3D VIEW LEVEL-2

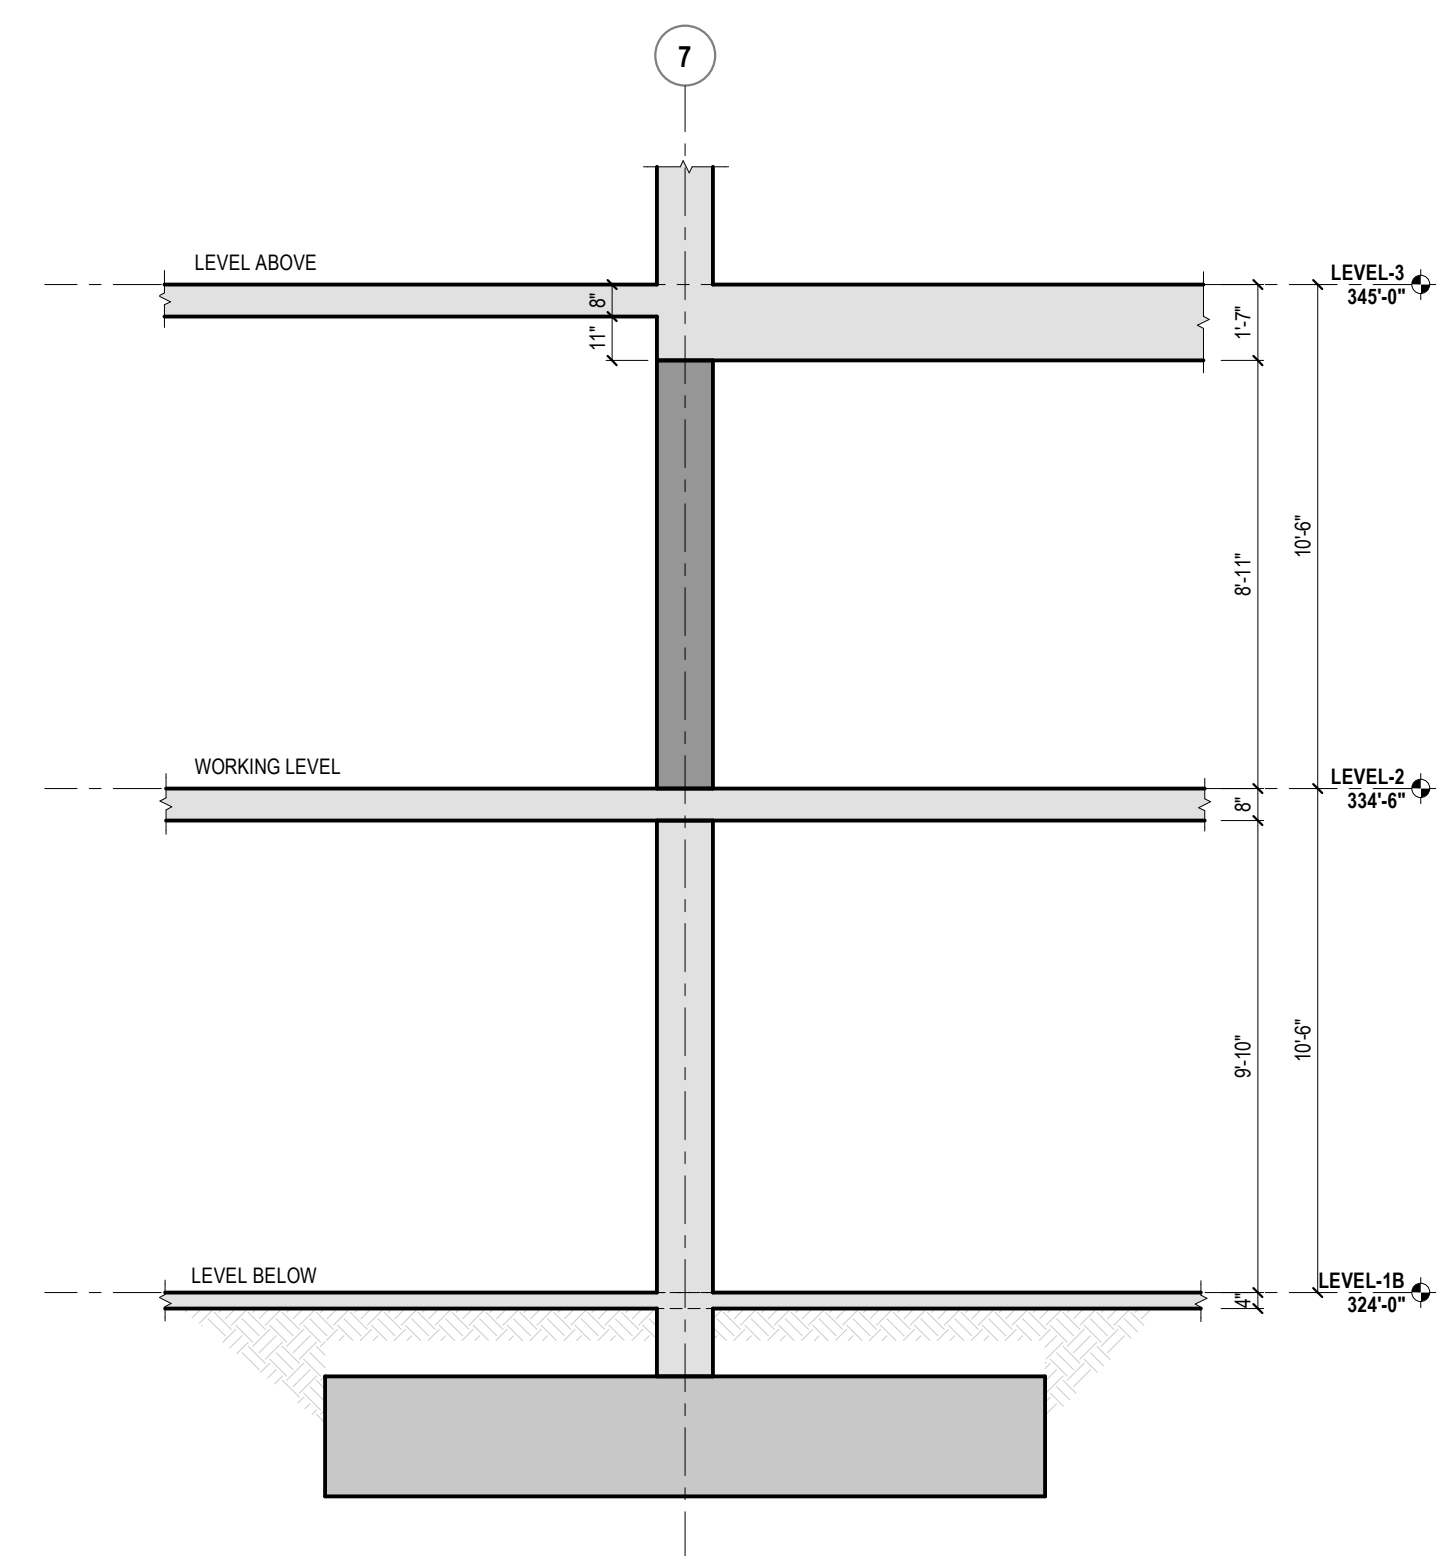

9 BUILDING SECTION LEVEL-2 SOUTH


1 LEVEL-2 (SOFFIT PLAN) - SOUTH

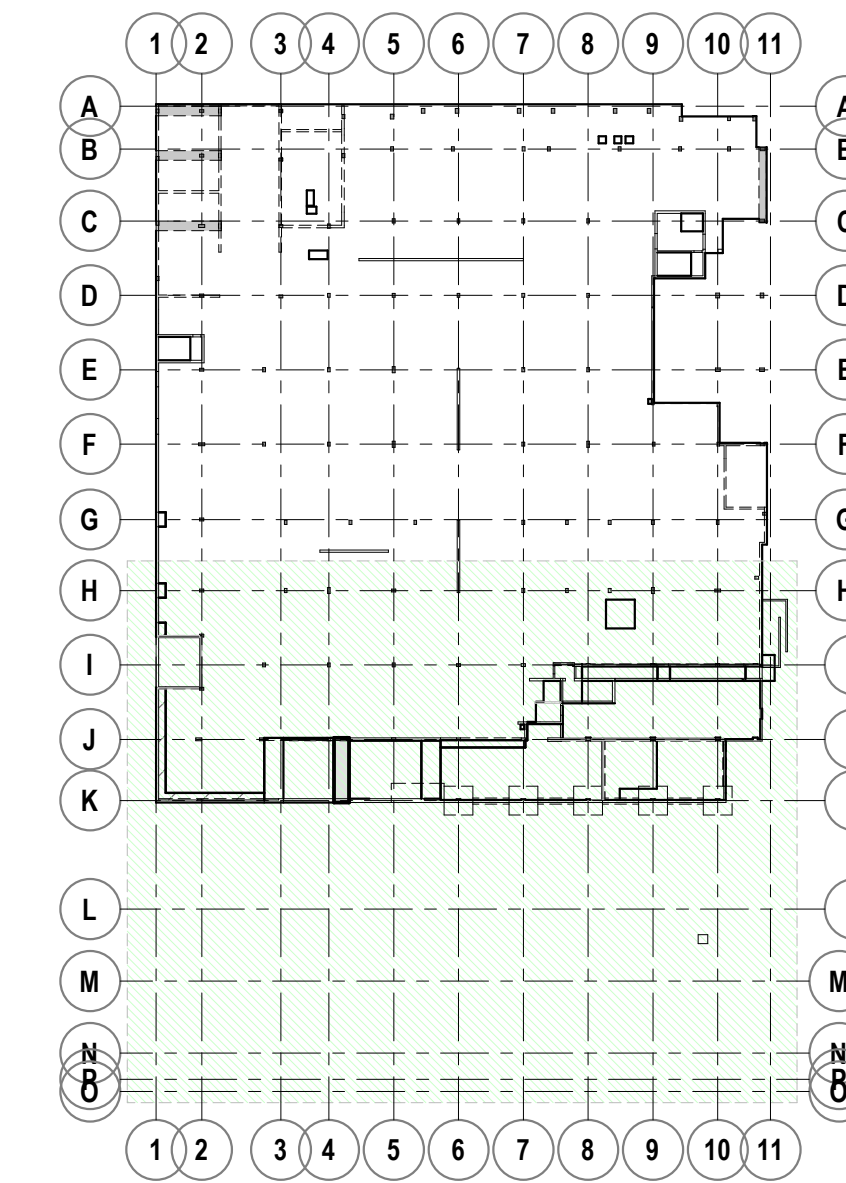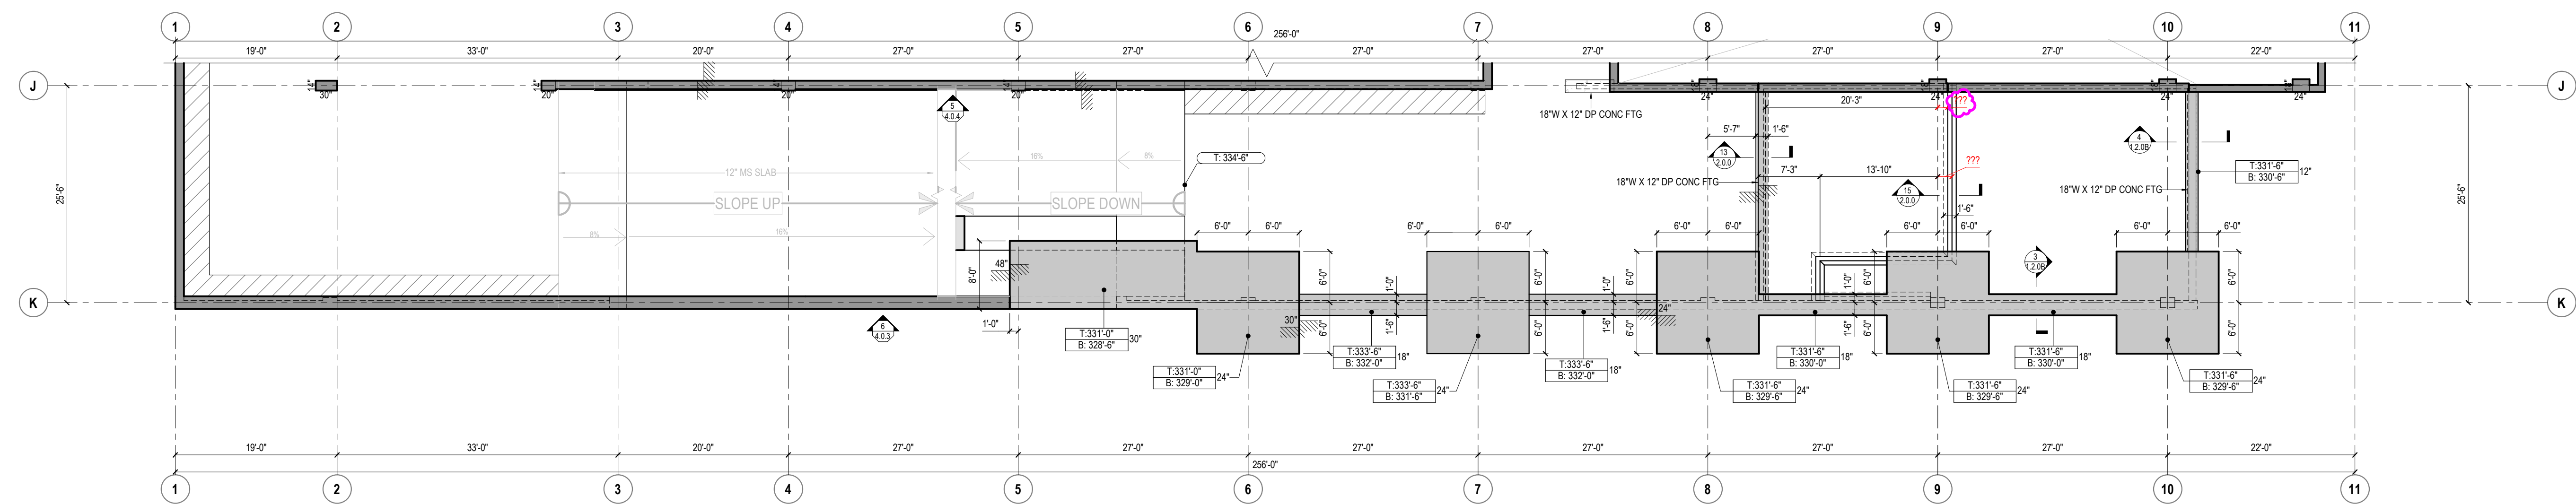

LEVEL-2 KEY PLAN SOUTH

2 LEVEL-2 (SOFFIT PLAN) - SOUTH FOUNDATION

PLEASE PROVIDE / VERIFY THE INFORMATION IN RED

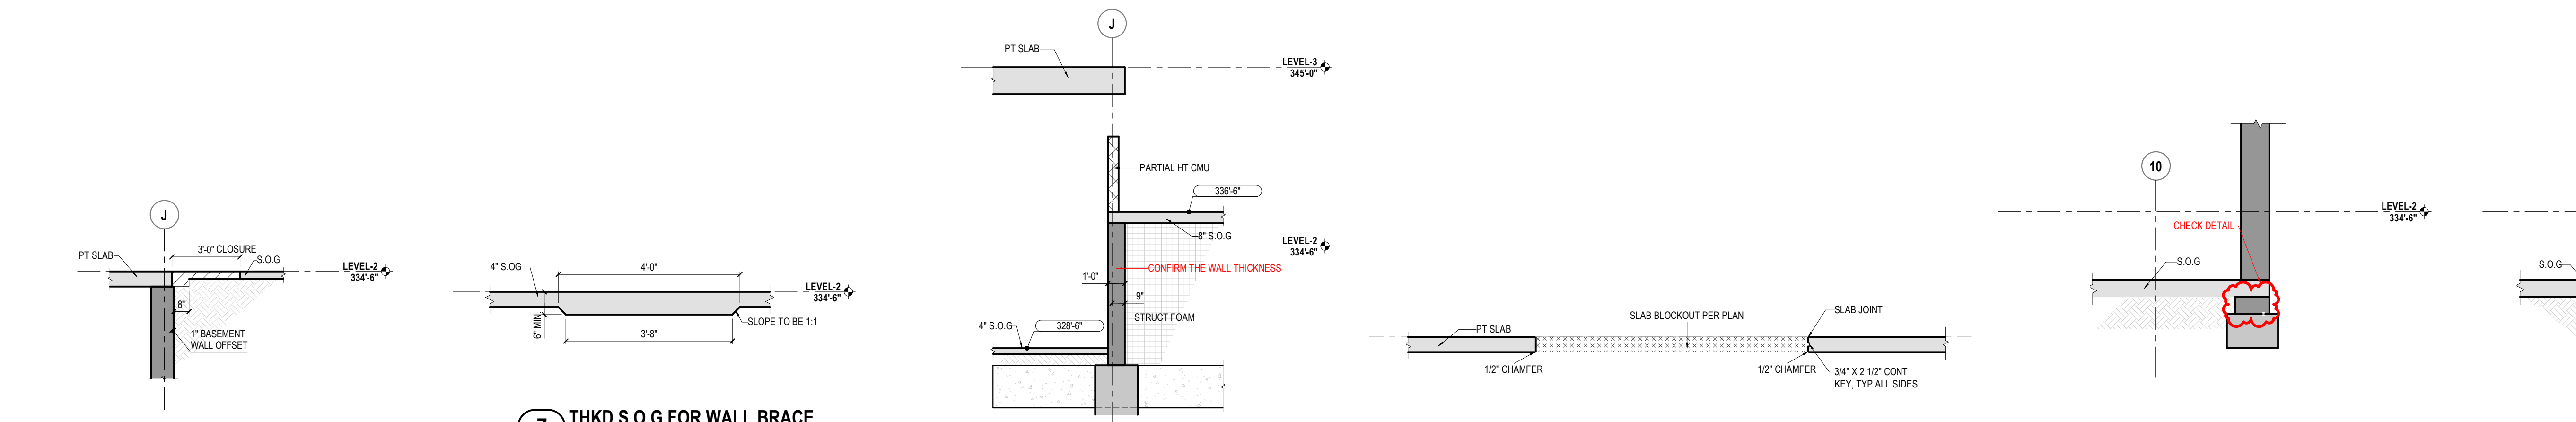

8 TYPICAL CLOSURE DETAIL AT S.O.G.


7 THKD S.O.G FOR WALL BRACE

6 SOG DETAIL AT PARTIAL HT CMU WALL

5 TYP SECTION AT TOWER CRANE BLOCKOUT

4 CONC SLAB AT GARAGE DOOR

3 FOOTING AT PERIMETER WALL

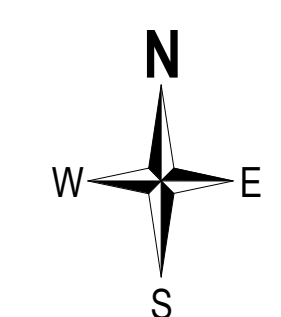

NOTES:


- 3/4" CHAMFER ON ALL EXPOSED CONCRETE CORNERS TYP.
- ALL COLUMNS ARE CENTERED ON GRID LINES U.N.O.
- ALL BEAMS ARE CENTERED ON GRID LINES U.N.O.
- SLAB THICKNESS IS 8" TYP. UNLESS NOTED OTHERWISE.
- LEVEL 2 ELEVATION = 334'-6"

LEGEND

SYMBOLS	SHADE DESIGNATIONS
1-BOX (ROUND ENDS) TOP OF CONCRETE ELEVATIONS	BEAM OR DROP CAP
1-BOX BOTTOM OF CONCRETE ELEVATIONS	WALLS OR COLUMNS
2-BOX (PLAN VIEWS) TOP & BOTTOM ELEVATIONS	CMU WALLS
3-BOX (SOFFIT PLANS) TOP & BOTTOM ELEVATIONS	DELAY STRIP OR CLOSURE POUR
4-BOX (SOFFIT PLANS) TOP & BOTTOM ELEVATIONS	GRADE OR SOIL
5-BOX (SOFFIT PLANS) TOP & BOTTOM ELEVATIONS	Y' PT/MS/CP SLAB
6-BOX (SOFFIT PLANS) TOP & BOTTOM ELEVATIONS	Z' PT/MS/CP SLAB

LINE DESIGNATIONS
--- INDICATES TOP OF SLAB CHANGE OR EDGE OF SLAB
--- INDICATES SOFFIT CHANGE
--- CJ --- INDICATES CONSTRUCTION JOINT
--- INDICATES GRID LINE

THIS DRAWING IS FOR THE EXCLUSIVE USE OF MCCLONE CONSTRUCTION COMPANY. ON THE PROJECT ONLY. UTILIZATION OF THIS DRAWING BY OTHER PARTIES WITHOUT THE EXPRESSED WRITTEN CONSENT OF MCCLONE CONSTRUCTION COMPANY IS STRICTLY PROHIBITED.

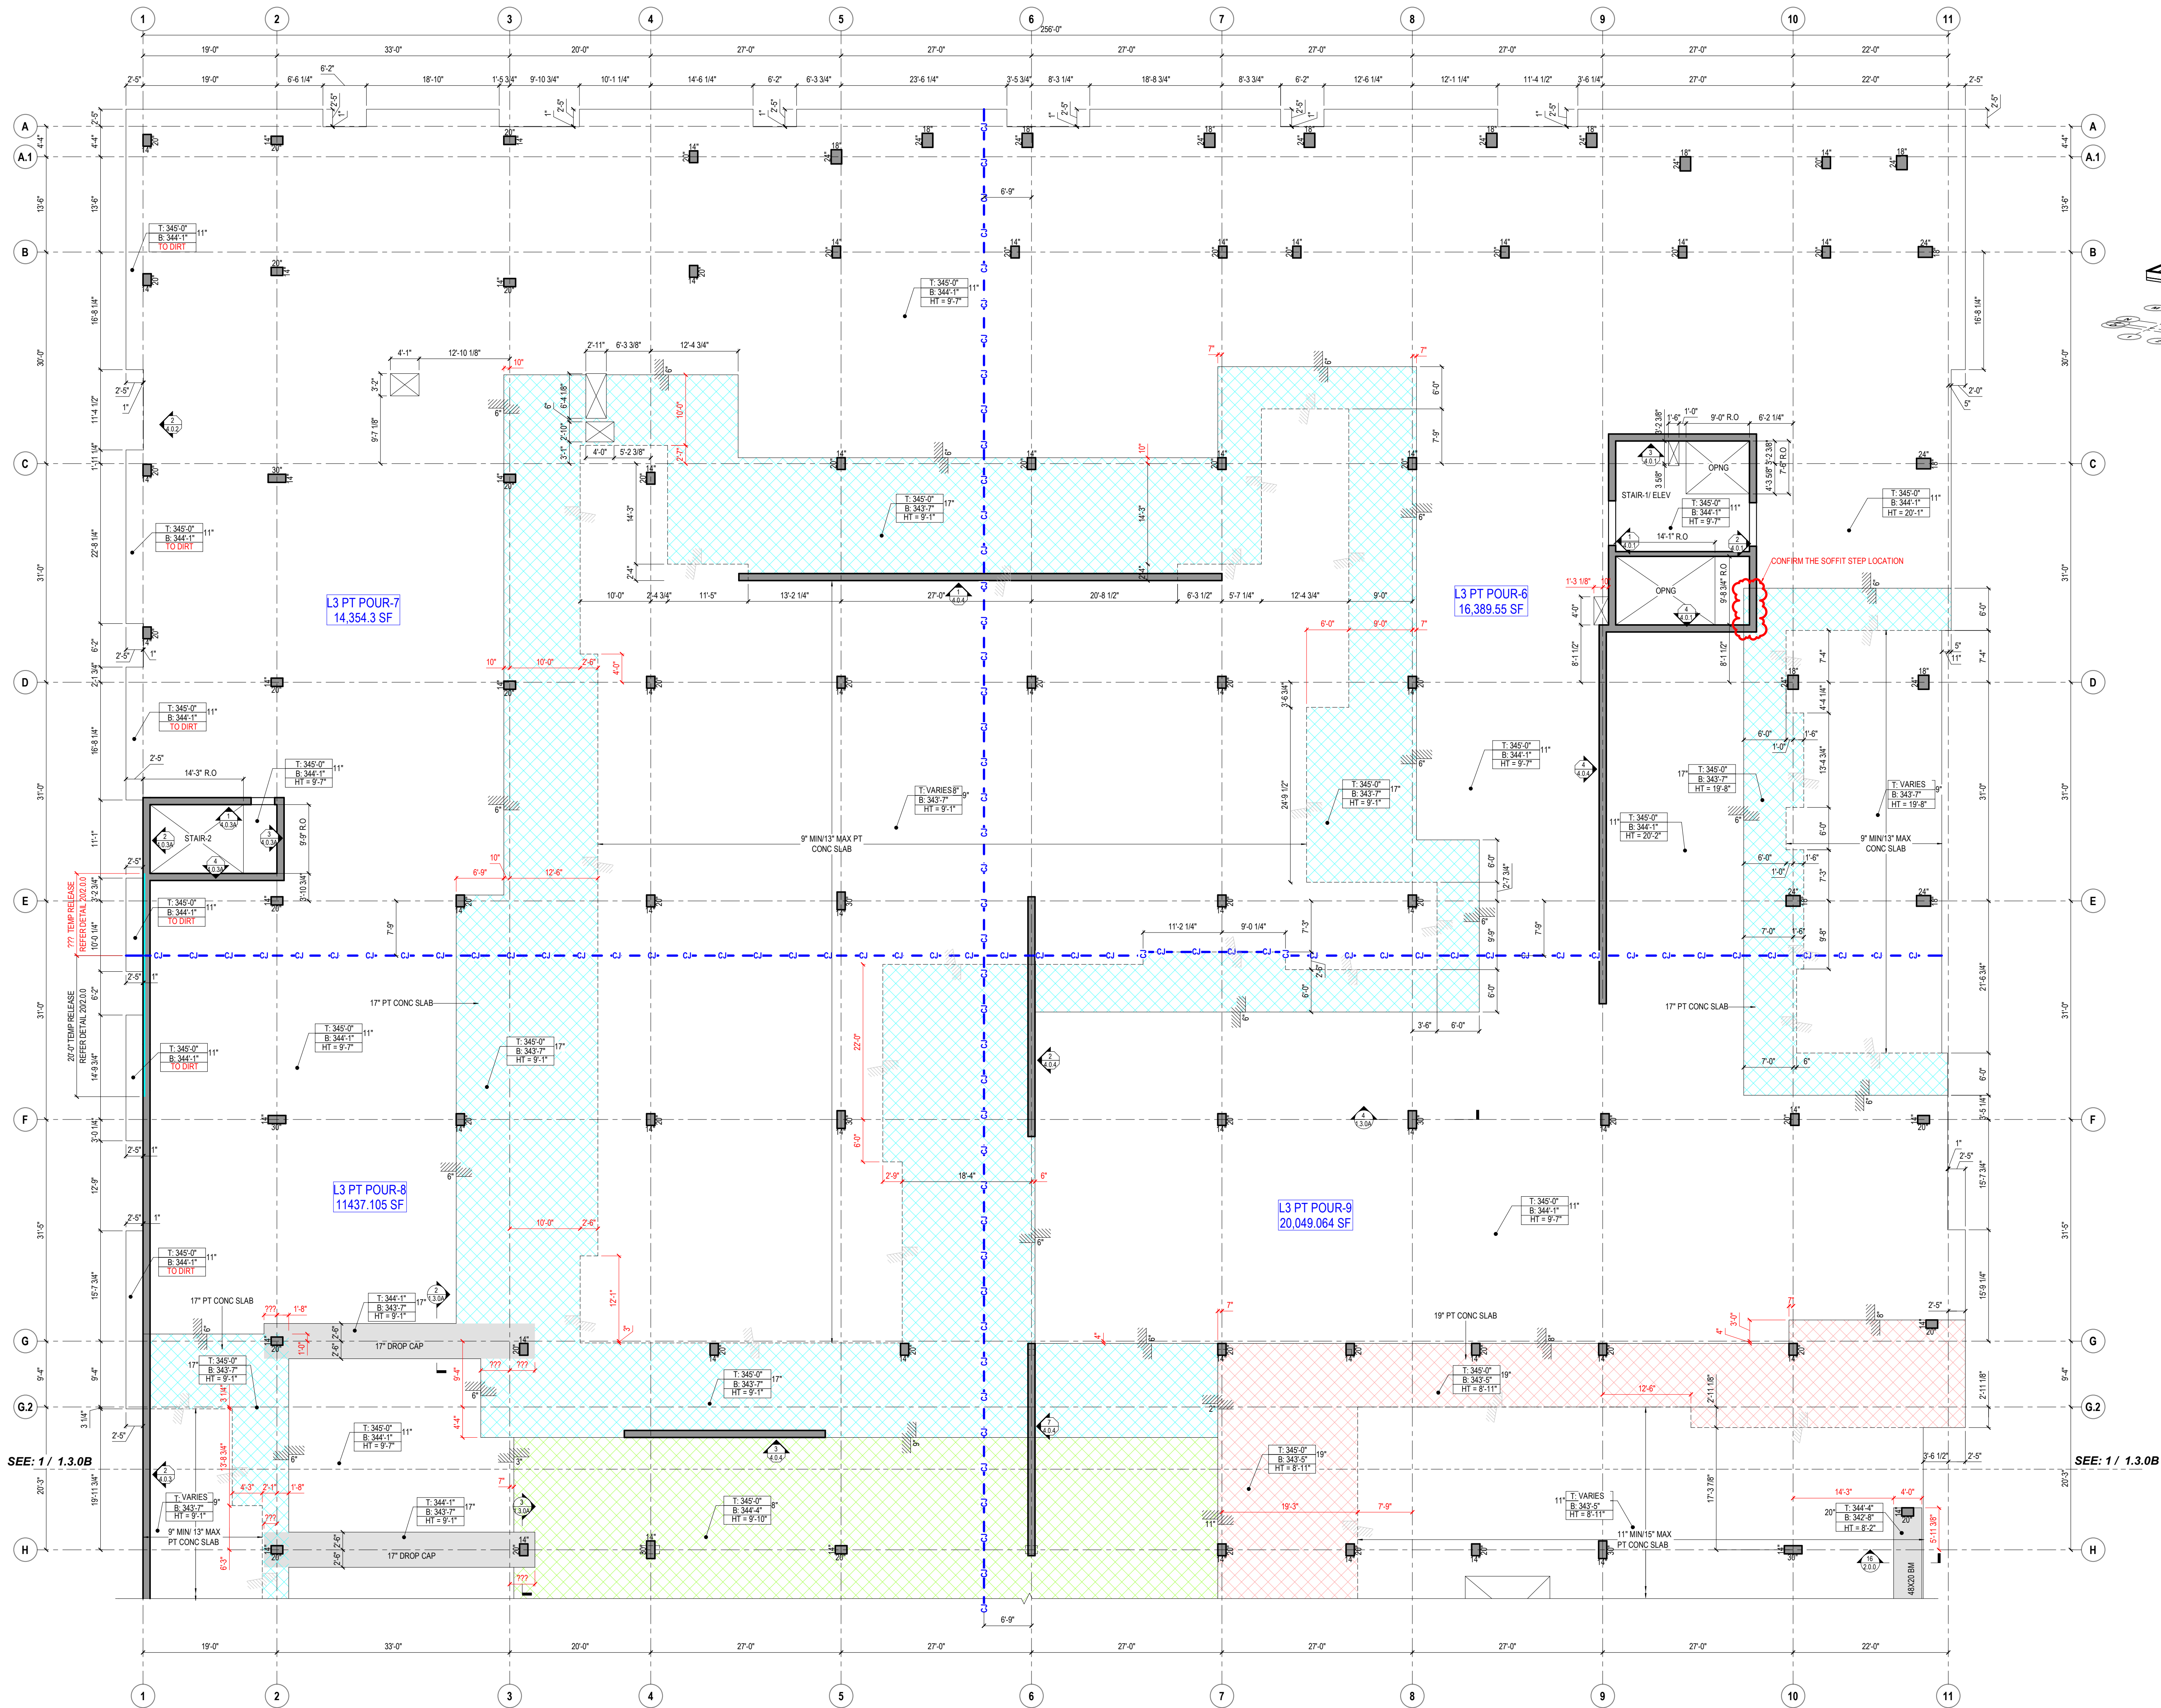


SEE: 1 / 1.3.0B


SEE: 1 / 1.3.0B

1 LEVEL-3 (SOFFIT PLAN) - NORTH


PLEASE PROVIDE / VERIFY THE INFORMATION IN RED

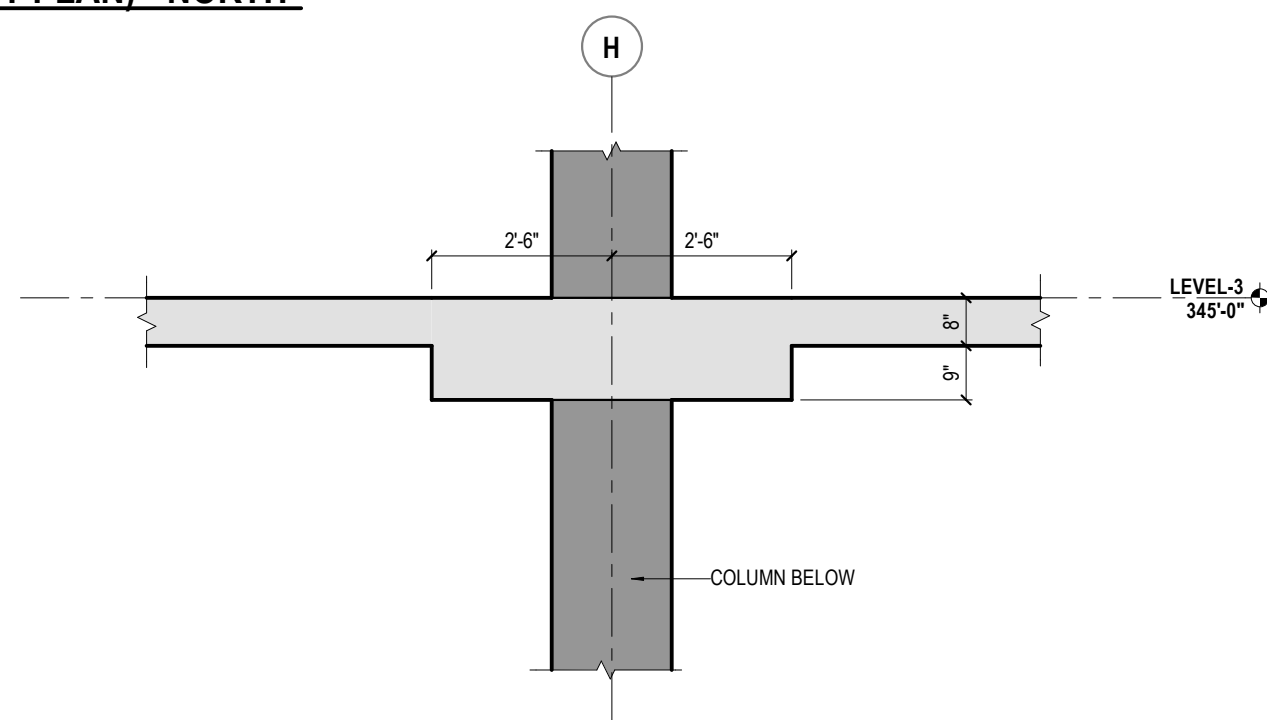


3 SECTION AT DROP CAP SOFFIT STEP

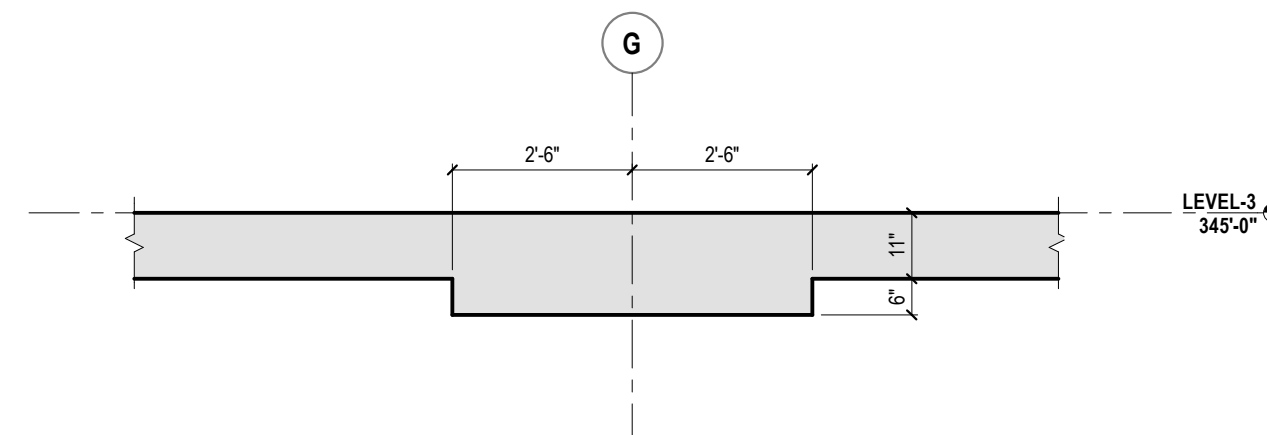


2 SECTION AT DROP CAP

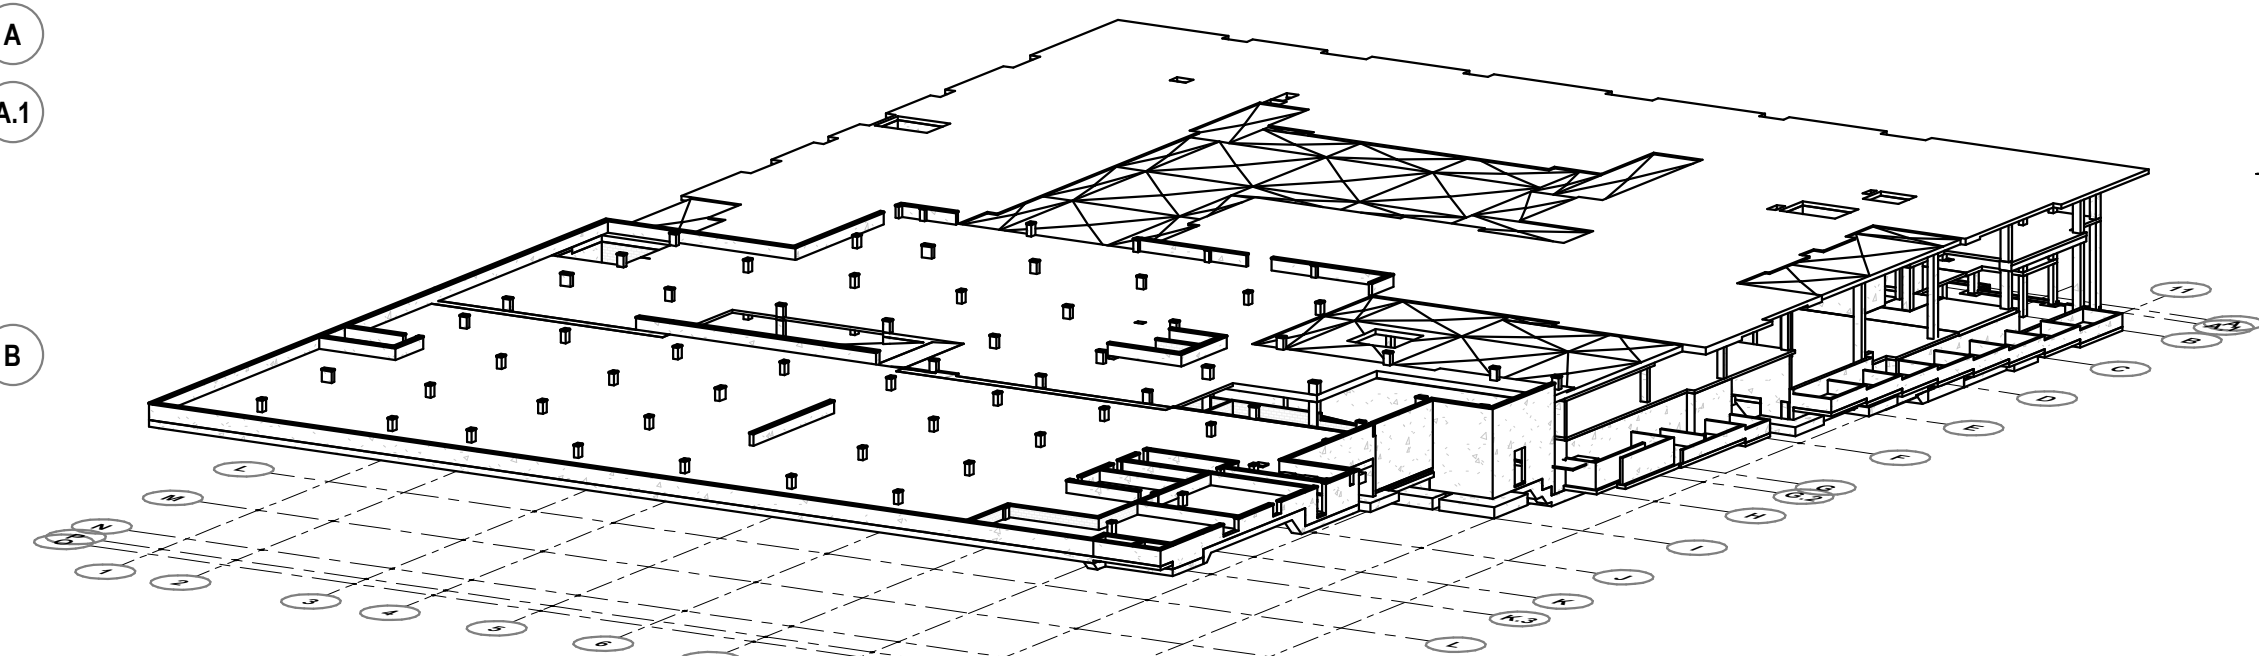


3D VIEW LEVEL-3

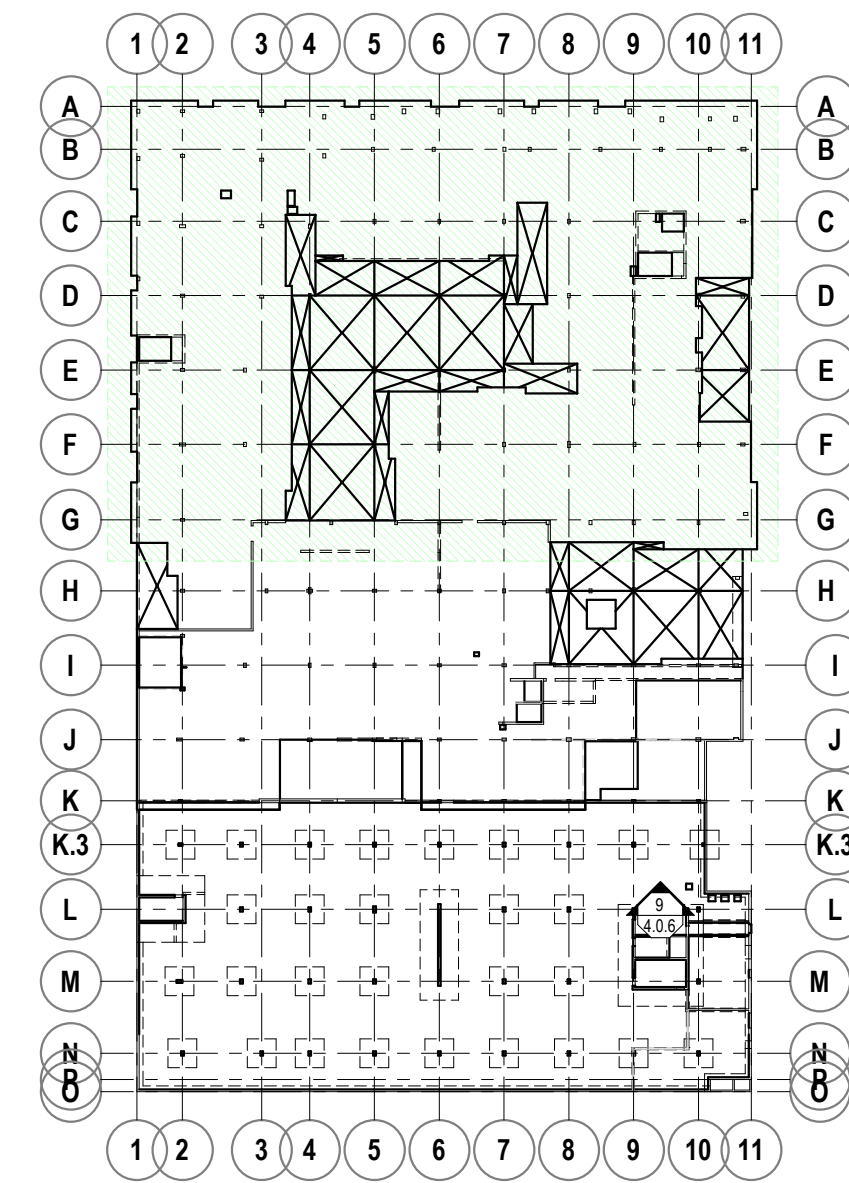

LEVEL-3 KEY PLAN NORTH

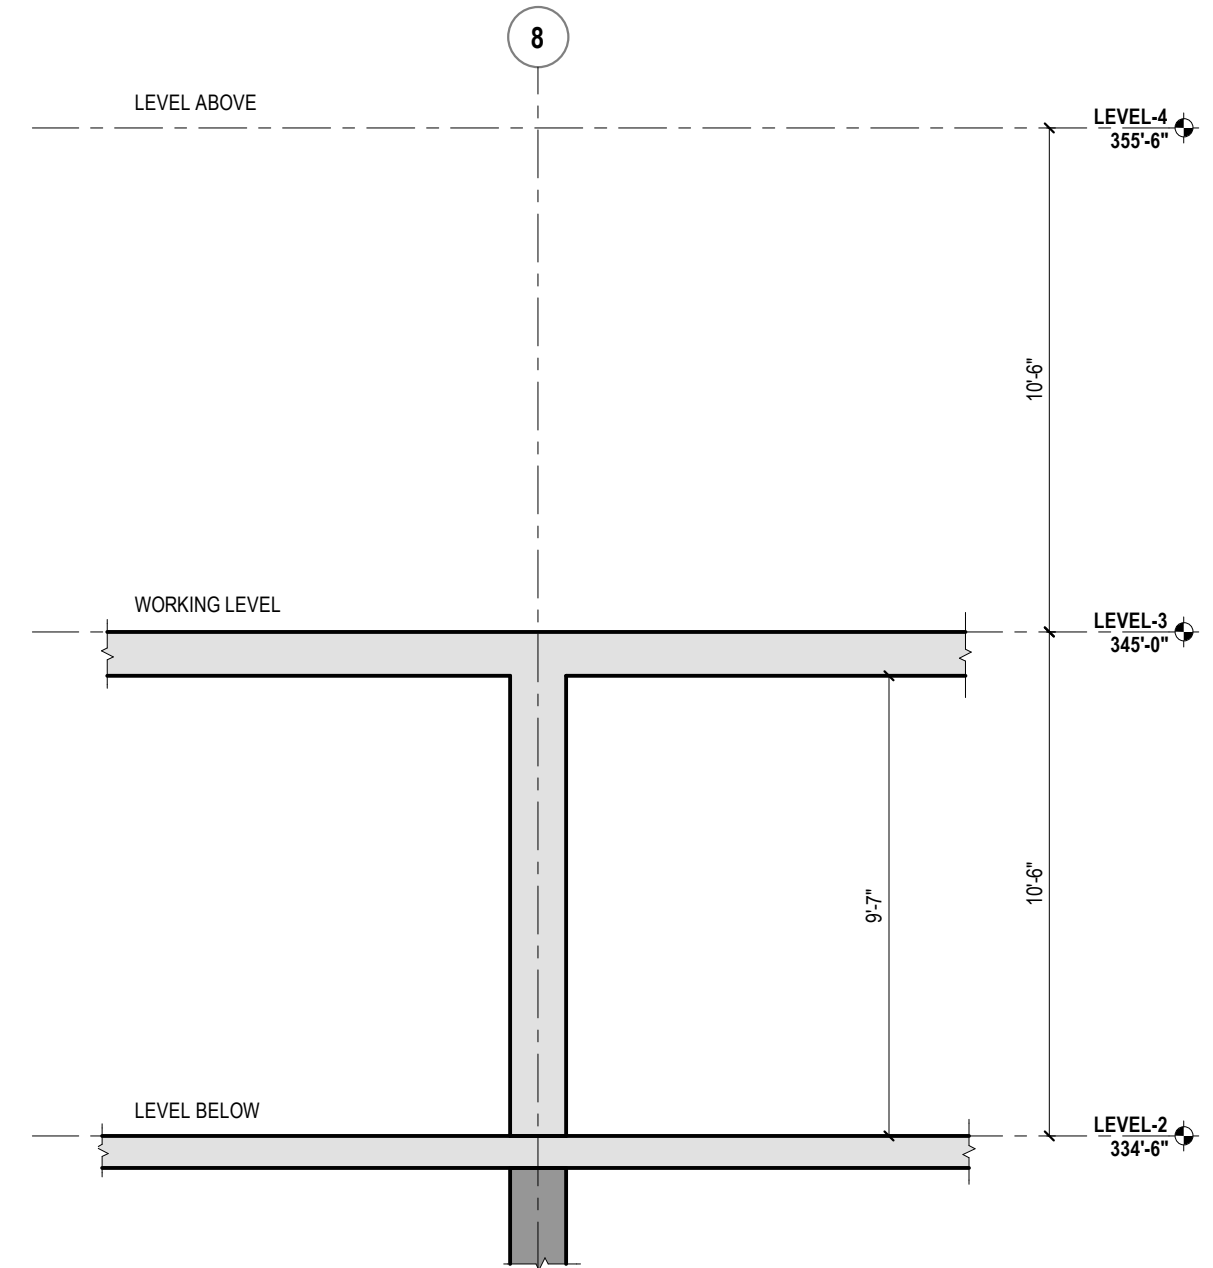

BUILDING SECTION LEVEL-3

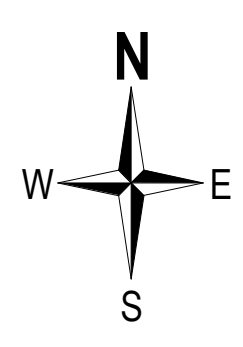


NOTES:


- 3/4" CHAMFER ON ALL EXPOSED CONCRETE CORNERS TYP.
- ALL COLUMNS ARE CENTERED ON GRID LINES U.N.O.
- ALL BEAMS ARE CENTERED ON GRID LINES U.N.O.
- SLAB THICKNESS IS 11" TYP. U.N.O.
- LEVEL 3 ELEVATION = 345'-0"

LEGEND

SYMBOLS		SHAPE DESIGNATIONS	
1-BOX (ROUND ENDS)	TOP OF CONCRETE ELEVATIONS	BEAM OR DROP CAP	
1-BOX	BOTTOM OF CONCRETE ELEVATIONS	WALLS OR COLUMNS	
2-BOX (PLAN VIEWS)	TOP & BOTTOM ELEVATIONS	CHU WALLS	
2-BOX (SOFFIT PLANS)	TOP & BOTTOM ELEVATIONS	DELAY STRIP OR CLOSURE POUR	
2-BOX (SOFFIT PLANS)	TOP & BOTTOM ELEVATIONS	GRADE OR SOIL	
2-BOX (SOFFIT PLANS)	TOP & BOTTOM ELEVATIONS	1" PTMS/CP SLAB	
2-BOX (SOFFIT PLANS)	TOP & BOTTOM ELEVATIONS	2" PTMS/CP SLAB	
2-BOX (SOFFIT PLANS)	TOP & BOTTOM ELEVATIONS	LINE DESIGNATIONS	
2-BOX (SOFFIT PLANS)	TOP & BOTTOM ELEVATIONS	INDICATES TOP OF SLAB CHANGE OR EDGE OF SLAB	
2-BOX (SOFFIT PLANS)	TOP & BOTTOM ELEVATIONS	INDICATES SOFFIT CHANGE	
2-BOX (SOFFIT PLANS)	TOP & BOTTOM ELEVATIONS	INDICATES CONSTRUCTION JOINT	
2-BOX (SOFFIT PLANS)	TOP & BOTTOM ELEVATIONS	INDICATES GRID LINE	

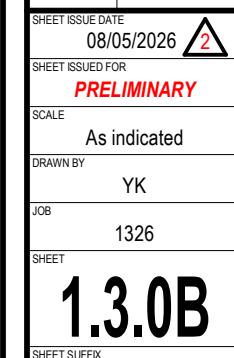


THIS DRAWING IS FOR THE EXCLUSIVE USE OF MCCLONE CONSTRUCTION COMPANY. ON THIS PROJECT ONLY. UTILIZATION OF THIS DRAWING BY OTHER PARTIES AND/OR ON OTHER PROJECTS WITHOUT THE EXPRESSED WRITTEN CONSENT OF MCCLONE CONSTRUCTION COMPANY IS STRICTLY PROHIBITED.

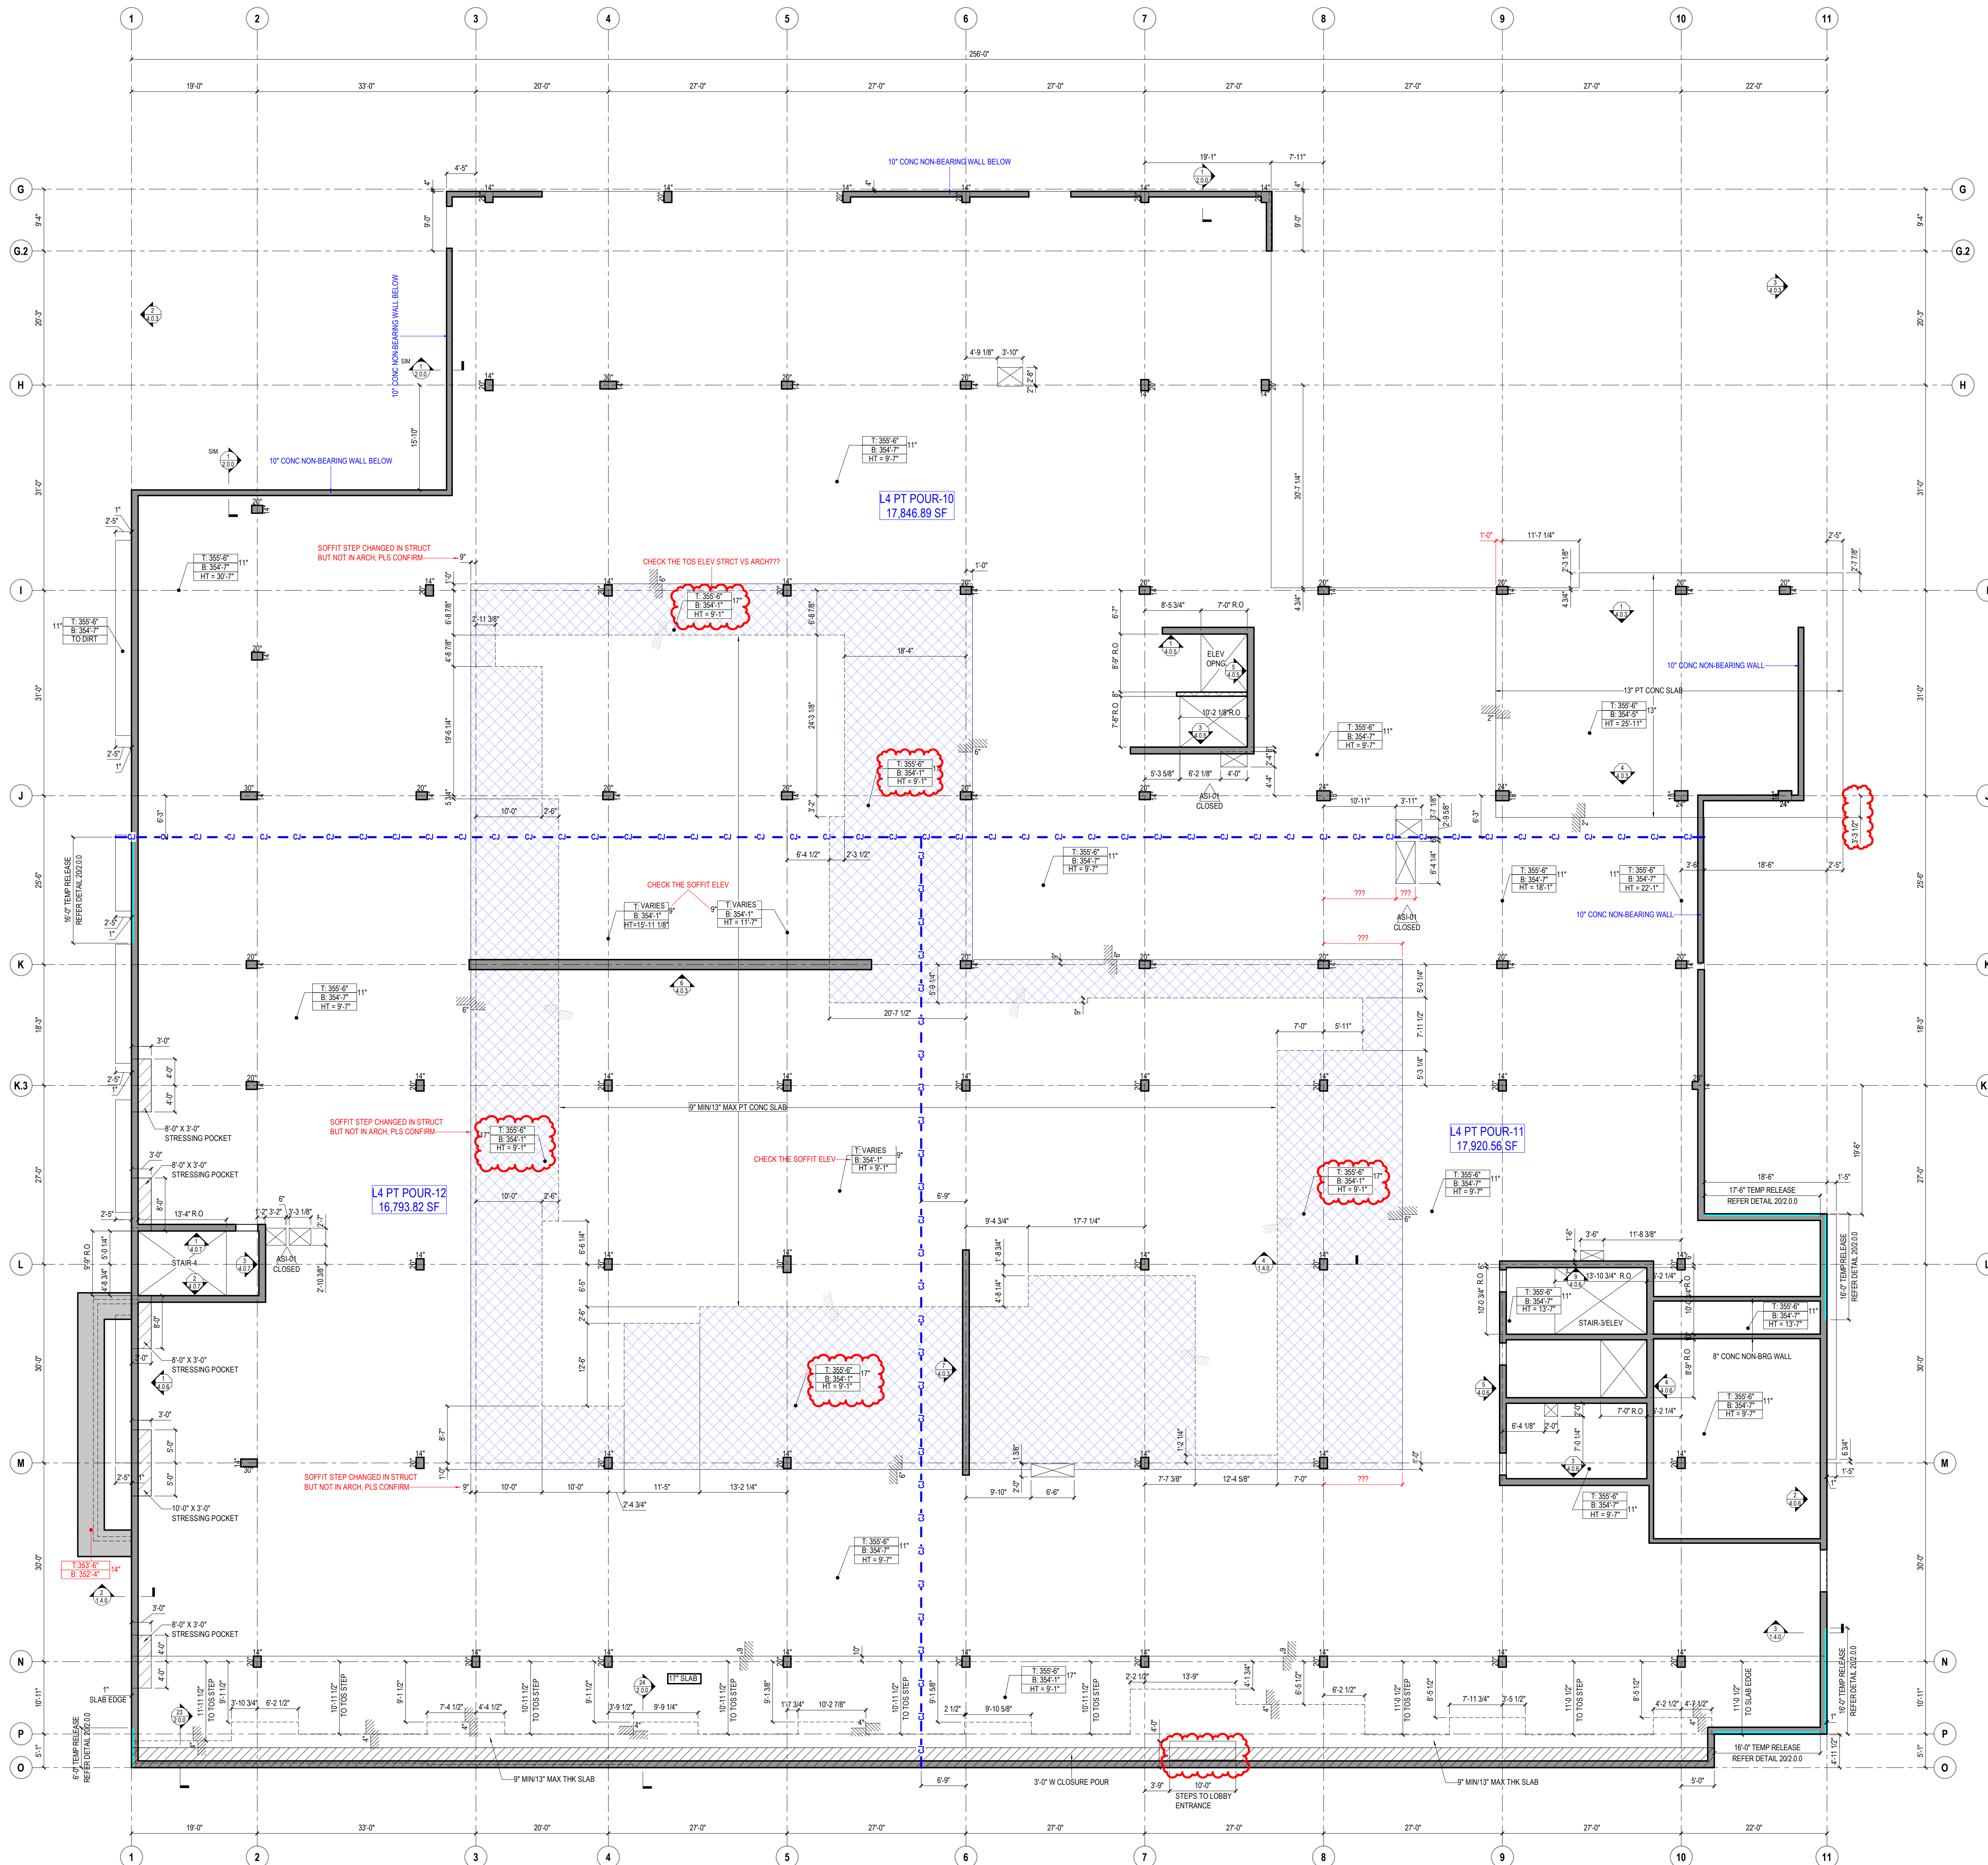


1 LEVEL-4 (SOFFIT PLAN) - SOUTH


PLEASE PROVIDE / VERIFY THE INFORMATION IN RED

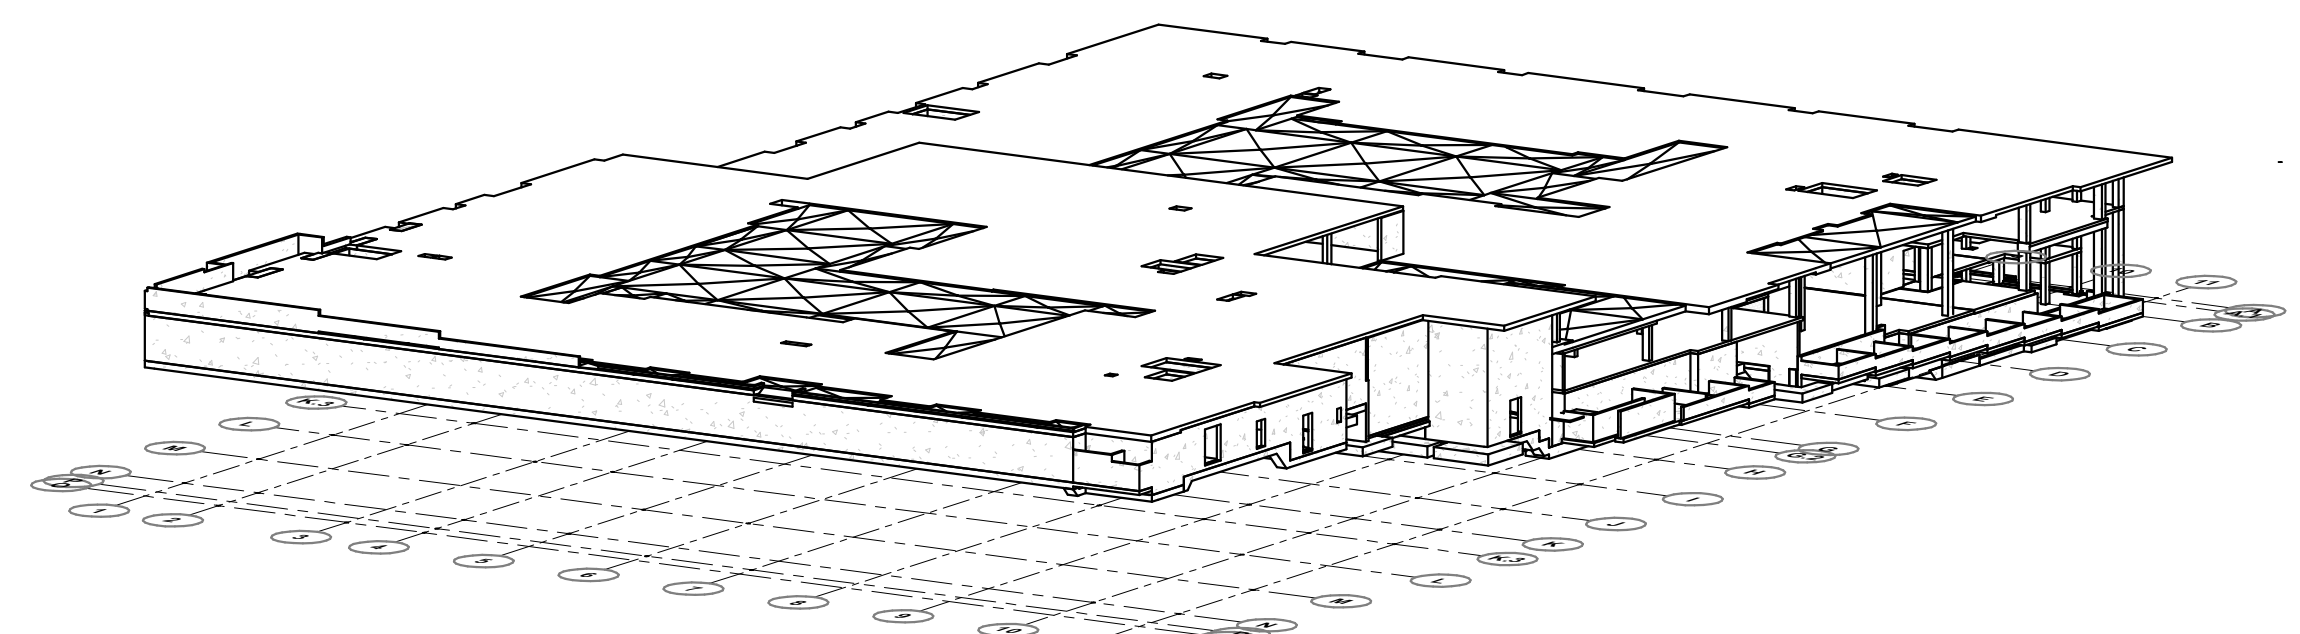


3D VIEW LEVEL-4

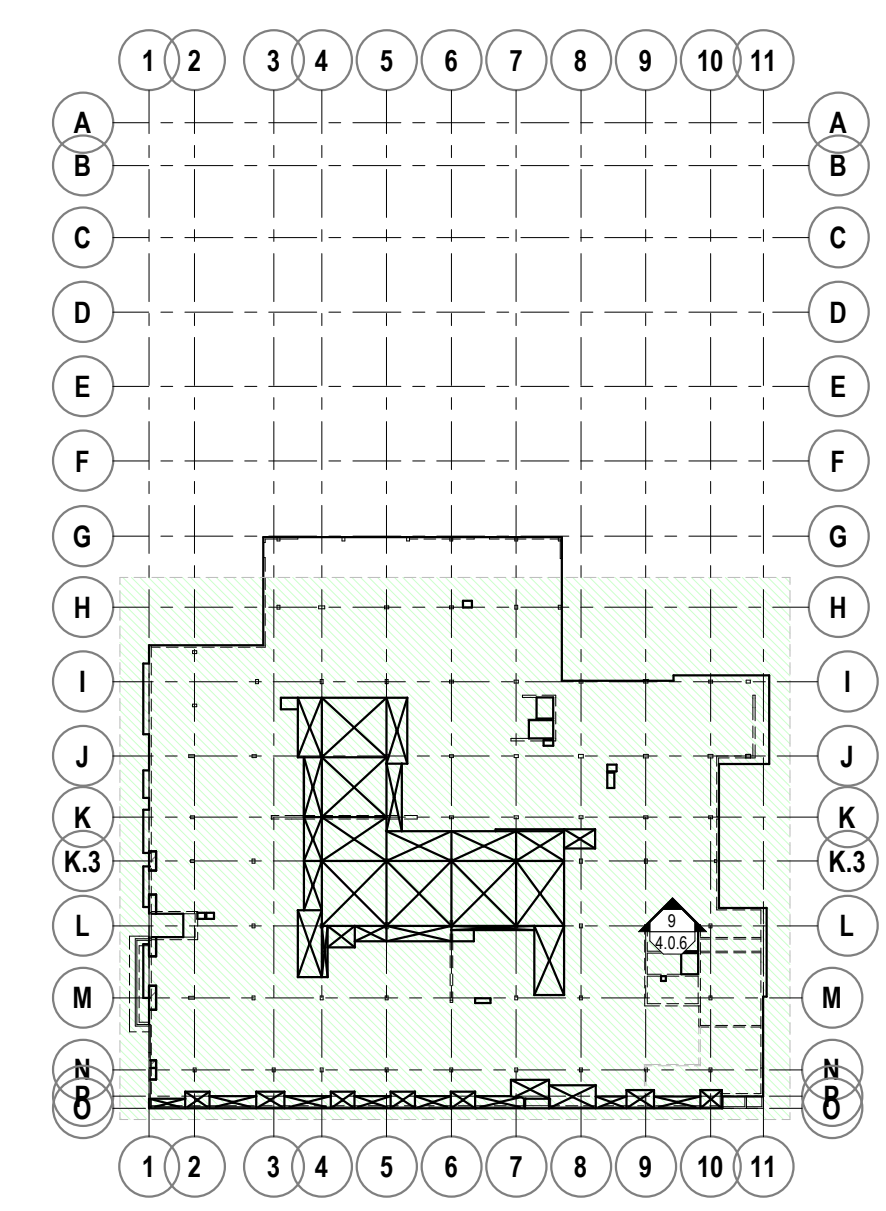

LEVEL-4 KEY PLAN SOUTH

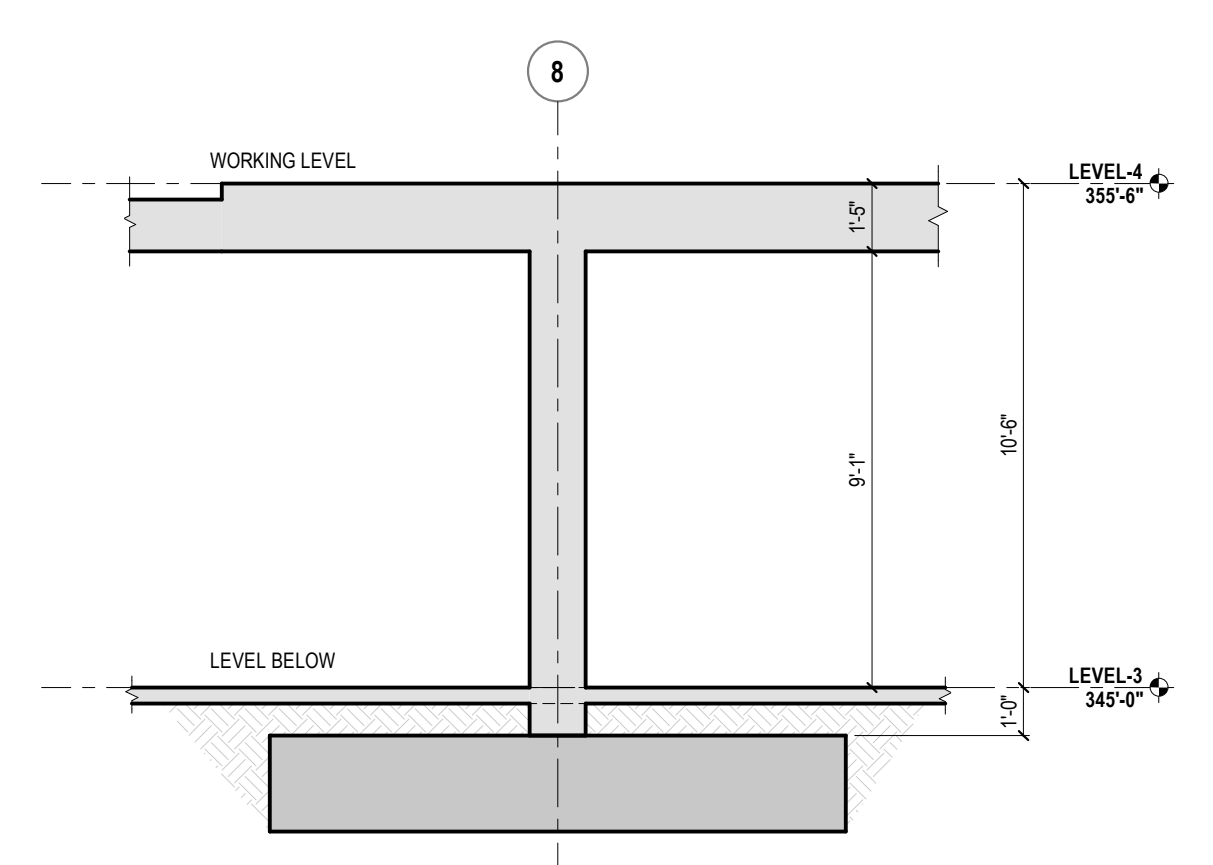

4 BUILDING SECTION LEVEL-4

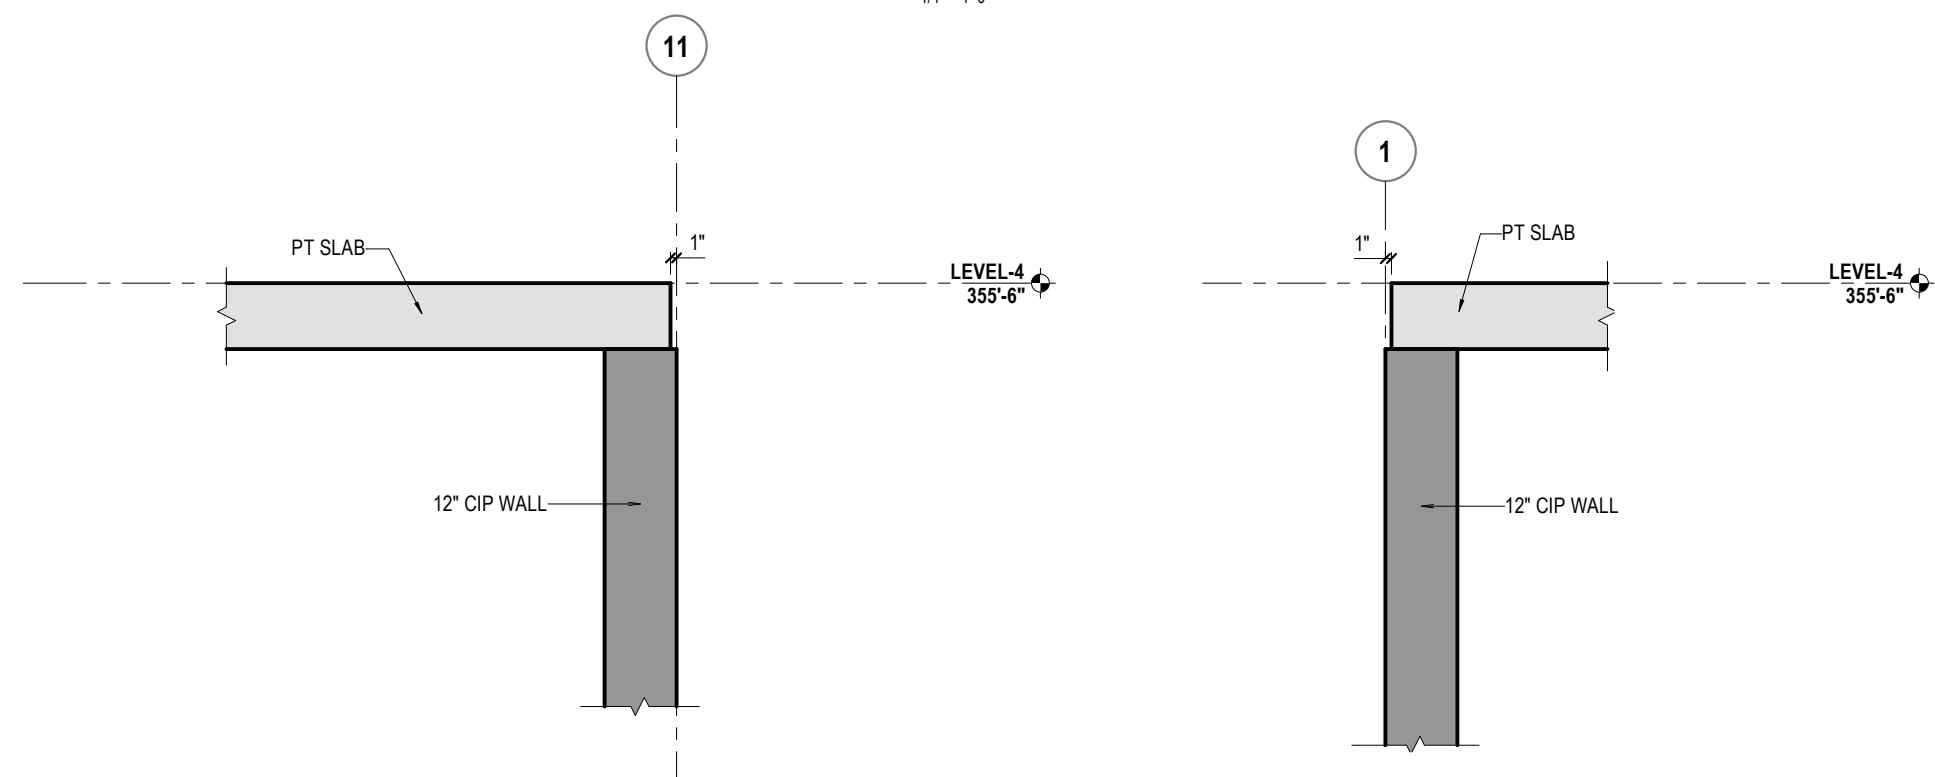

3 SLAB EDGE AT GL-11

2 SECTION AT SLAB EDGE

NOTES:

- 3/4\"/>
- ALL COLUMNS ARE CENTERED ON GRID LINES UNLESS OTHERWISE NOTED.
- ALL BEAMS ARE CENTERED ON GRID LINES UNLESS OTHERWISE NOTED.
- SLAB THICKNESS IS 11\"/>
- LEVEL 3 ELEVATION = 355'-6\"/>

LEGEND

SYMBOLS	SHAPE DESIGNATIONS
1-BLOCK (ROUND ENDS) TOP OF CONCRETE ELEVATIONS	BEAM OR DROP CAP
1-BLOCK BOTTOM OF CONCRETE ELEVATIONS	WALLS OR COLUMNS
2-BLOCK (PLAN VIEWS) TOP & BOTTOM ELEVATIONS	CONCRETE WALLS
2-BLOCK (SOFFIT PLANS) TOP & BOTTOM ELEVATIONS	DELAY STRIP OR CLOSURE POUR
2-BLOCK (SOFFIT PLANS) TOP & BOTTOM ELEVATIONS	GRADE OR SOIL
2-BLOCK (SOFFIT PLANS) TOP & BOTTOM ELEVATIONS	1\"/>
2-BLOCK (SOFFIT PLANS) TOP & BOTTOM ELEVATIONS	2\"/>

SECTION VIEW	ELEVATION VIEW
1-BLOCK (ROUND ENDS) TOP OF CONCRETE ELEVATIONS	1-BLOCK (ROUND ENDS) TOP OF CONCRETE ELEVATIONS
1-BLOCK BOTTOM OF CONCRETE ELEVATIONS	1-BLOCK BOTTOM OF CONCRETE ELEVATIONS
2-BLOCK (PLAN VIEWS) TOP & BOTTOM ELEVATIONS	2-BLOCK (PLAN VIEWS) TOP & BOTTOM ELEVATIONS
2-BLOCK (SOFFIT PLANS) TOP & BOTTOM ELEVATIONS	2-BLOCK (SOFFIT PLANS) TOP & BOTTOM ELEVATIONS
2-BLOCK (SOFFIT PLANS) TOP & BOTTOM ELEVATIONS	2-BLOCK (SOFFIT PLANS) TOP & BOTTOM ELEVATIONS

LINE DESIGNATIONS
--- INDICATES TOP OF SLAB CHANGE OR EDGE OF SLAB
--- INDICATES SOFFIT CHANGE
--- INDICATES CONSTRUCTION JOINT
--- INDICATES GRID LINE

McCLONE
CONSTRUCTION
SINCE 1975
2860 MAPLE VALLEY BLVD. SUITE 200
MAPLE VALLEY, WA 98043-4254

LEVEL-4 (SOFFIT PLAN) - SOUTH
KINETIC @ GRESHAM
1010 NW 12TH ST GRESHAM, OR 97030

DATE: 08/05/2025
DRAWN BY: YK
CHECKED BY: 1326
SCALE: 1/4\"/>